


T. 26 S., R. 6 W., W. M.

DOUGLAS COUNTY

Scale: 1" = 500'

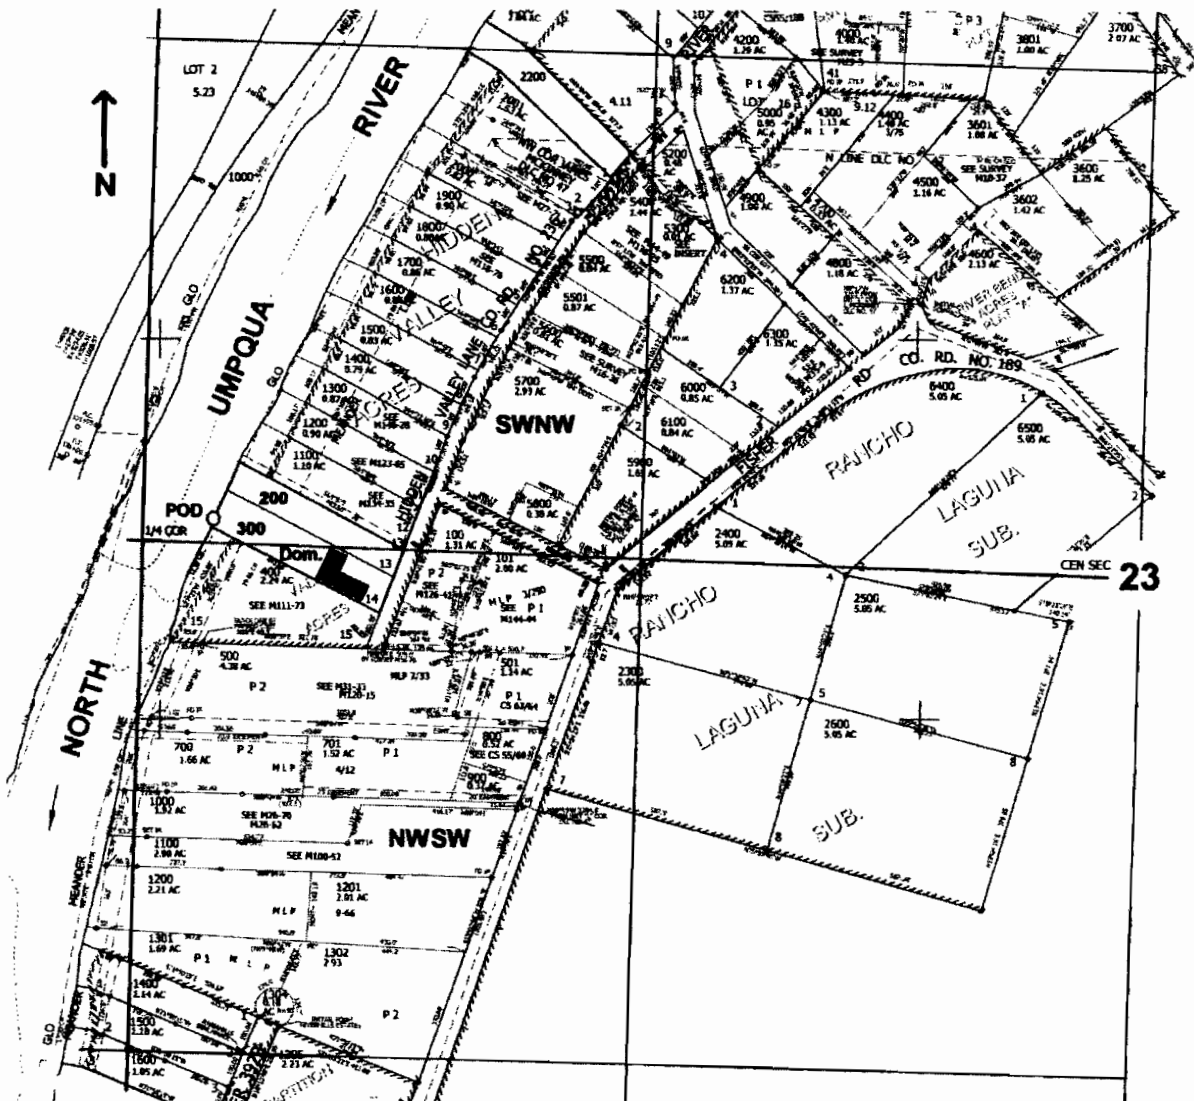

POD is located 60 ft. N. and 180 ft. E. from the W1/4 corner of Sec. 23

app # S86318

RECEIVED
MAY 24 2005
WATER RESOURCES DEPT
SALEM, OREGON