


NW1/4 SEC. 19 T.26S. R.4 W W.M.  
DOUGLAS COUNTY  
Scale: 1" = 500'

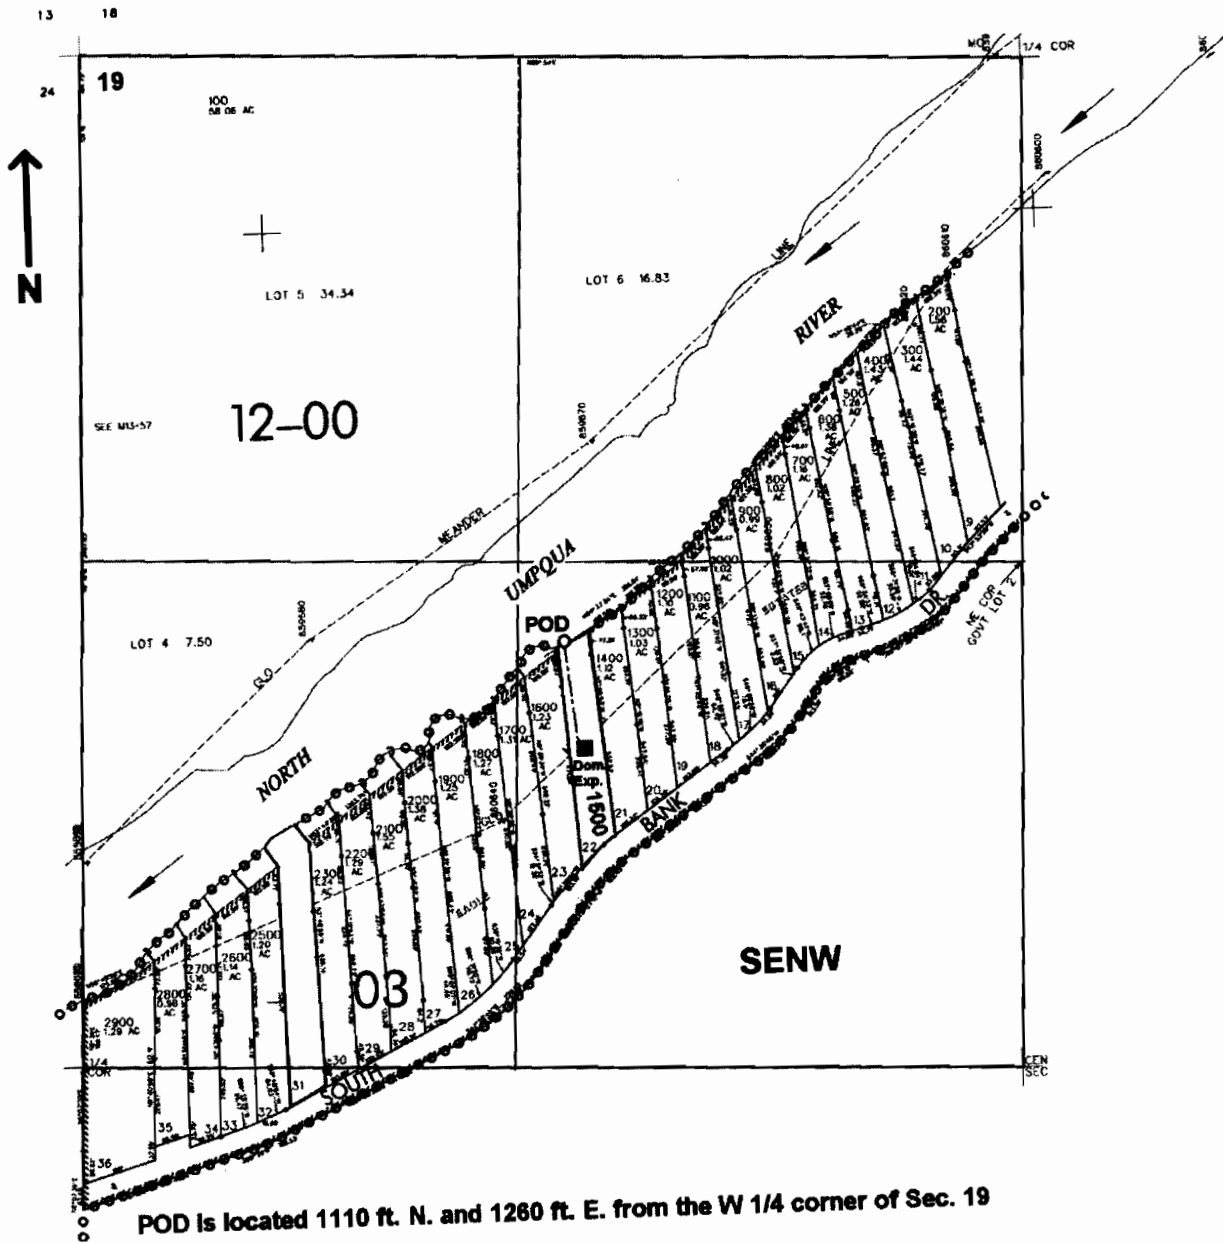

Appl. # S-86284

**RECEIVED**  
MAY - 2 2005  
WATER RESOURCES DEPT  
SALEM, OREGON