


T. 30 S., R. 15 W., W.M.

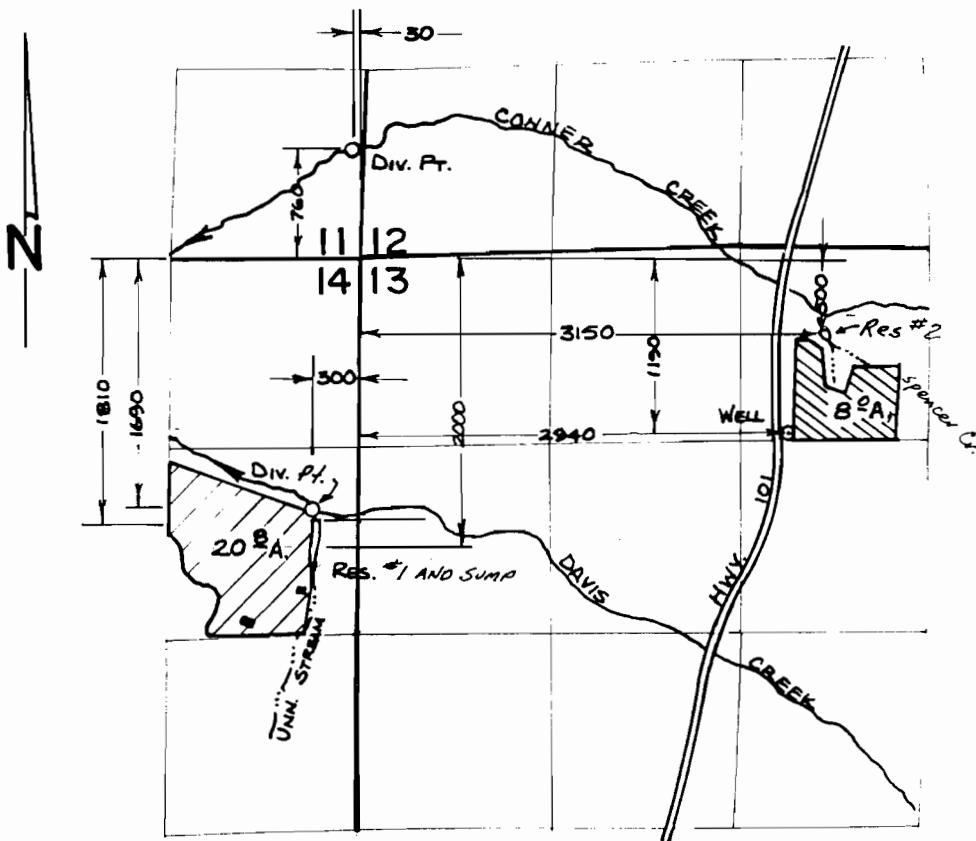

SCALE : 4" = 1 MILE

FINAL PROOF SURVEY UNDER

G- 9494
 R- 59563
 59564
 61757
 G- 11296
 R- 68151
 68023
 Application No. 68354 Permit No. 49345
 IN NAME OF

R- 9088
 R- 8204
 45328
 46101
 G 10489
 R 10479
 49345
 49429



Sump
 Reservoir
 Unn. Stream & Reservoir
 Davis Creek
 Well
 Spencer Creek Reservoir
 Spencer Cr. & Res.
 Conner Creek

.....HARRY G. SPENCER.....

Surveyed 7/26 & 28, 19.88, by J.M. SCHMORDE.