



NW1/4 SEC. 17 T. 26S. R. 4 W. W.M.  
DOUGLAS COUNTY  
Scale: 1" = 500'

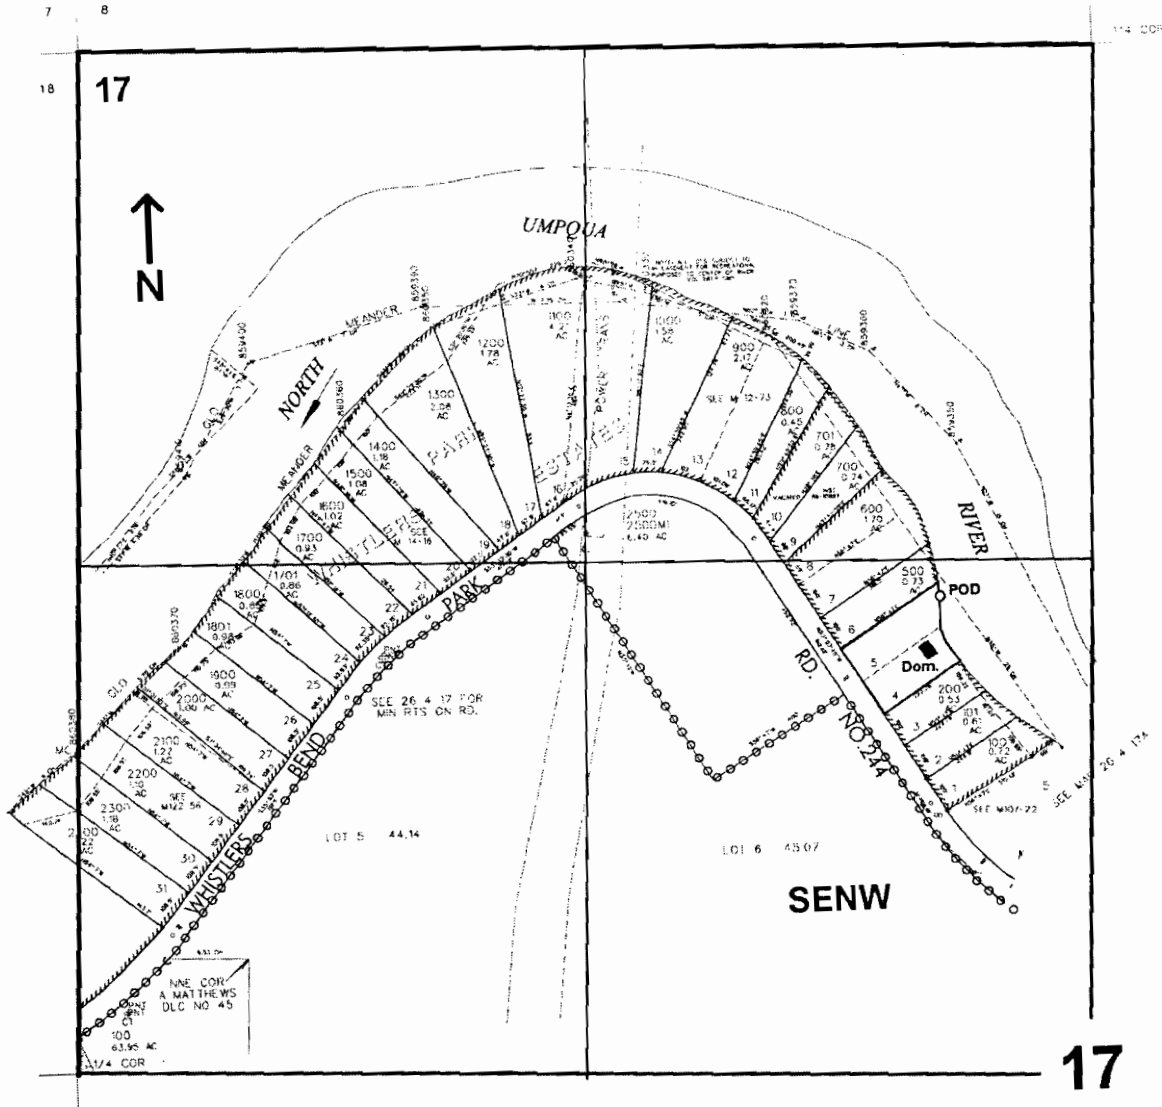

POD is located 1250 ft. N. and 390 ft. W. from the center of Sec. 17

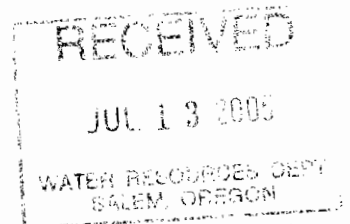

app no S-86377  
Permit no