SW1/4 SEC. 23 T.26S. R. 5W W.M.

DOUGLAS COUNTY

Scale: 1" = 500'

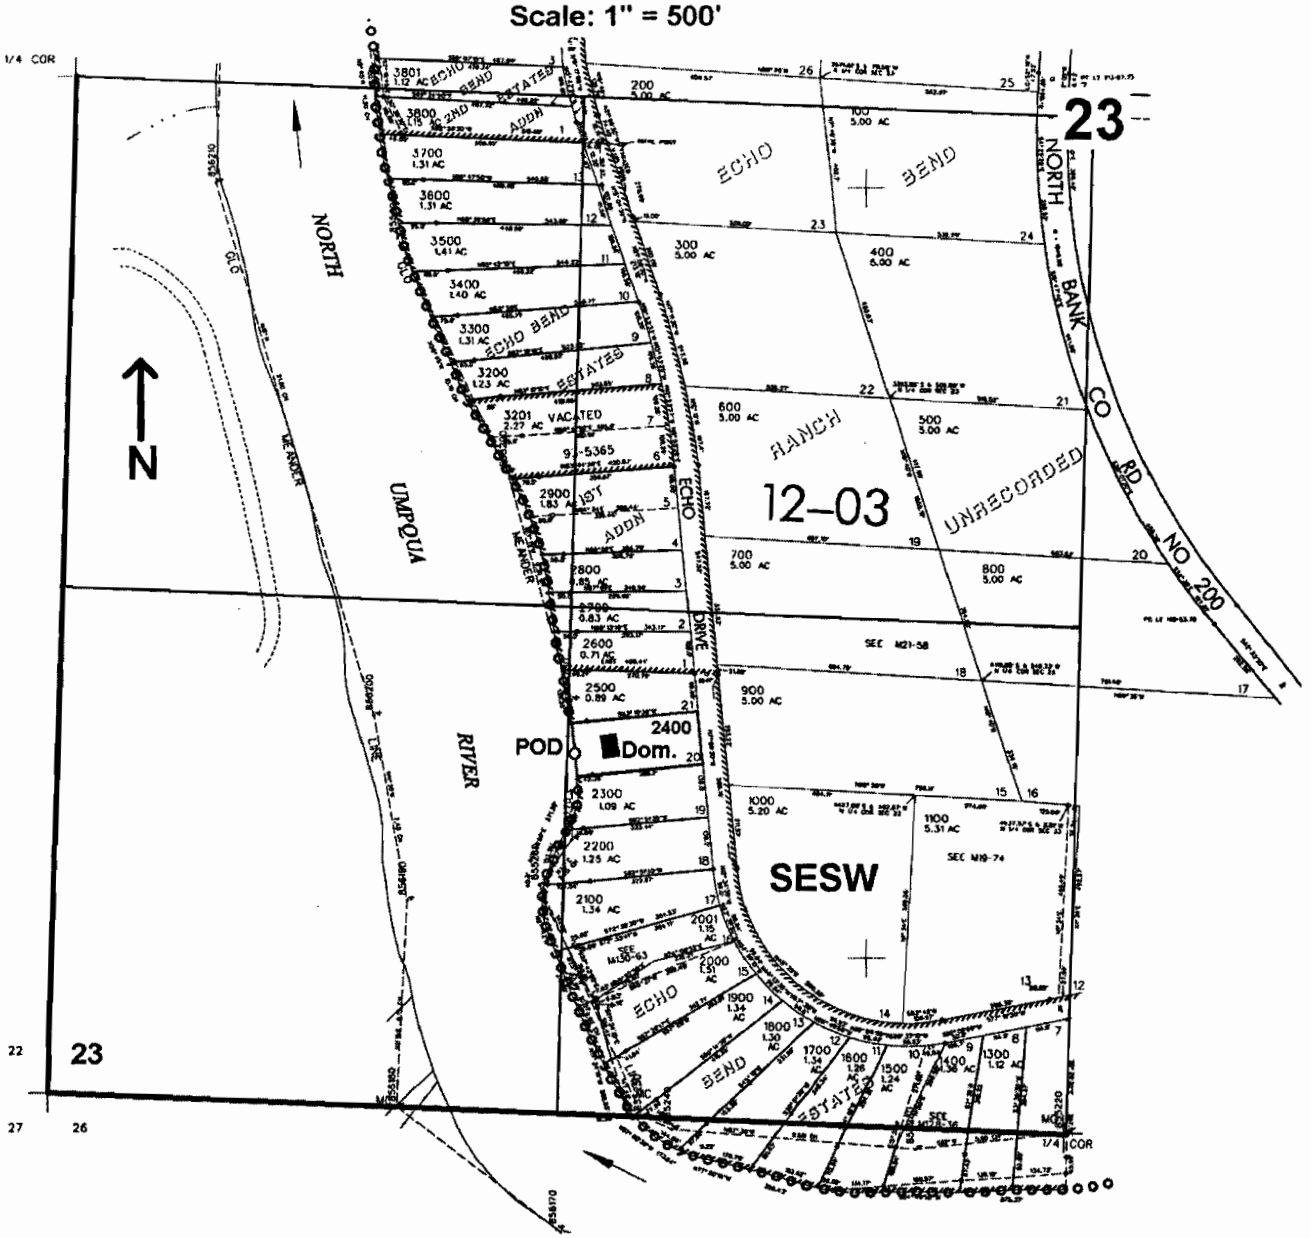

POD is located 940 ft. N and 1300 ft. W. from the S1/4 corner of Sec. 23

app # S 86322

RECEIVED

MAY 27 2005

WATER RESOURCES DEPT
SALEM, OREGON