SEC. 19 T.26S. R.5 W W.M.
DOUGLAS COUNTY
Scale: 1" = 250'

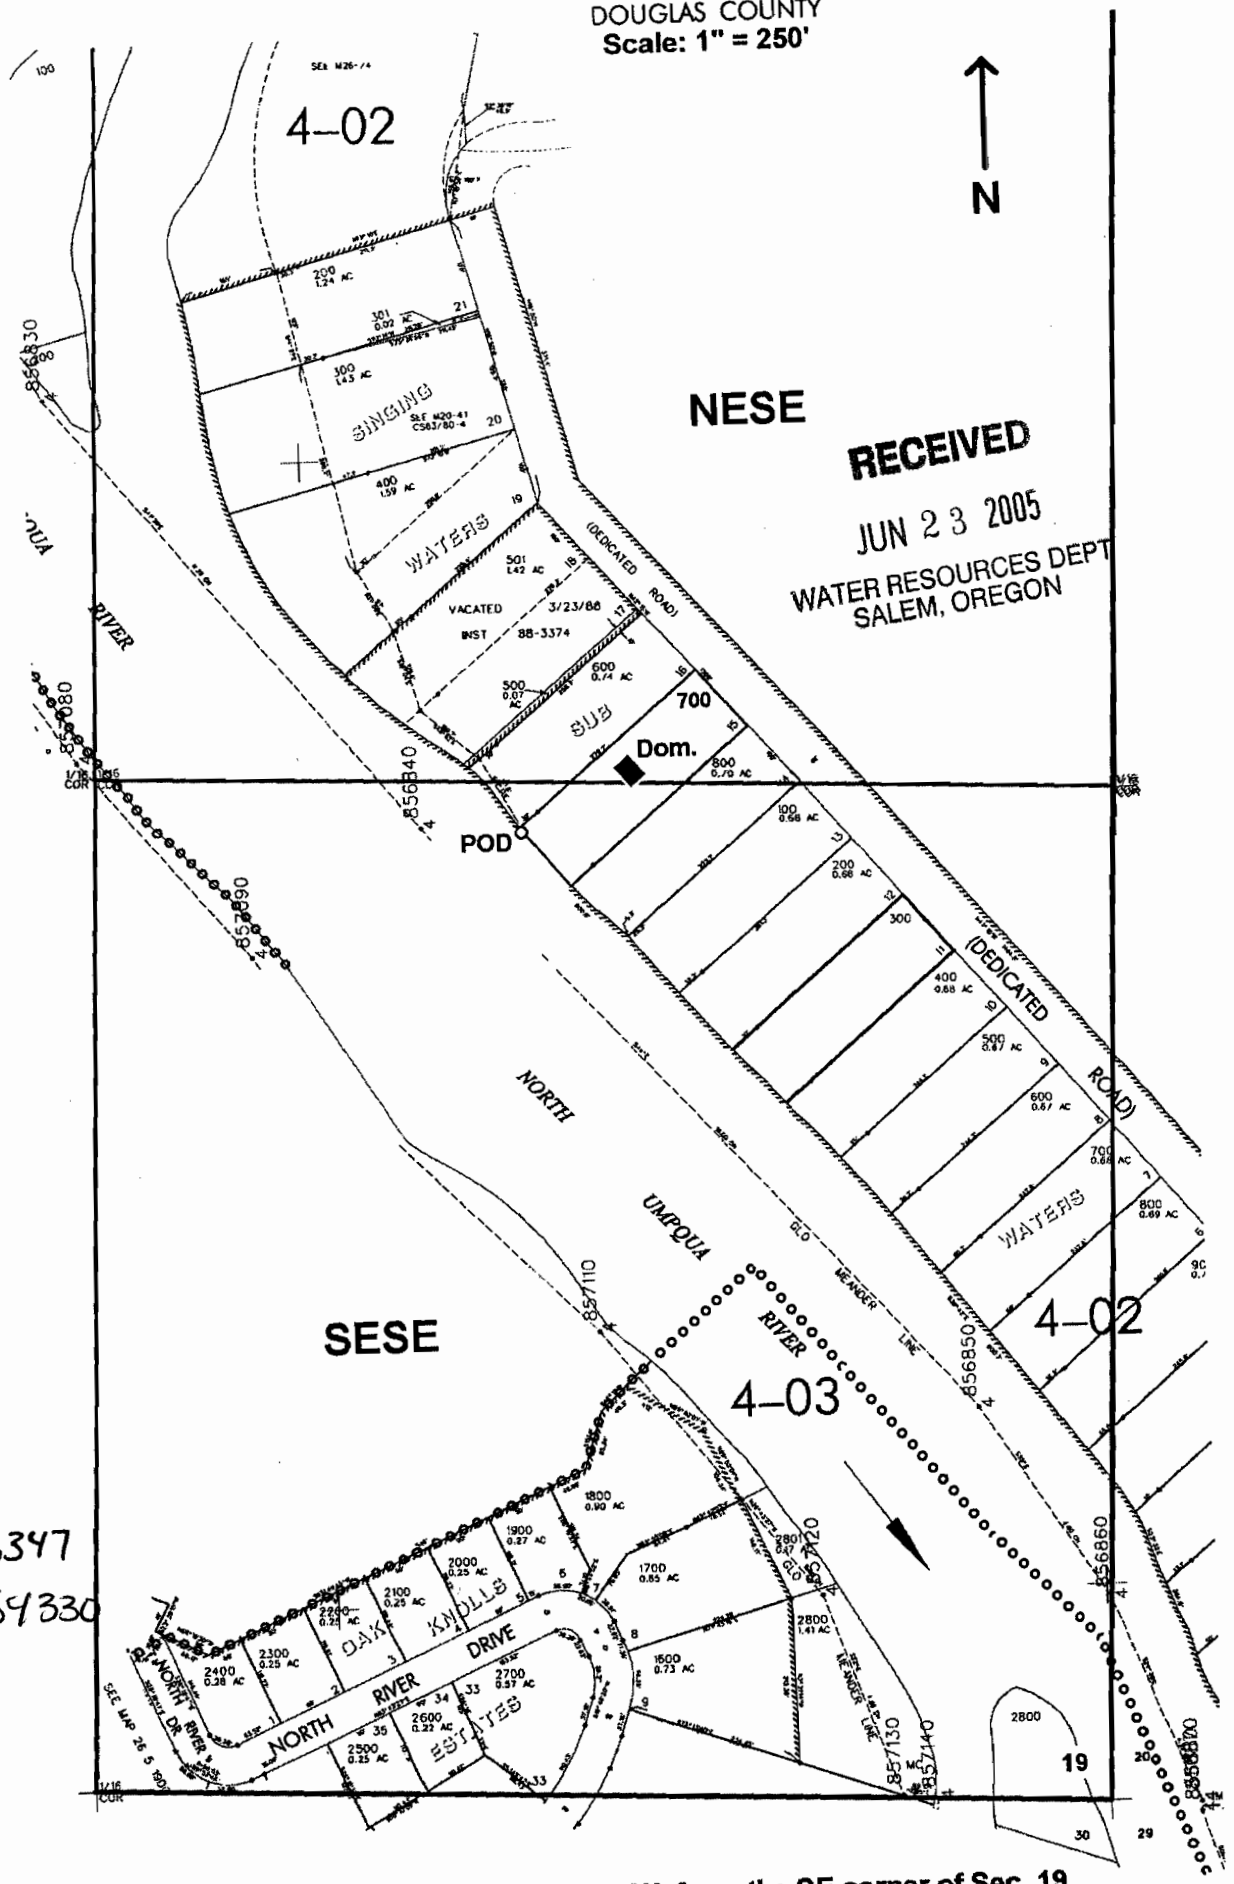

RECEIVED
JUN 23 2005
WATER RESOURCES DEPT
SALEM, OREGON

app no S-86347
Permit S-54330

POD is located 1250 ft. N. and 765 ft. W. from the SE corner of Sec. 19