CORRECTED
APPROX SCALE
1" = 400 FT

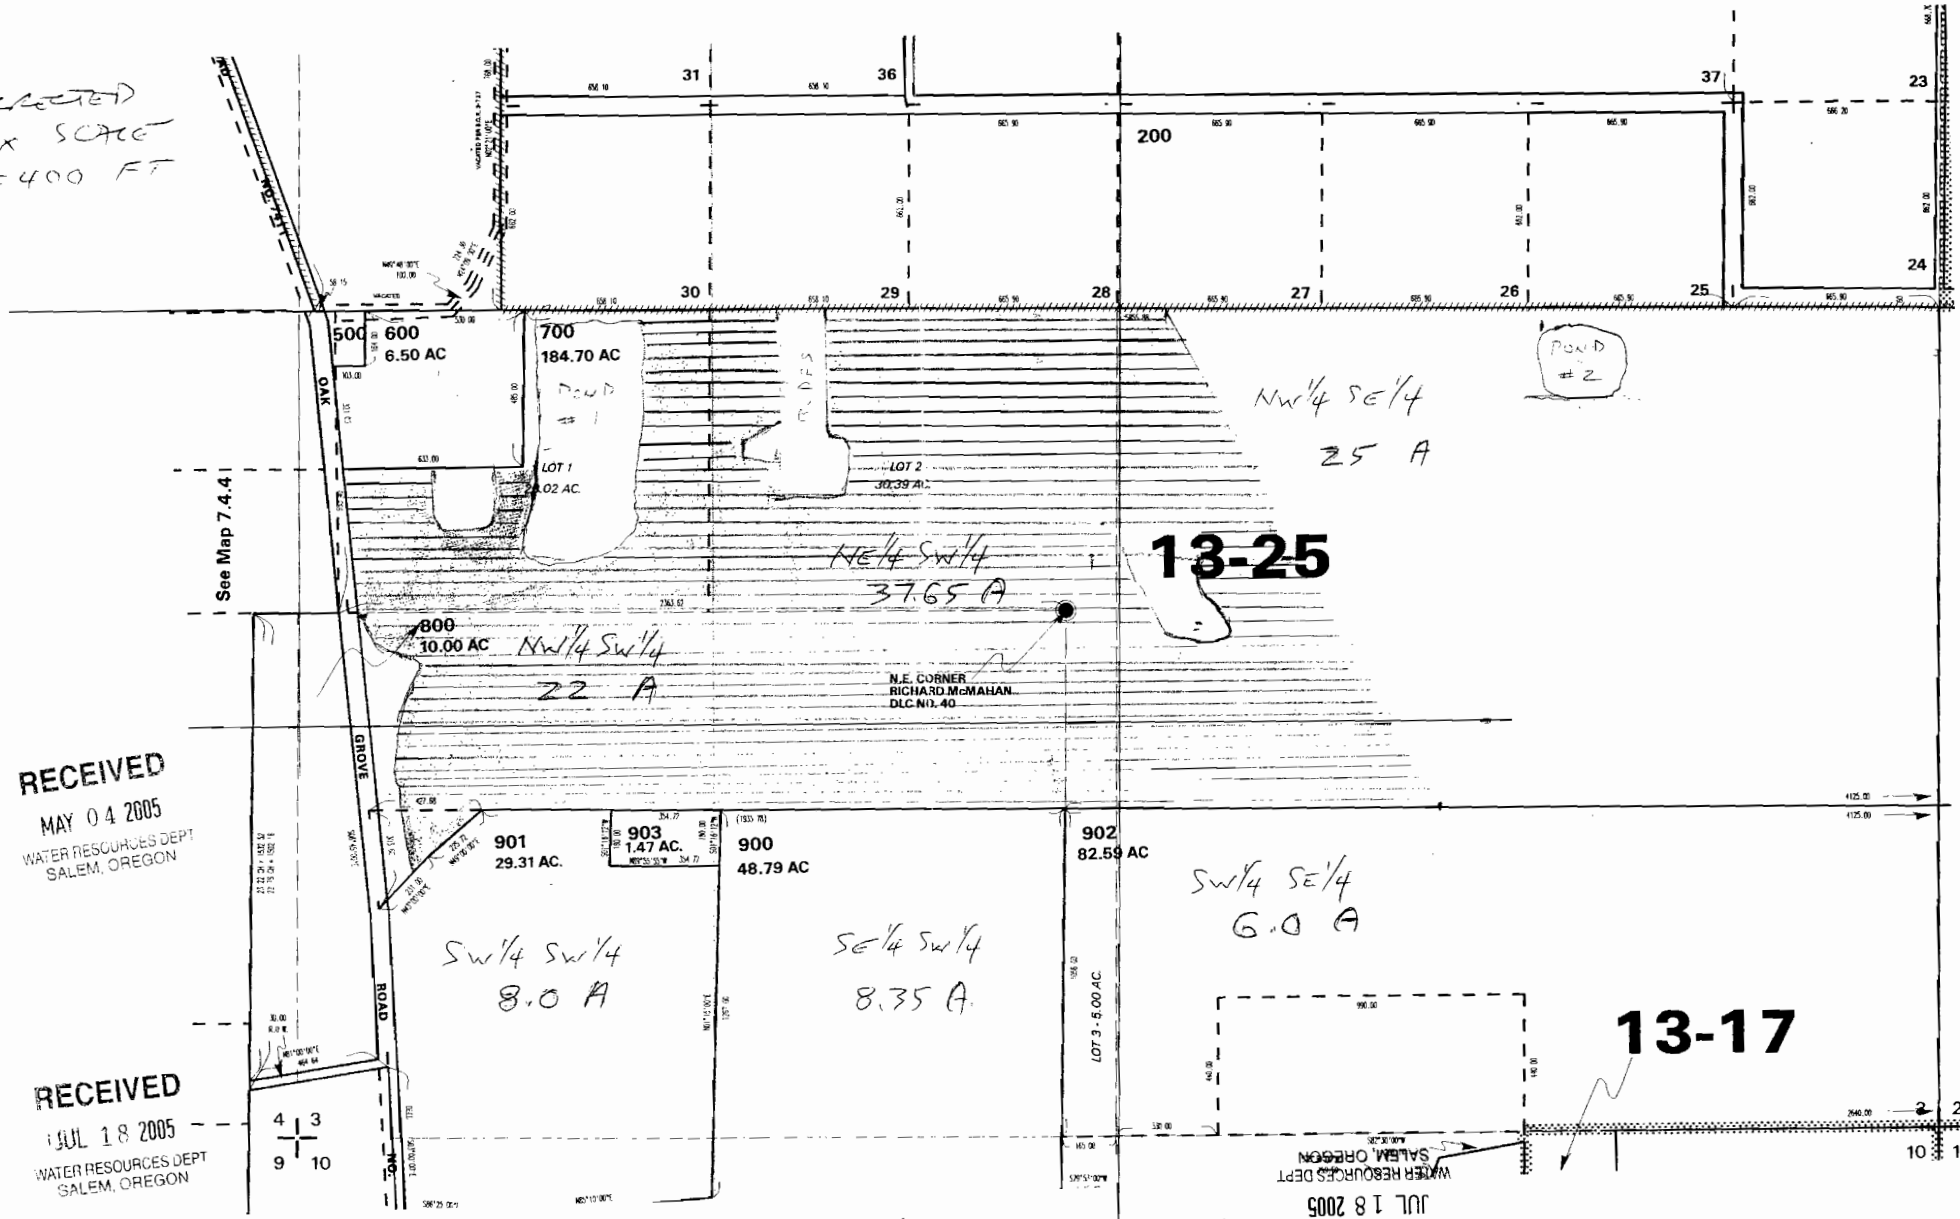

RECEIVED
MAY 04 2005
WATER RESOURCES DEPT
SALEM, OREGON

RECEIVED
JUL 18 2005
WATER RESOURCES DEPT
SALEM, OREGON

RECEIVED
MAY 04 2005
WATER RESOURCES DEPT
SALEM, OREGON

RECEIVED
JUL 18 2005
WATER RESOURCES DEPT
SALEM, OREGON

LARGE POND #1
LOCATED from SW CORNER
SECTION 3
950 ft EAST
2200 ft NORTH

SMALLER POND #2
LOCATED from SE CORNER
SECTION 3
1150 ft WEST