


COPY S-86325

Shriver/Phelps
LC # 700

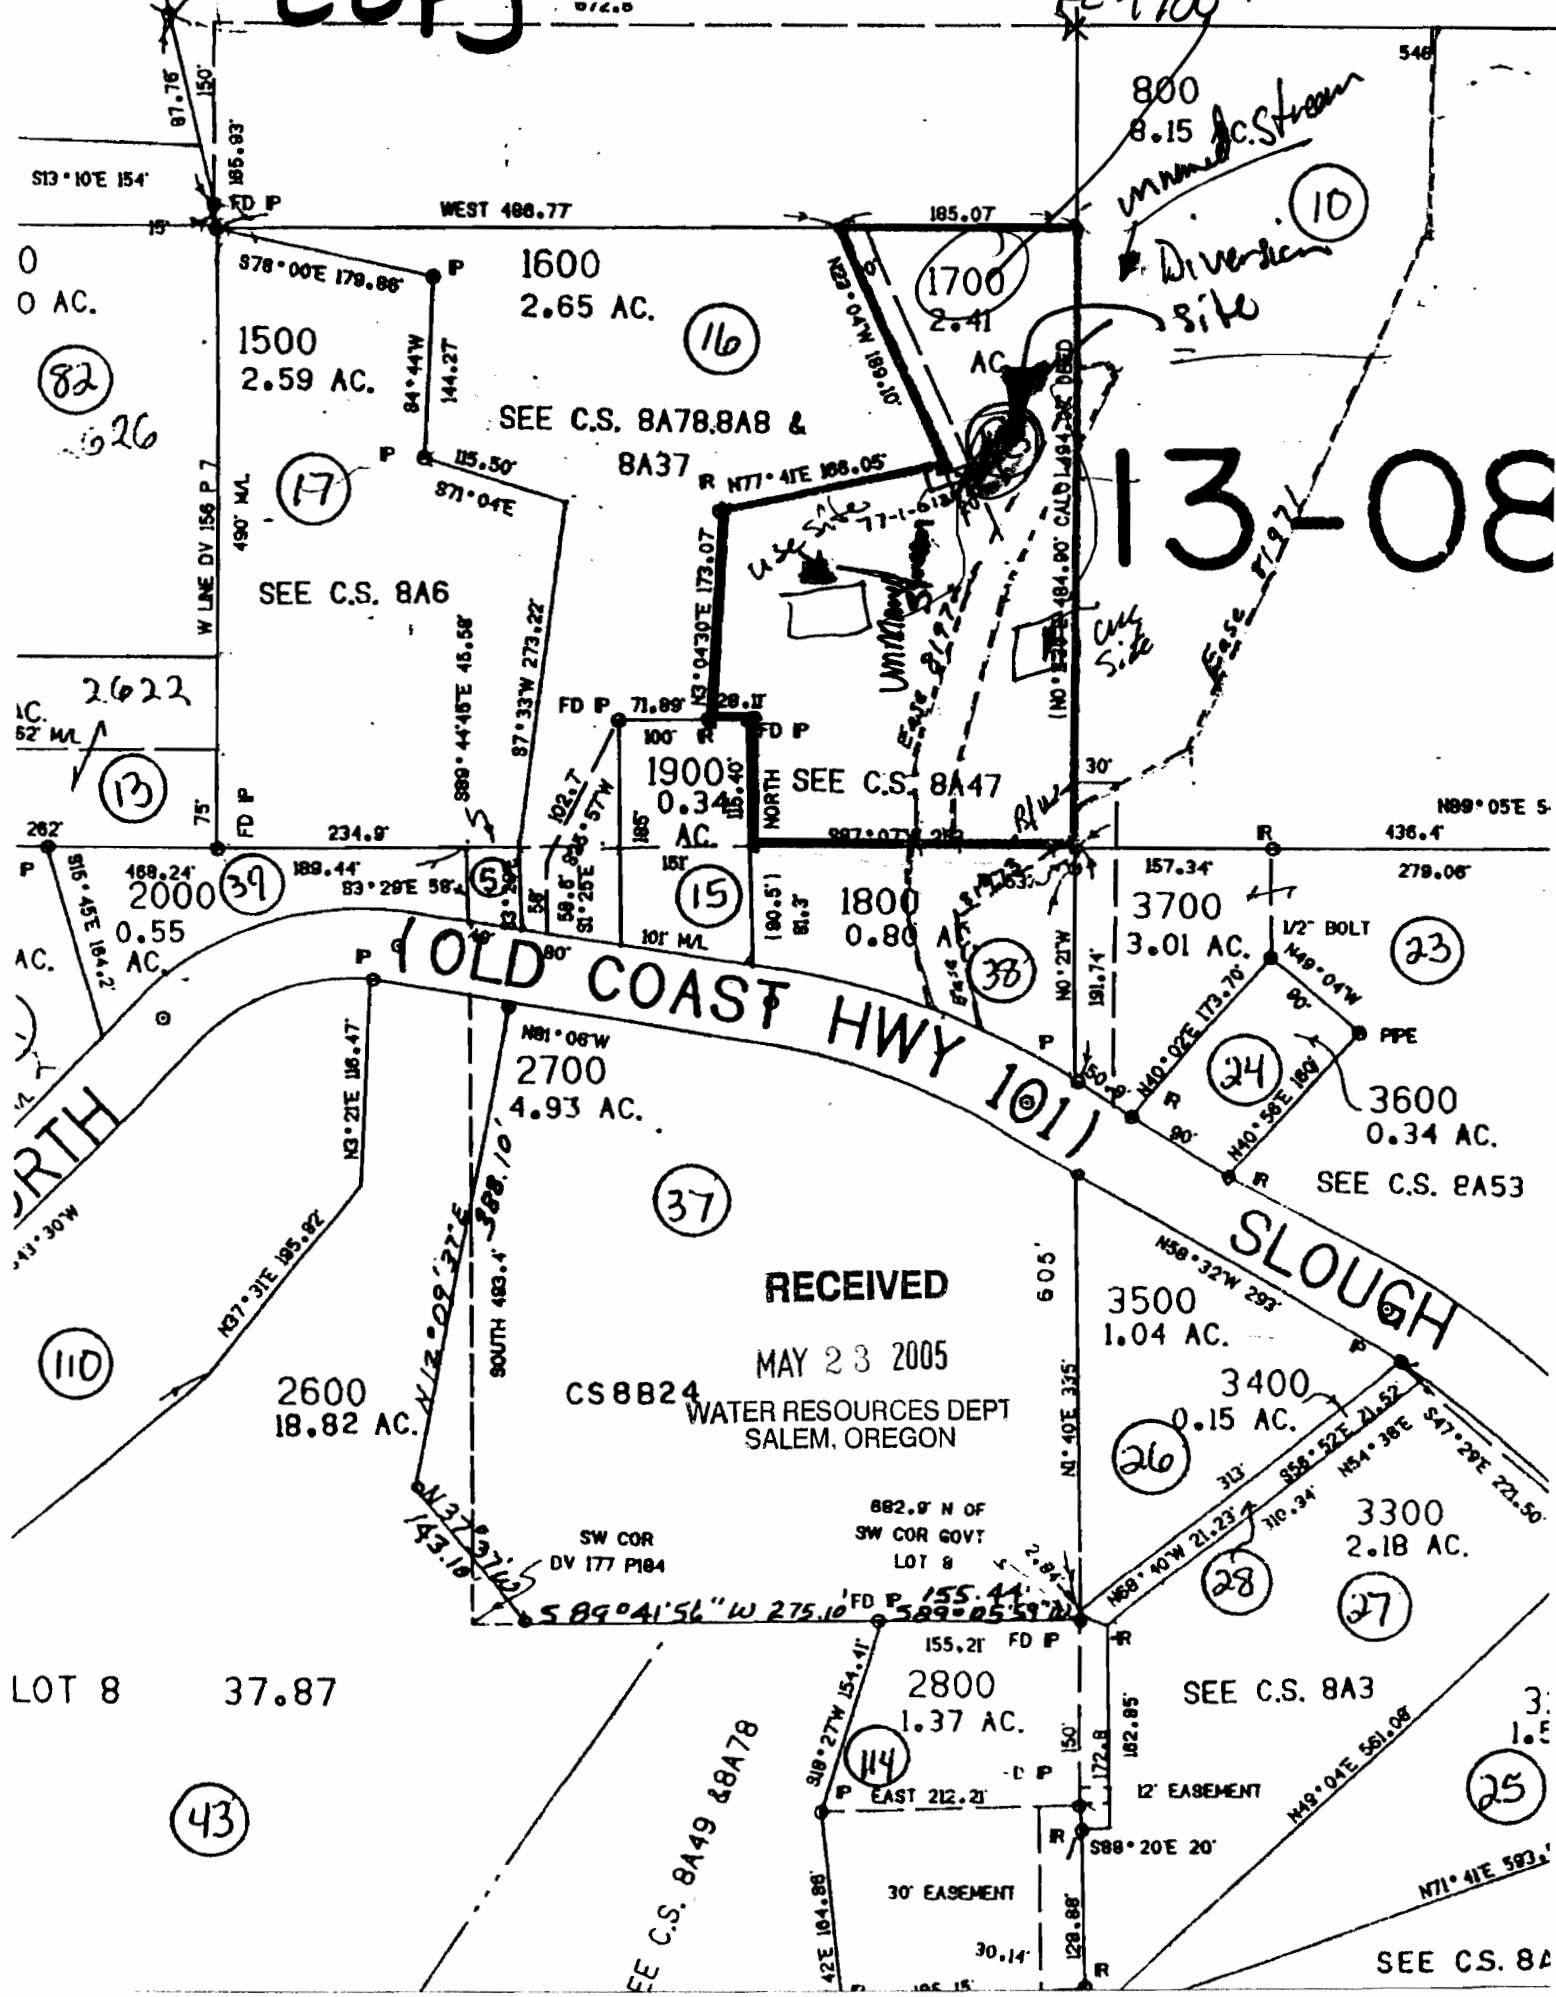

13-08

RECEIVED

MAY 23 2005

WATER RESOURCES DEPT
SALEM, OREGON

CS 8824

SW COR
DV 177 P184

LOT 8 37.87

SEE C.S. 8A