


For Reference -
 ADDED TO FILE
 SECTION 1 T4S R2W W.M.
 YAMHILL COUNTY
 1" = 1000'

THIS MAP WAS PREPARED FOR
 ASSESSMENT PURPOSE ONLY

4 2 01

CANCELLED
 290

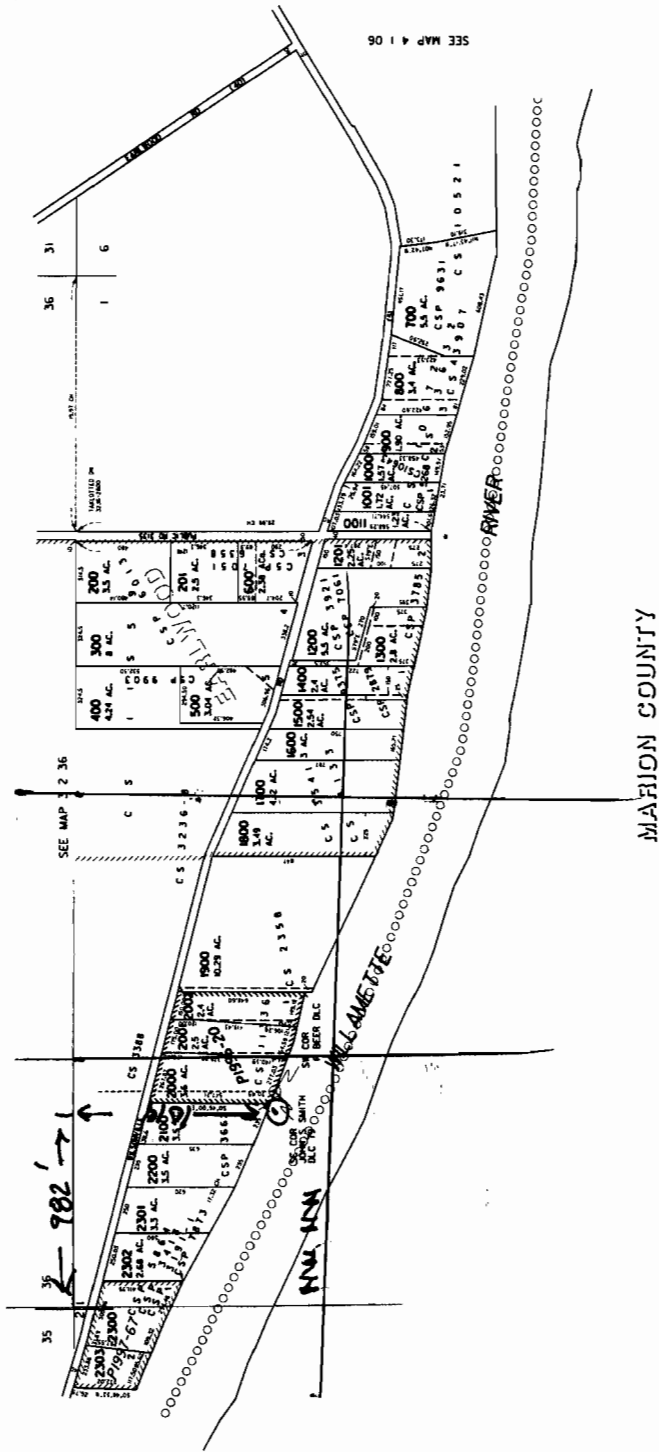

REVISED 3-11-05 BM

4 2 01

RECEIVED
 AUG 03 2006
 WATER RESOURCES DEPT
 SALEM, OREGON

appno S-86655
~~appno S-86655~~

SCALE
1 inch = 100 feet

Yamhill County
Section 1 T4S R2W W.M.
Tax lot 2100
NW, NW, Section 1

