

JOSEPHINE COUNTY


1" = 400'

SCALE 1" = 400'

T35S R7W Sec 13



SEE MAP 7 12

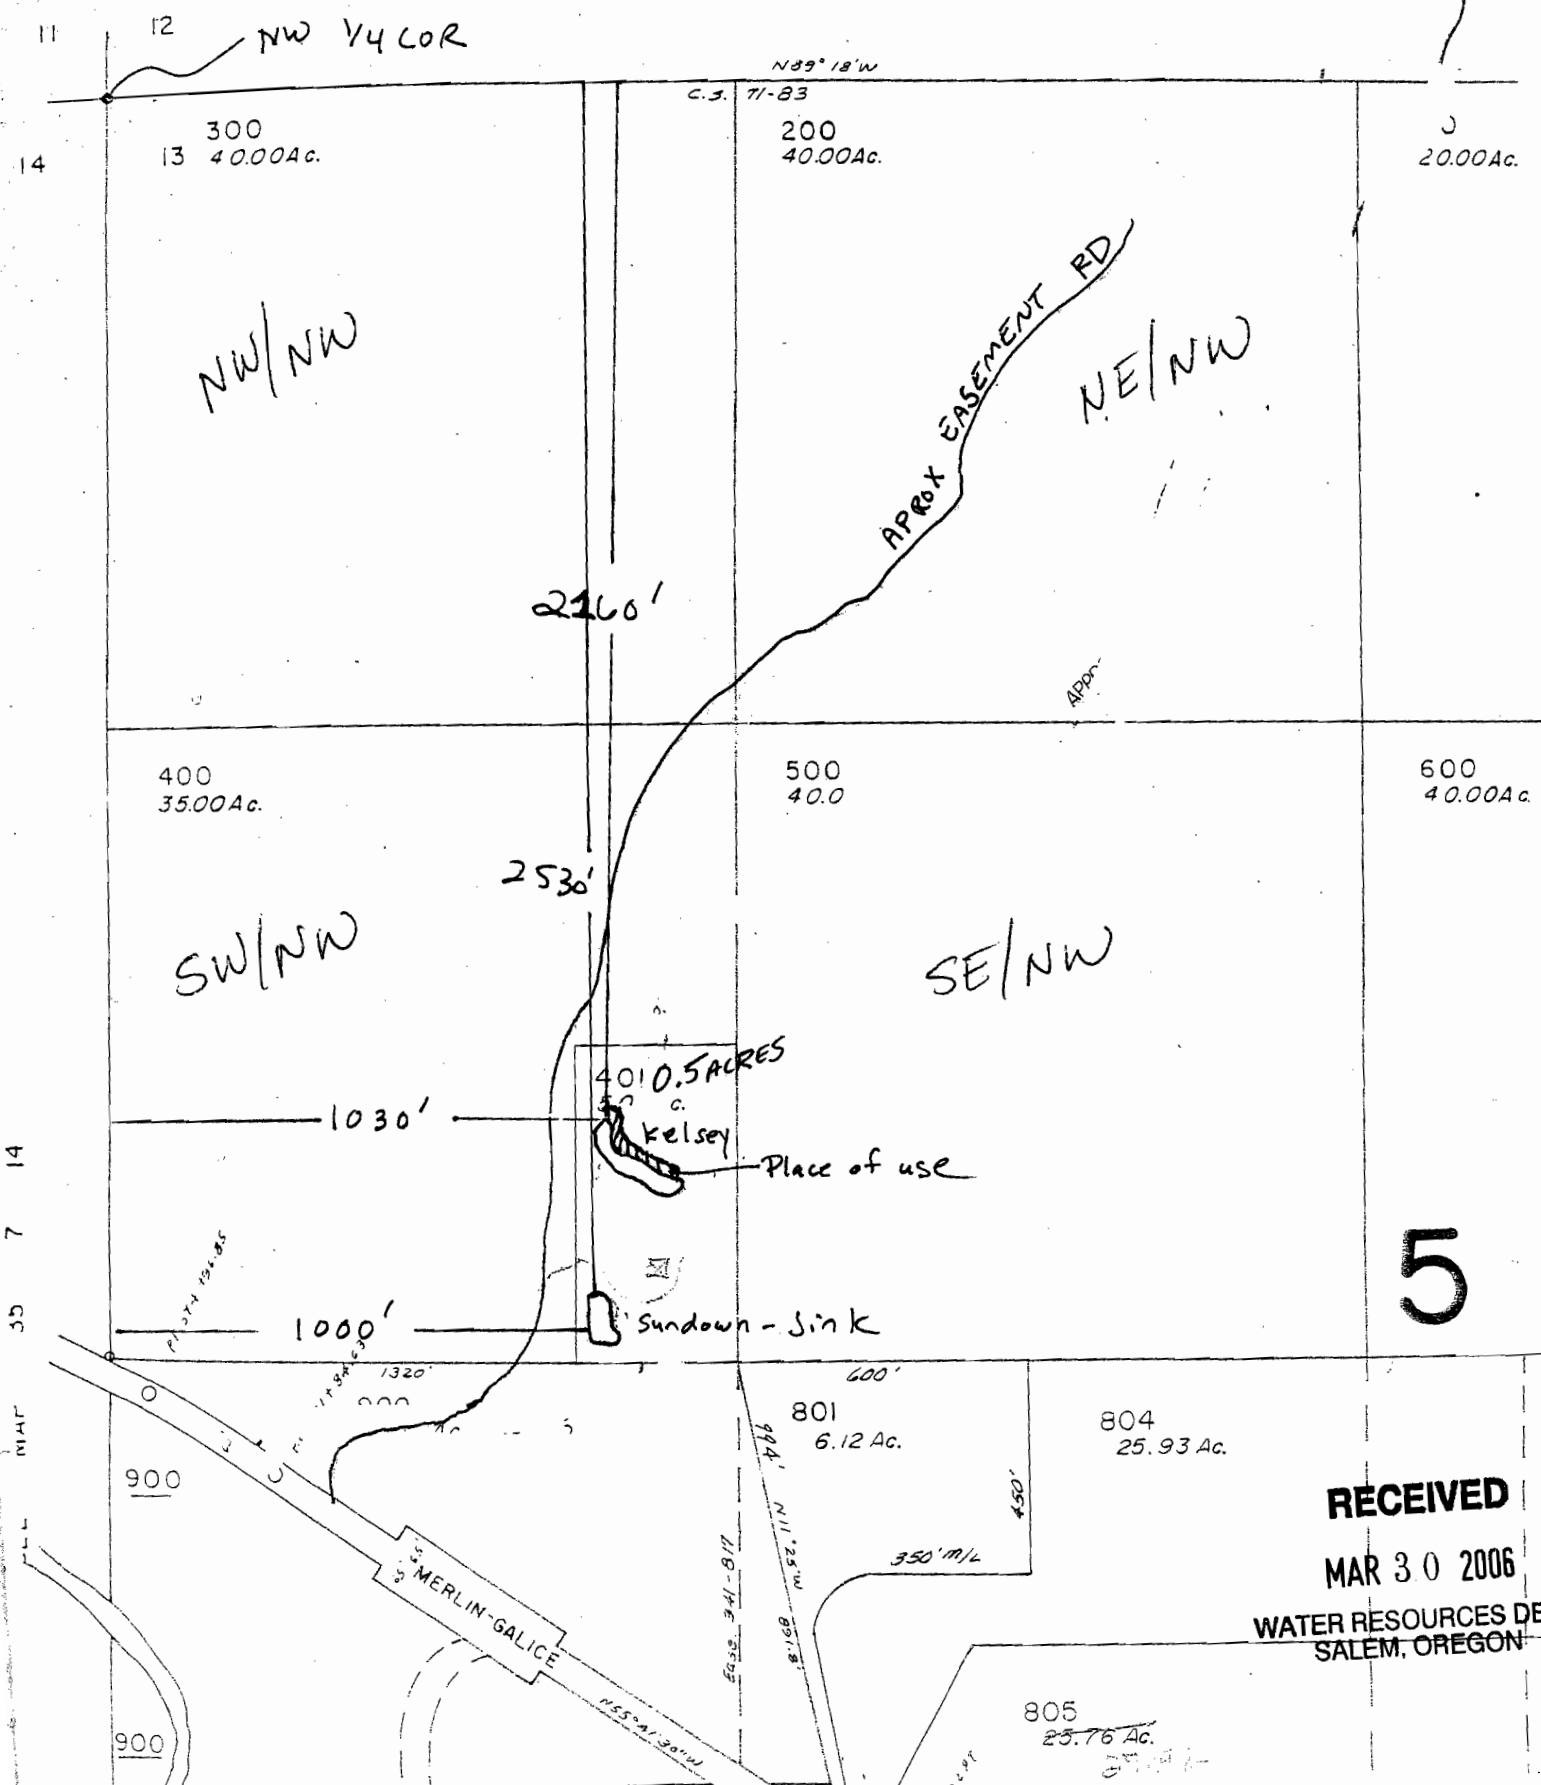

RECEIVED

MAR 30 2006

WATER RESOURCES DEPT SALEM, OREGON