

SEE MAP 19 03




RECEIVED  
SEP 12 2006  
WATER RESOURCES DEPT  
SALEM, OREGON

RECEIVED  
AUG 24 2006  
WATER RESOURCES DEPT  
SALEM, OREGON



23 24  
26 25

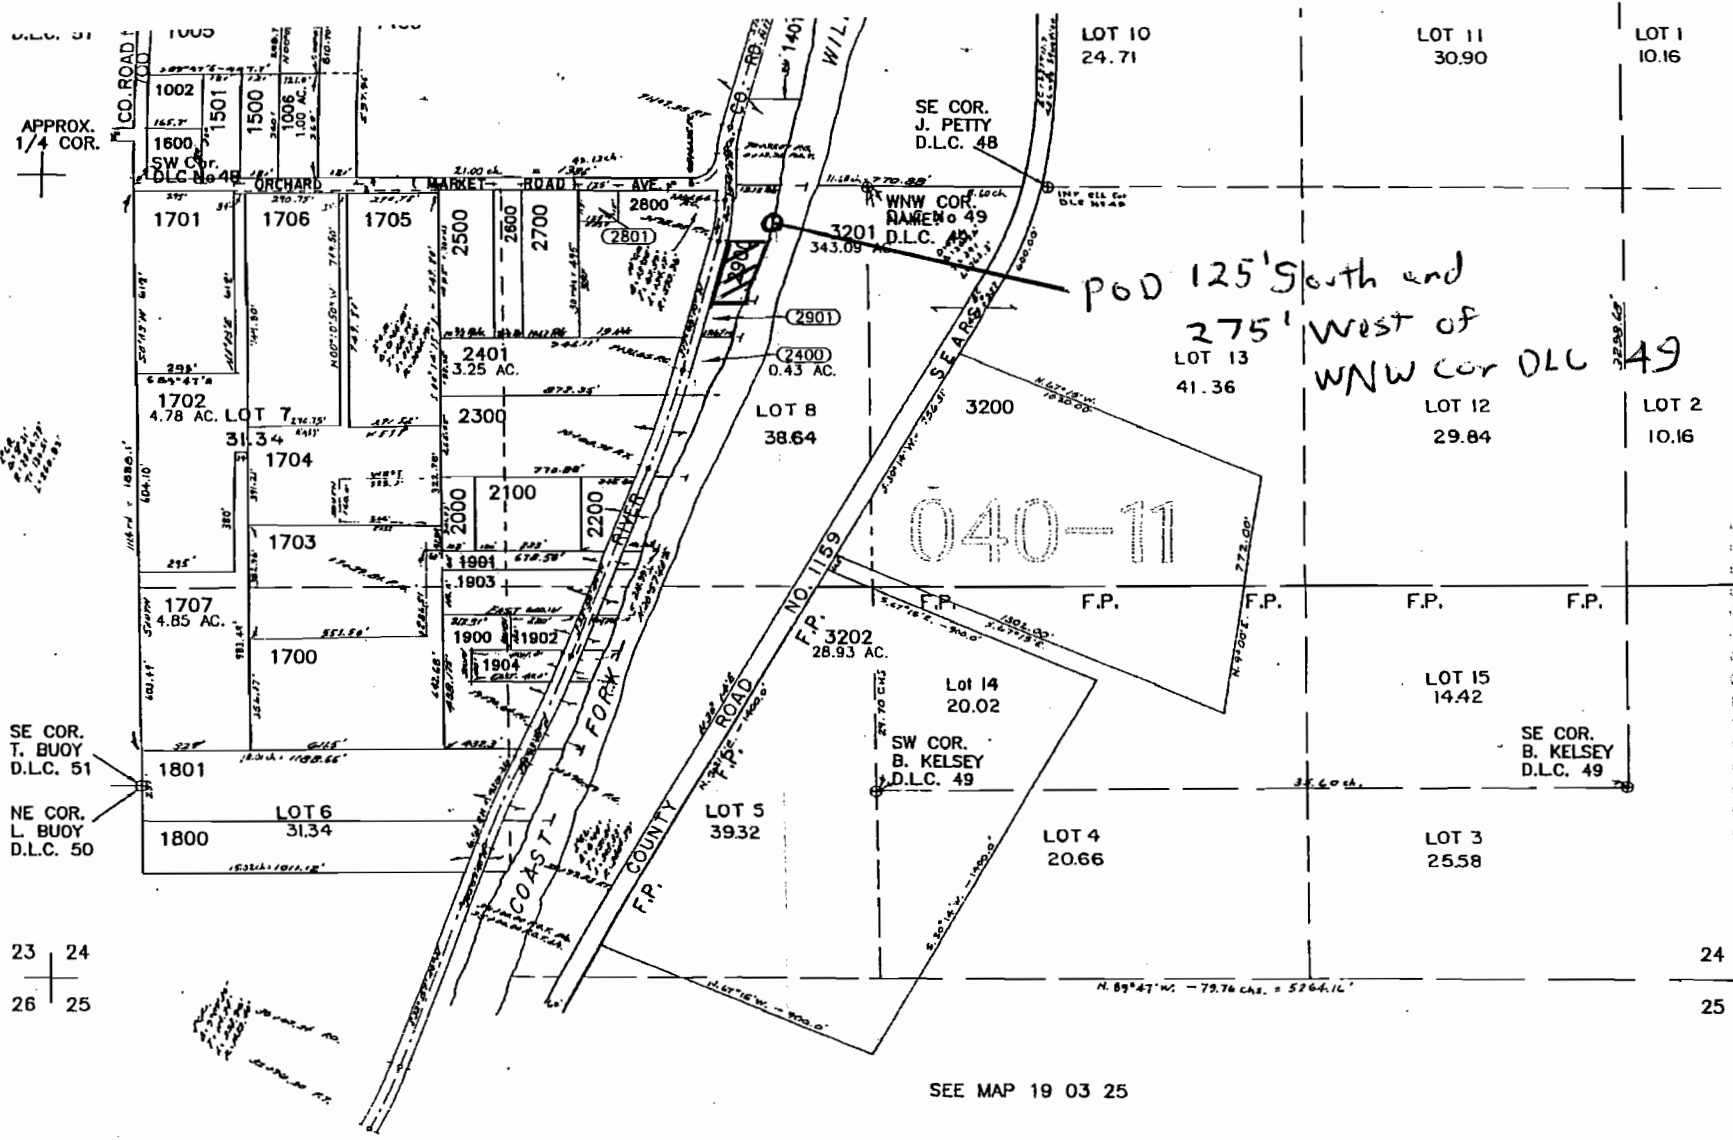

SEE MAP 19 03 25

Beatty F. Peterson  
82441 River Dr.  
Creswell

T 19 S, R 3 W  
Section 24

TL 2900  
in NE SW  
0.6 acres

1" = 60 feet

Tax map 19 03 24 000 2900

appno 5-86682