


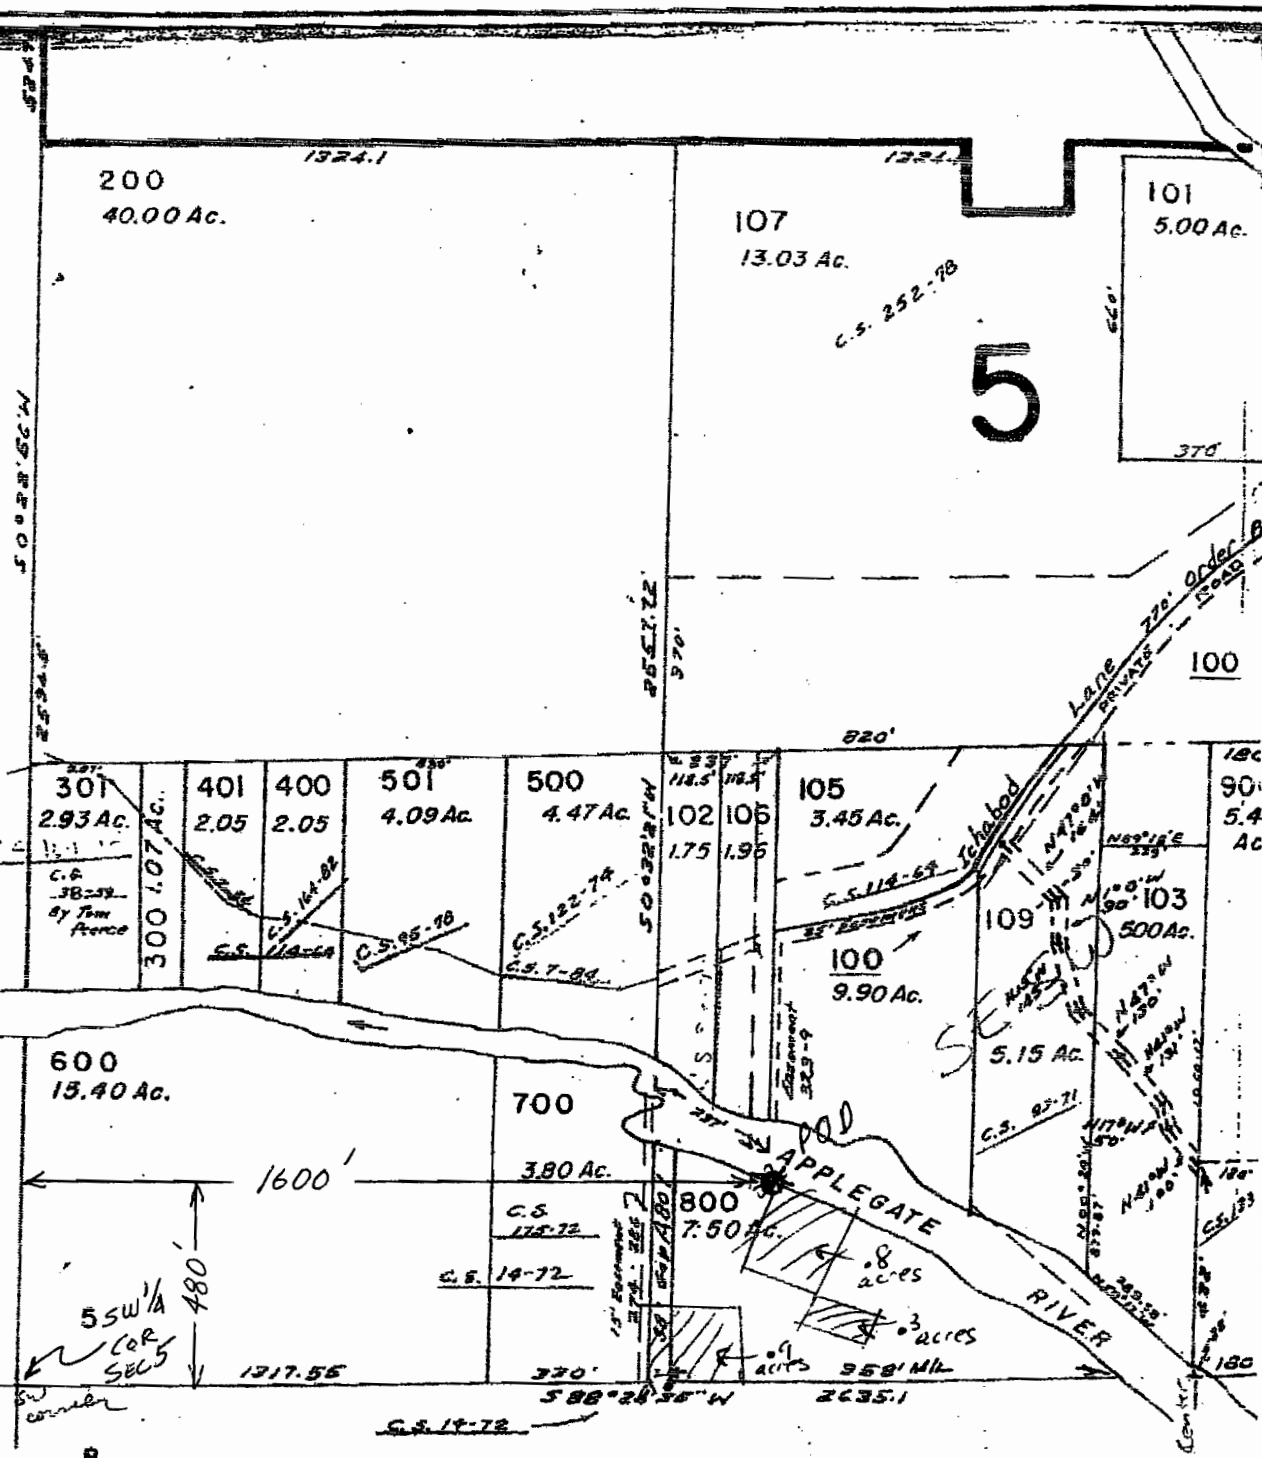

T37S R6W
Sec 5

SEE MAP 37 6



SEE MA=

GRS - P.O.D - 1600 ft east and 480ft north
 of SW Corner of section 5
 TOWNSHIP 37S RANGE 6W

6" = 2640'

1" = 440' SCALE

RECEIVED

app no S-86857

MAY 09 2007

WATER RESOURCES DEPT
 SALEM OREGON