


T. 30 S., R. 6 W.
 DOUGLAS COUNTY
 Scale: 1" = 500'

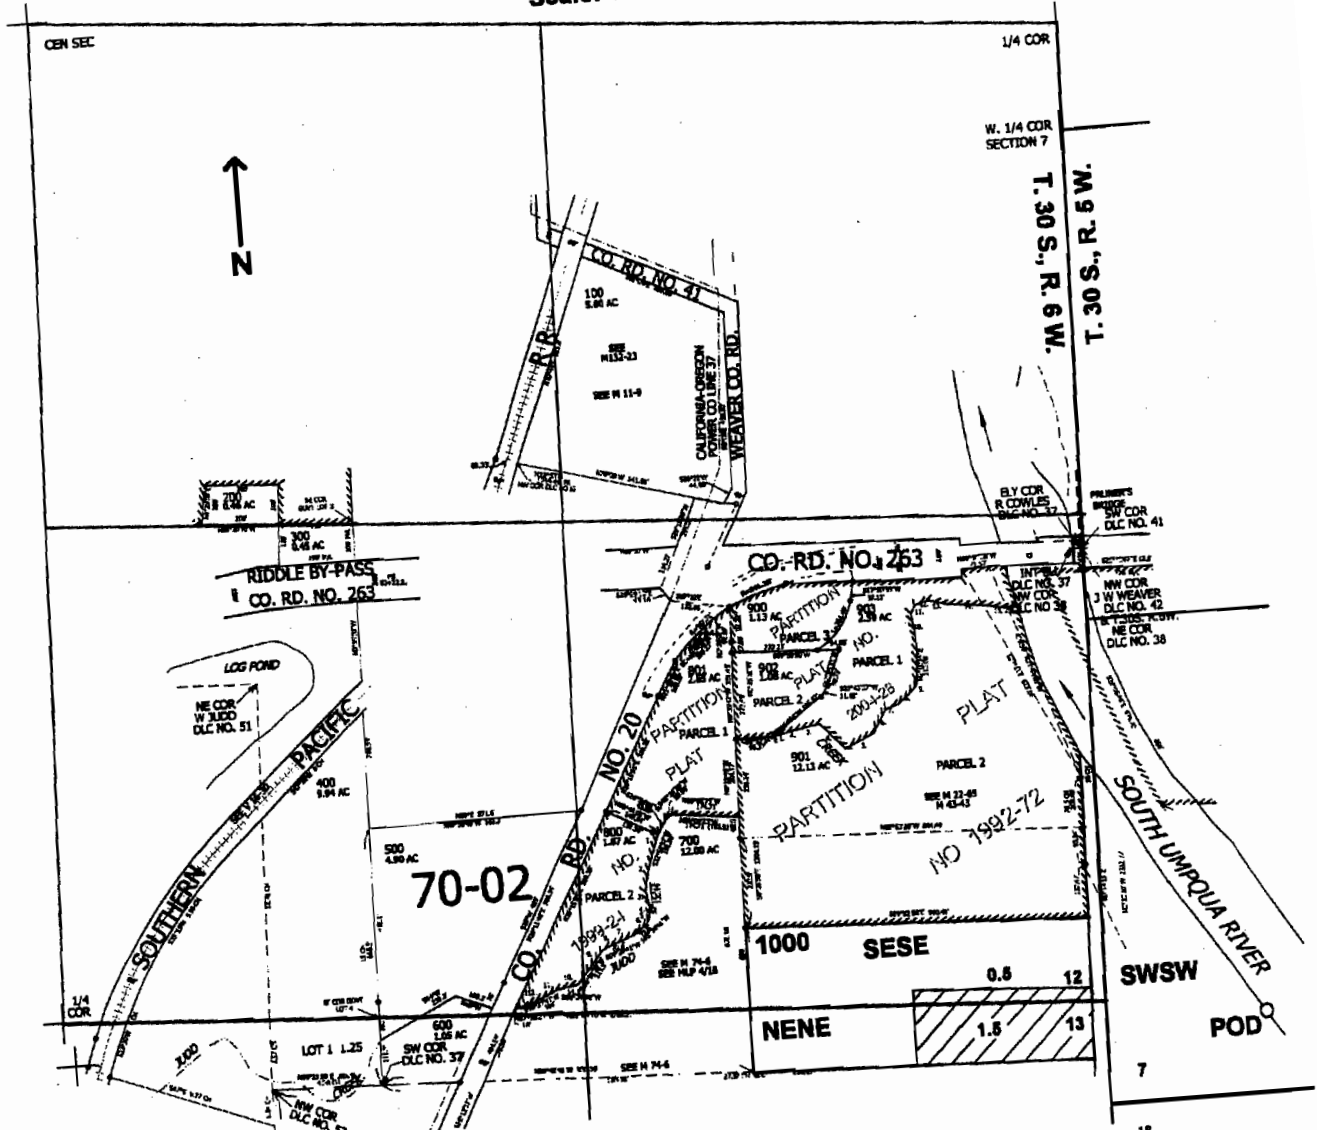

POD is located 50 ft. S. and 425 ft. E. from the SE corner of Sec. 12

RECEIVED

JUN 29 2007

WATER RESOURCES DEPT
 SALEM, OREGON