


Township 6 S, Range 3 W.

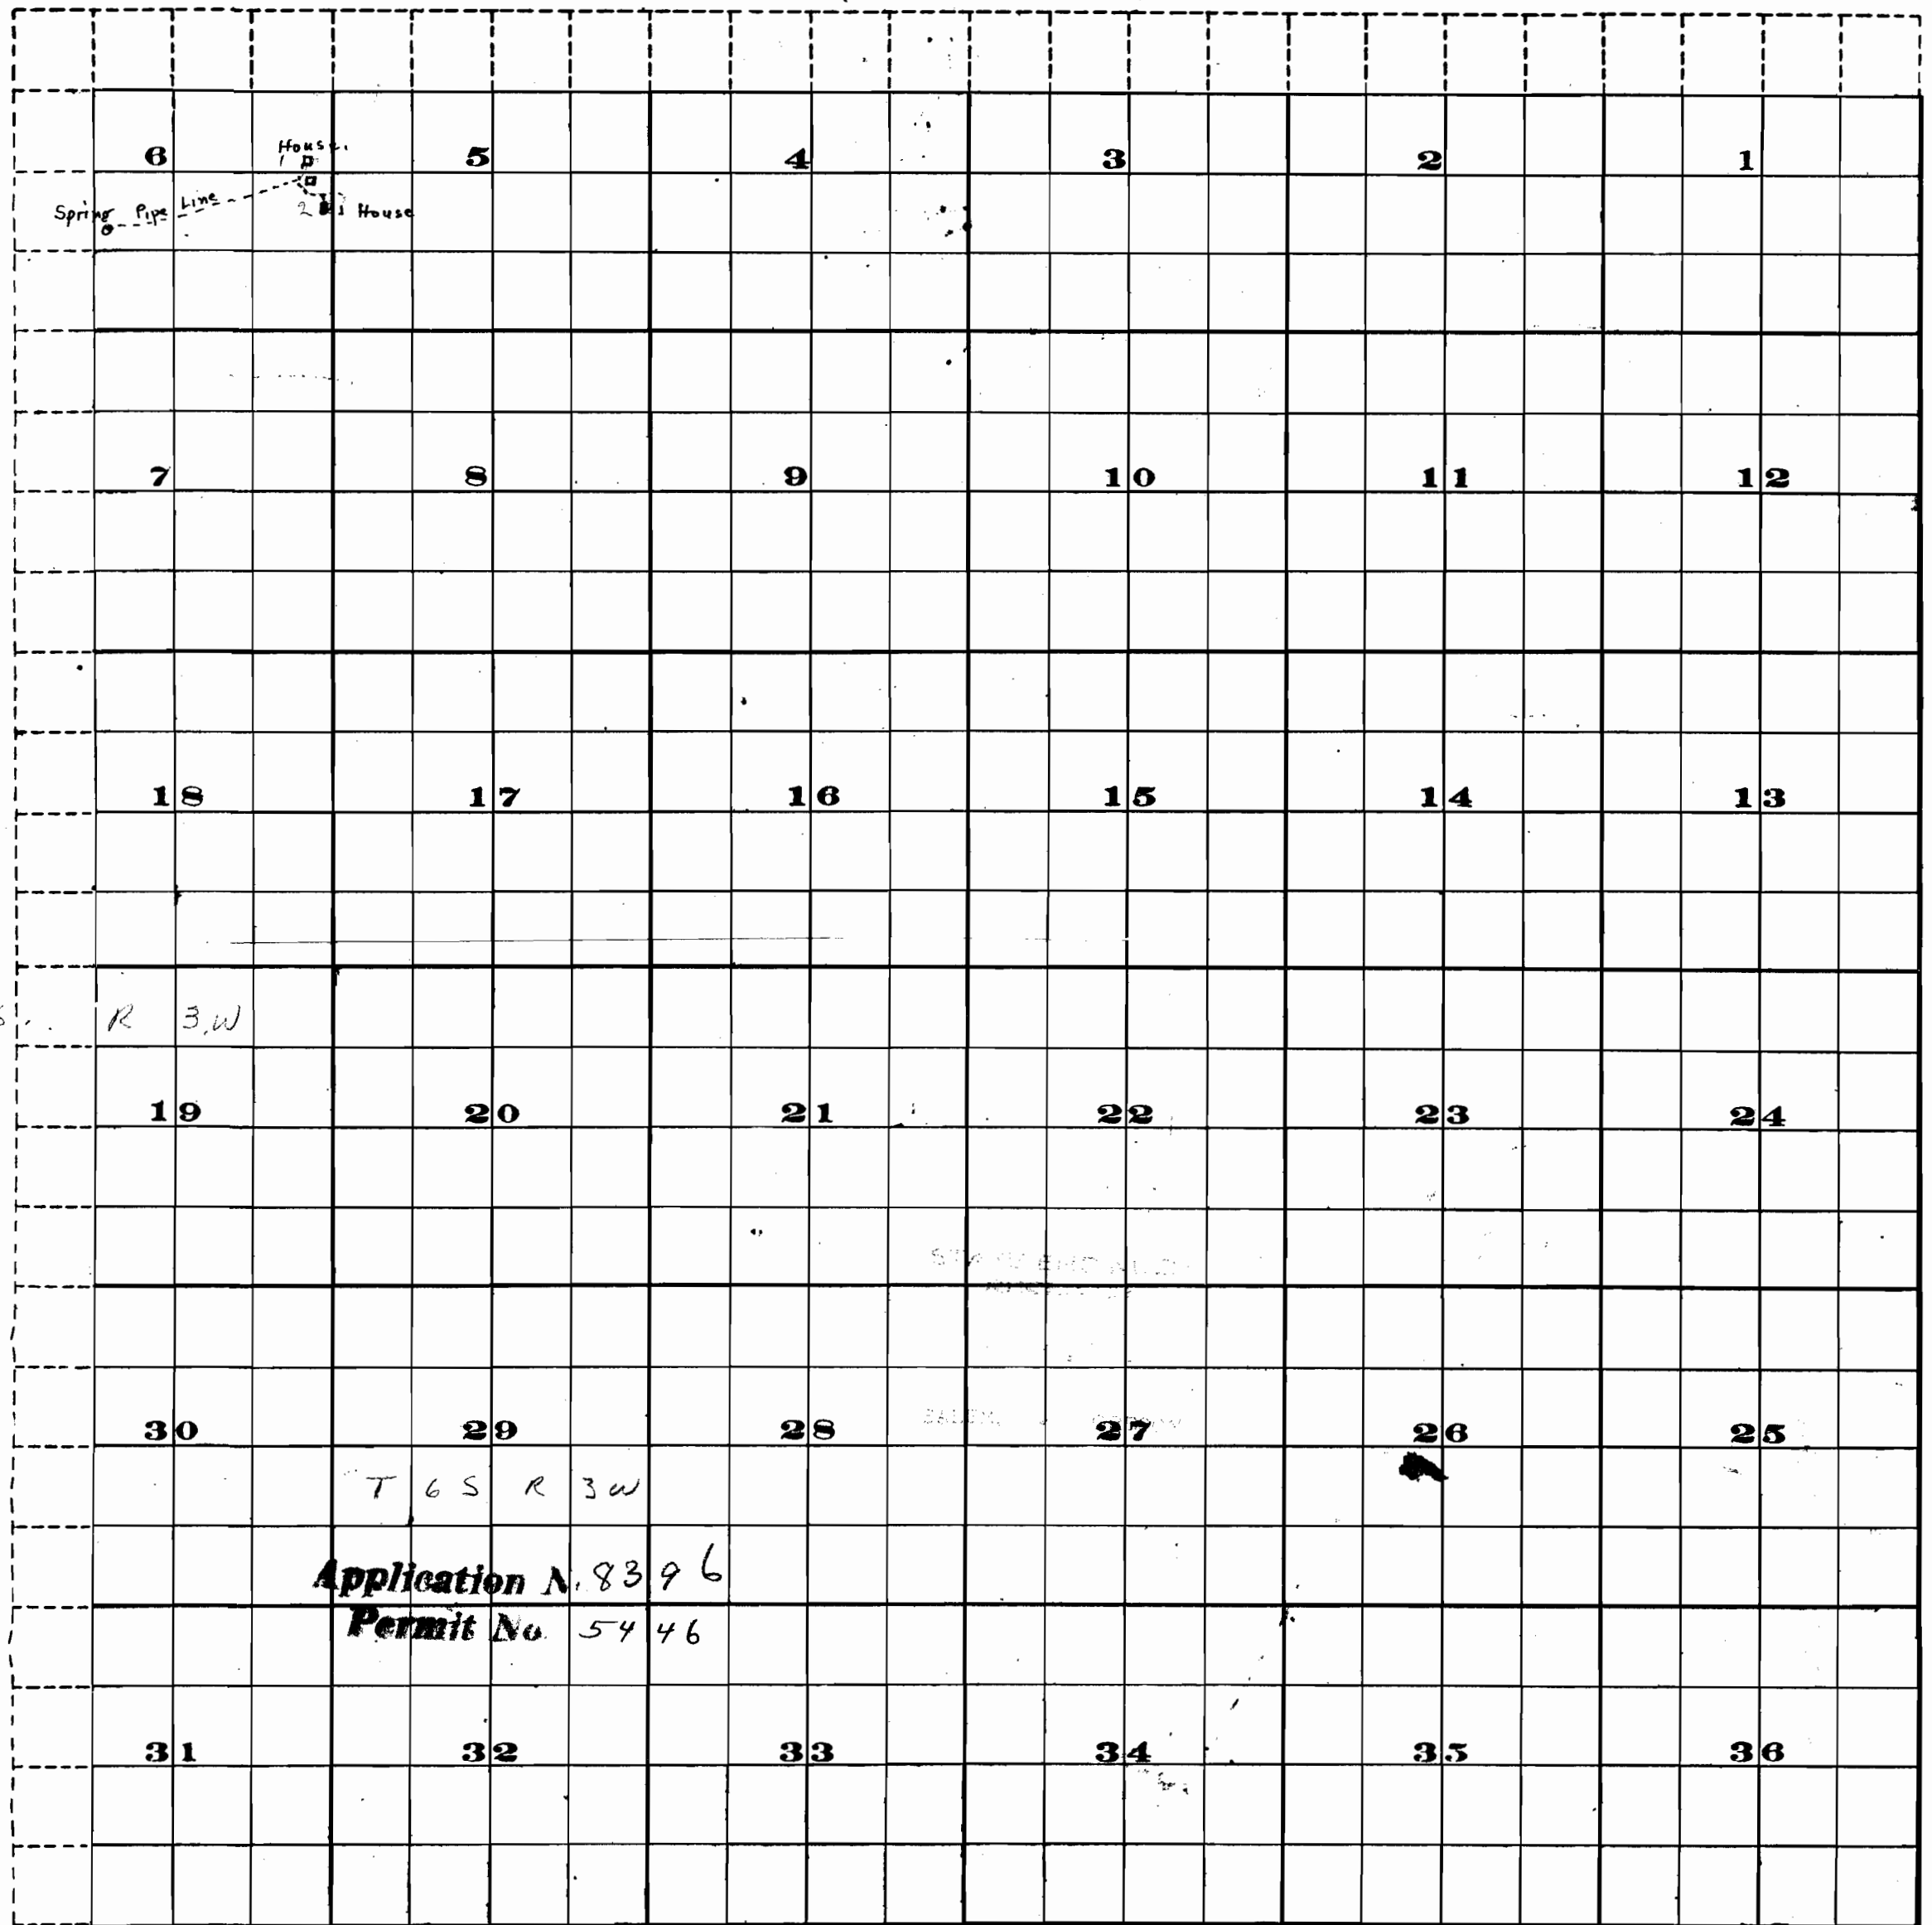

8396

8396

T 6 S R 3 W

8396

8396



Scale of Feet.