


Scale: 1" = 250'

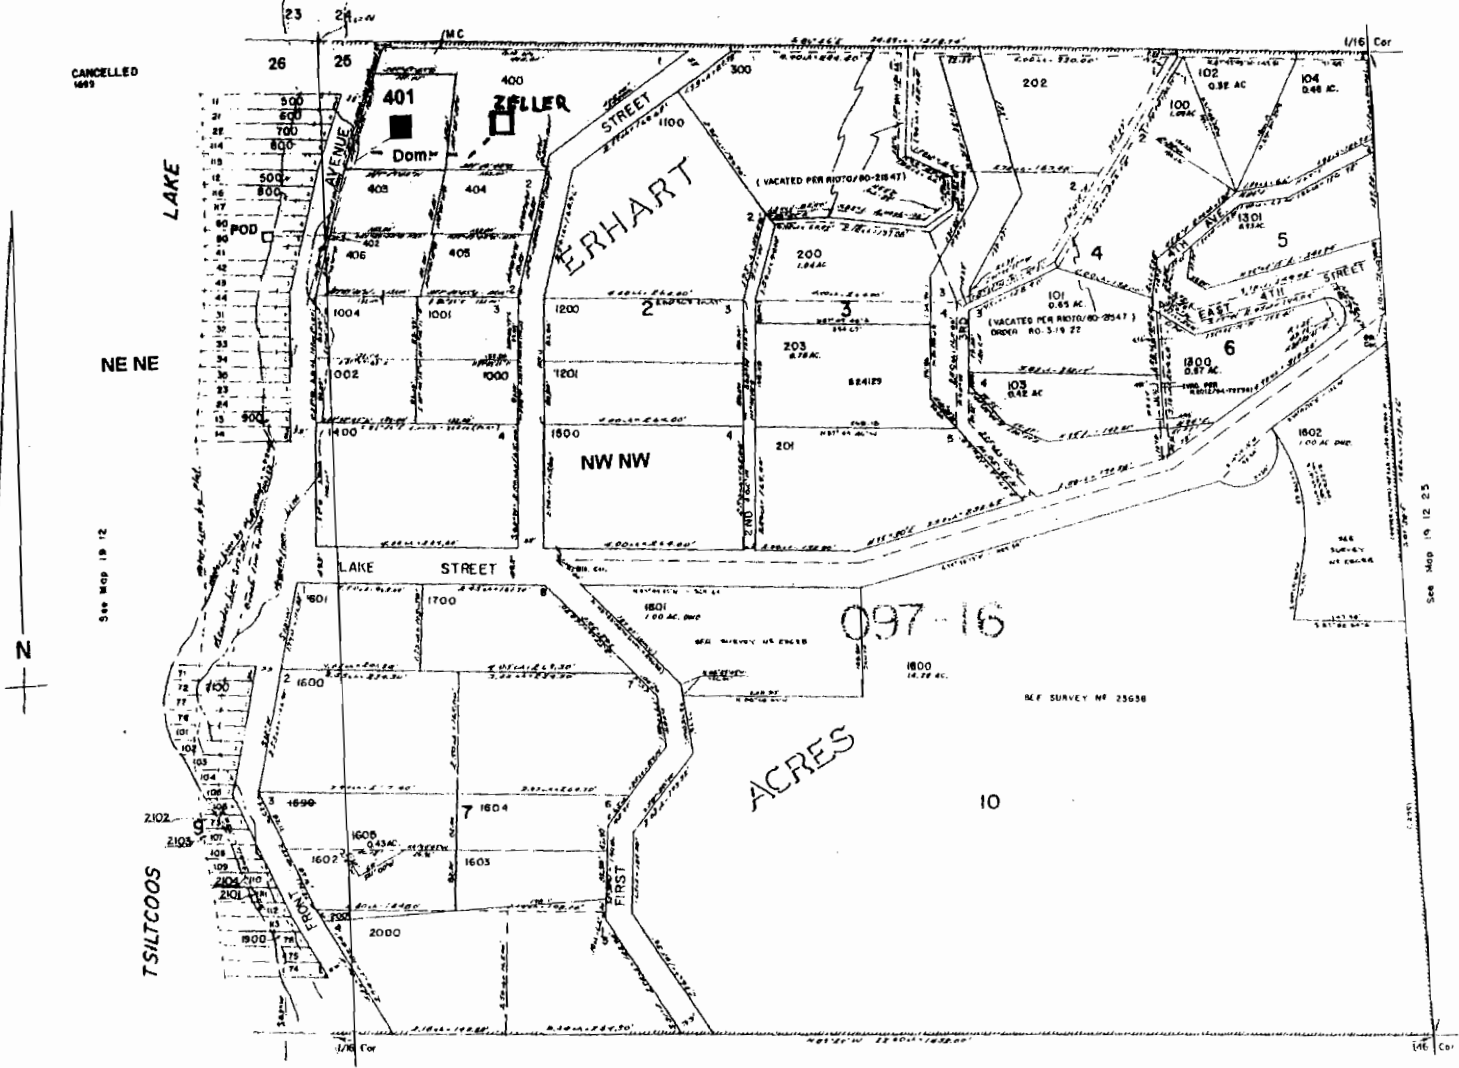

POD is located 250 ft. S. and 75 ft. W. from NW corner of Sec. 25

RECEIVED

MAR 28 2007

WATER RESOURCES DEPT
SALEM, OREGON

COAS 8/6818 Permit No S-54468