


5 W

NE1/4 NW1/4 SEC. 20, T. 37 S., R. 7 W., W.M.

This correction is to clarify that Range is 5 W, not 7 W.

*Renee Smith
9/18/08*

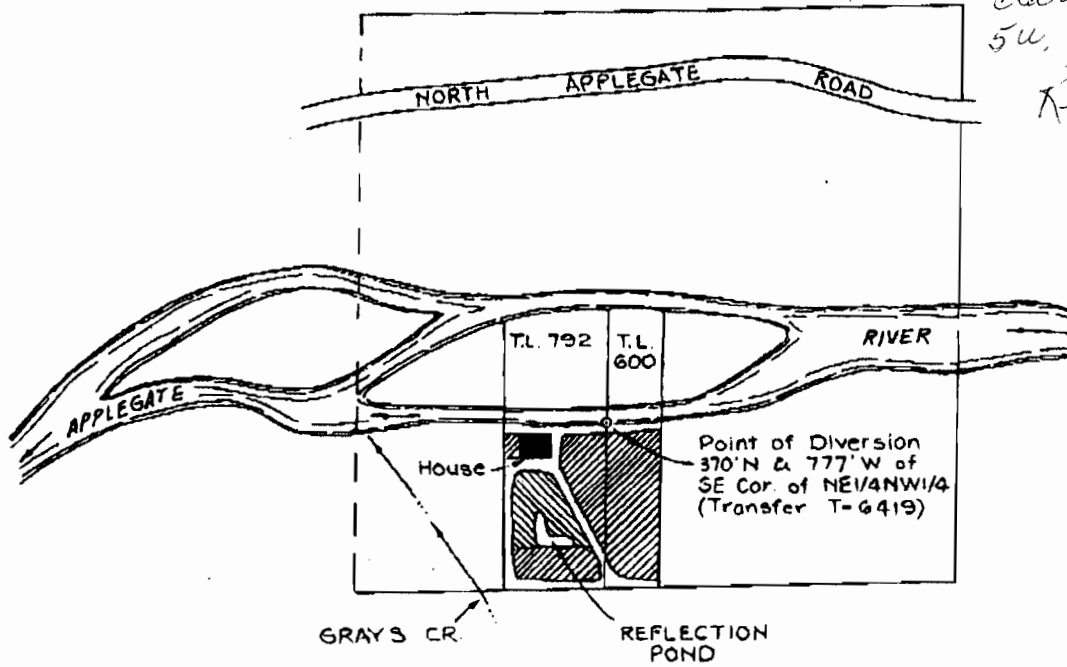

LEGEND:

This plat was prepared for the purpose of identifying the location of the water right only. There is no intent to provide dimension or locations of property ownership lines.

- PLACE OF USE AUTHORIZED BY CERTIFICATE NO. 63299 (0.60 Acres)
- PLACE OF USE PER PERMIT NO. 51123 (1.54 Acres)

A six page site report accompanies this plat.

RECEIVED

SEP 22 2008
WATER RESOURCES DEPT
SALEM, OREGON

RECEIVED

MAY 05 2008
WATER RESOURCES DEPT
SALEM OREGON

RECEIVED

SEP 21 1993
WATER RESOURCES DEPT.
SALEM, OREGON


App No S-87163

PROJECT NO.
314-93-230

DRAWING NO.
44-8.5.11

DATE
9-17-93

SCALE
1" = 400'

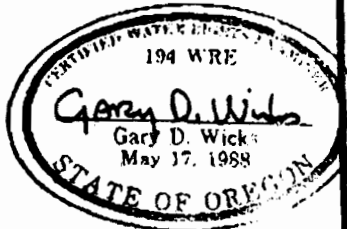

PLAT OF CLAIM OF BENEFICIAL USE

LOCATED IN
NE1/4NW1/4 SECTION 20, T. 37 S., R. 7 W., W.M.
JOSEPHINE COUNTY, OREGON

PREPARED FOR:
Mr. Robert M. Sronce
7823 Williams Highway
Grants Pass, Oregon 97527
Tel. 862-2265

PREPARED BY:
GARY D. WICKS, P.E., P.L.S.
WICKS ENGINEERING & SURVEYING
402 N.E. "E" Street
Grants Pass, Oregon 97526
Tel. 479-3436