

APP-586000, Permit  
 APP-R25999, Permit  
 Township 39 South, Range 18 East, W.M.  
 All TAX LOT 1300

DRG

DRG 11/11/04


DAM "A"

Point of Diversion -  
 Center of Dam  
 2,500' East & 100'  
 North from the SW  
 Corner, Section 7,  
 T 39 S, R 18 E, WM

DRG 11/11/04

DAM "B"

Center of Dam  
 700' South & 400'  
 East from the N<sup>1</sup>/<sub>4</sub>  
 Corner, Section 18,  
 T 39 S, R 18 E, WM

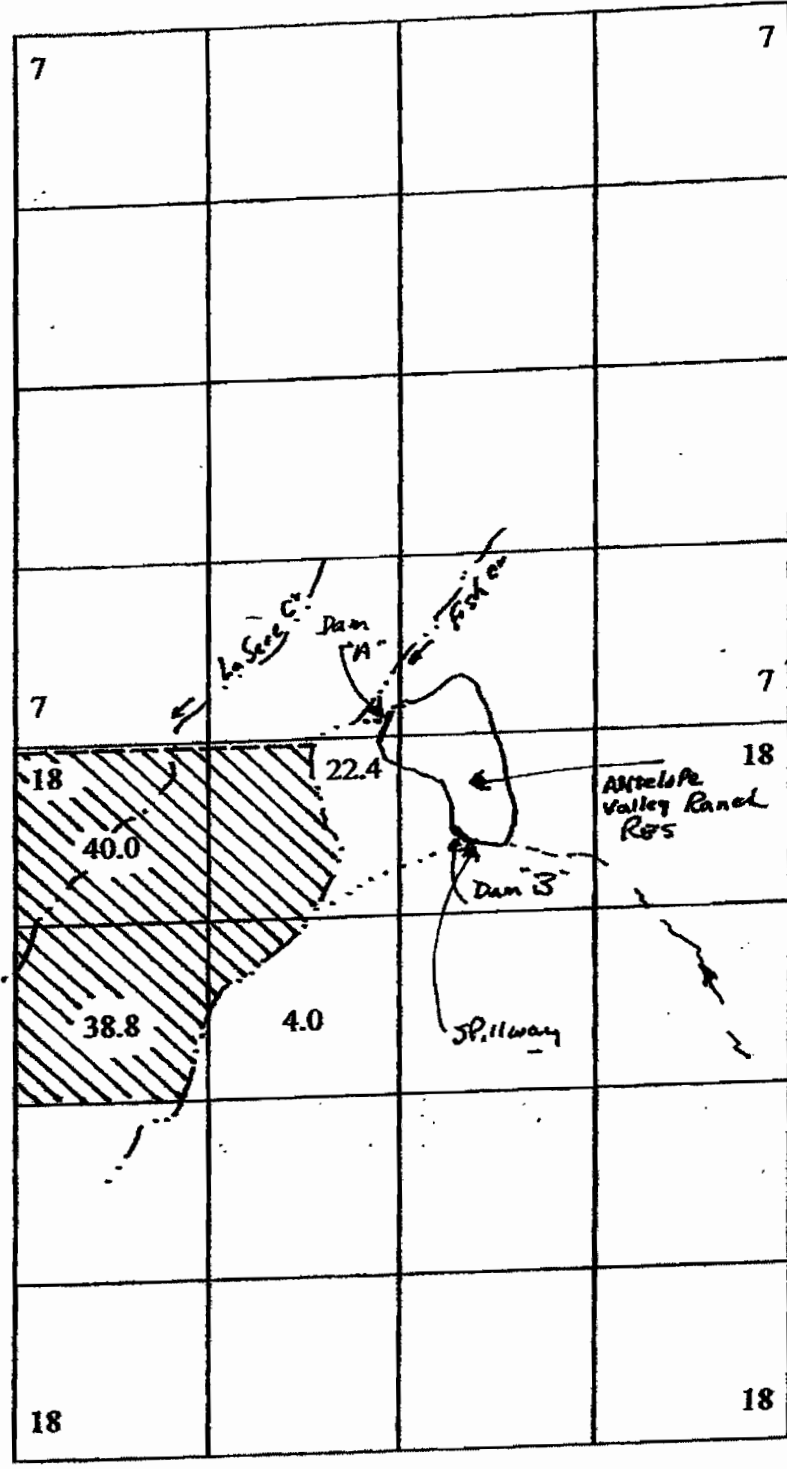

**RECEIVED**  
 NOV 11 2004  
 WATER RESOURCES DEPT  
 SALEM, OREGON