


SW1/4 SEC.13 T.24S. R.7W. W.M.
DOUGLAS COUNTY
Scale: 1" = 500'

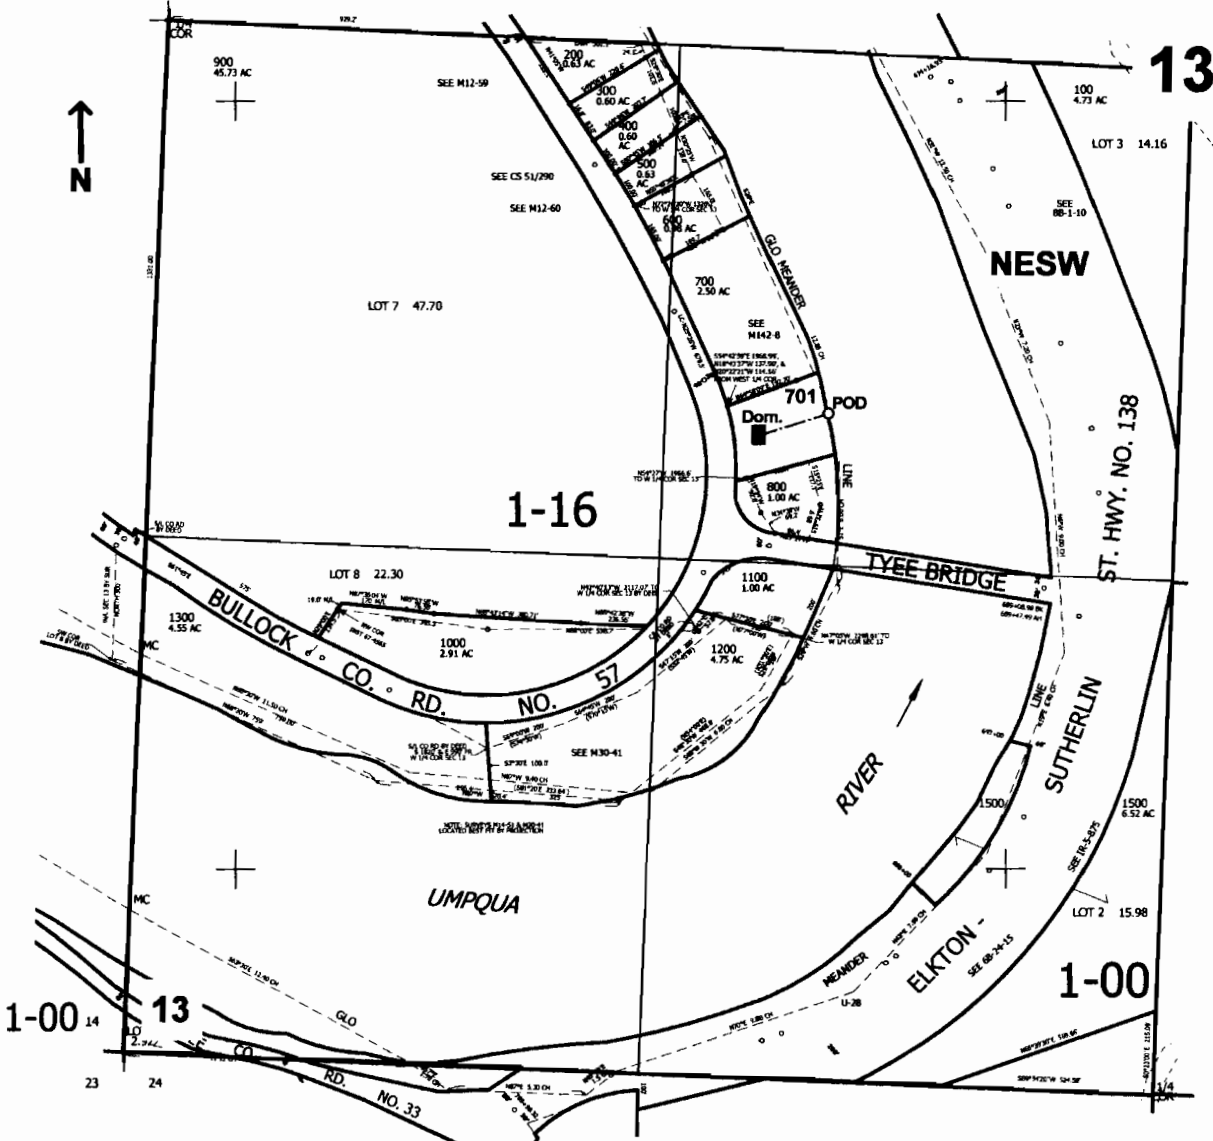

POD is located 895 ft. S. and 940 ft. W. from the center of Sec. 13

RECEIVED
DEC 19 2007
WATER RESOURCES DEPT
SALEM OREGON