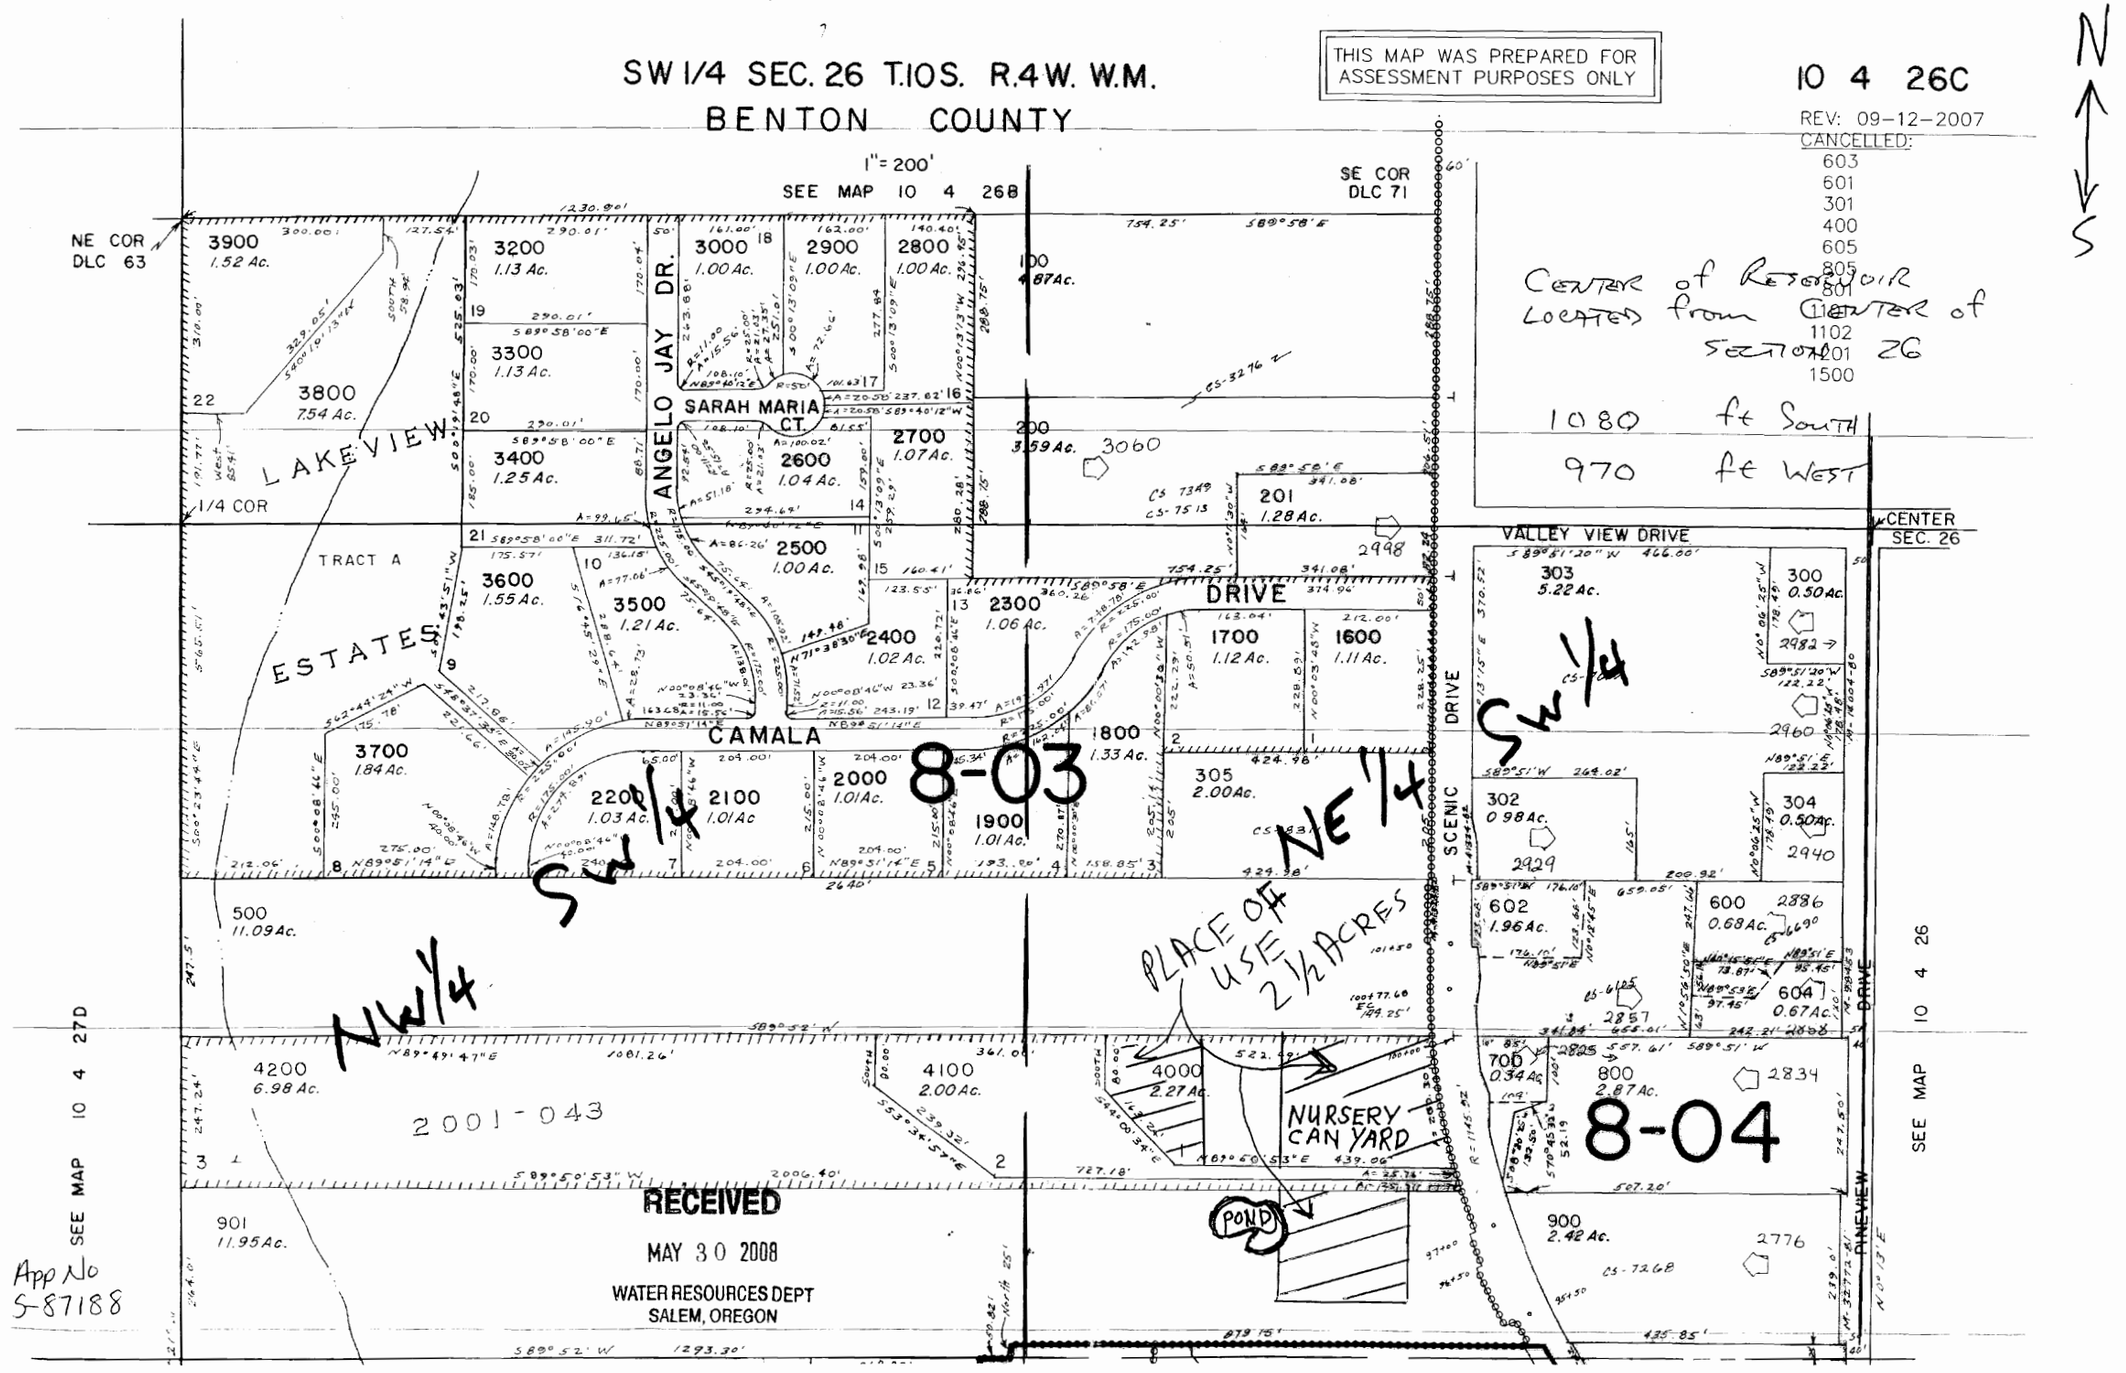
SW 1/4 SEC. 26 T.10S. R.4W. W.M.
BENTON COUNTY
THIS MAP WAS PREPARED FOR ASSESSMENT PURPOSES ONLY
10 4 26C
REV: 09-12-2007
CANCELLED:
603
601
301
400
605
805
801
1102
1201
1500
1" = 200'
SEE MAP 10 4 26B
SE COR DLC 71
NE COR DLC 63
1/4 COR
CENTER SEC. 26
Center of Reservoir Located from Center of Section 26
1080 ft South
970 ft West
LAKEVIEW ESTATES
TRACT A
ANGELO JAY DR.
SARAH MARIA CT.
CAMALA DRIVE
VALLEY VIEW DRIVE
SCENIC DRIVE
LAKEVIEW DRIVE
3900 1.52 Ac.
3200 1.13 Ac.
3300 1.13 Ac.
3800 7.54 Ac.
3400 1.25 Ac.
3600 1.55 Ac.
3500 1.21 Ac.
3700 1.84 Ac.
3000 1.00 Ac.
2900 1.00 Ac.
2800 1.00 Ac.
2700 1.07 Ac.
2600 1.04 Ac.
2500 1.00 Ac.
2400 1.02 Ac.
2300 1.06 Ac.
2200 1.03 Ac.
2100 1.01 Ac.
2000 1.01 Ac.
1900 1.01 Ac.
1800 1.33 Ac.
1700 1.12 Ac.
1600 1.11 Ac.
100 4.87 Ac.
200 3.59 Ac.
201 1.28 Ac.
303 5.22 Ac.
305 2.00 Ac.
302 0.98 Ac.
300 0.50 Ac.
304 0.50 Ac.
602 1.96 Ac.
600 0.68 Ac.
604 0.67 Ac.
700 0.34 Ac.
800 2.87 Ac.
900 2.42 Ac.
500 11.09 Ac.
4200 6.98 Ac.
4100 2.00 Ac.
4000 2.27 Ac.
901 11.95 Ac.
3060
2998
2982
2960
2940
2929
2886
2857
2834
2825
2776
8-03
8-04
SW 1/4
NE 1/4
NW 1/4
PLACE OF USE 2½ ACRES
NURSERY CAN YARD
POND
2001-043
RECEIVED
MAY 30 2008
WATER RESOURCES DEPT
SALEM, OREGON
App No S-87188
SEE MAP 10 4 27D
SEE MAP 10 4 26
N
S