

SPRING LOCATED FROM SE CORNER SECTION 24
 100 FE WEST
 10 FE NORTH




RECEIVED

NOV 09 2007

WATER RESOURCES DEPT
 SALEM, OREGON

unnamed Spring
 For:
 Marcia J. McBeth
 11545 Burbank Rd
 monmouth, OR 97361
 TAX Lot 200

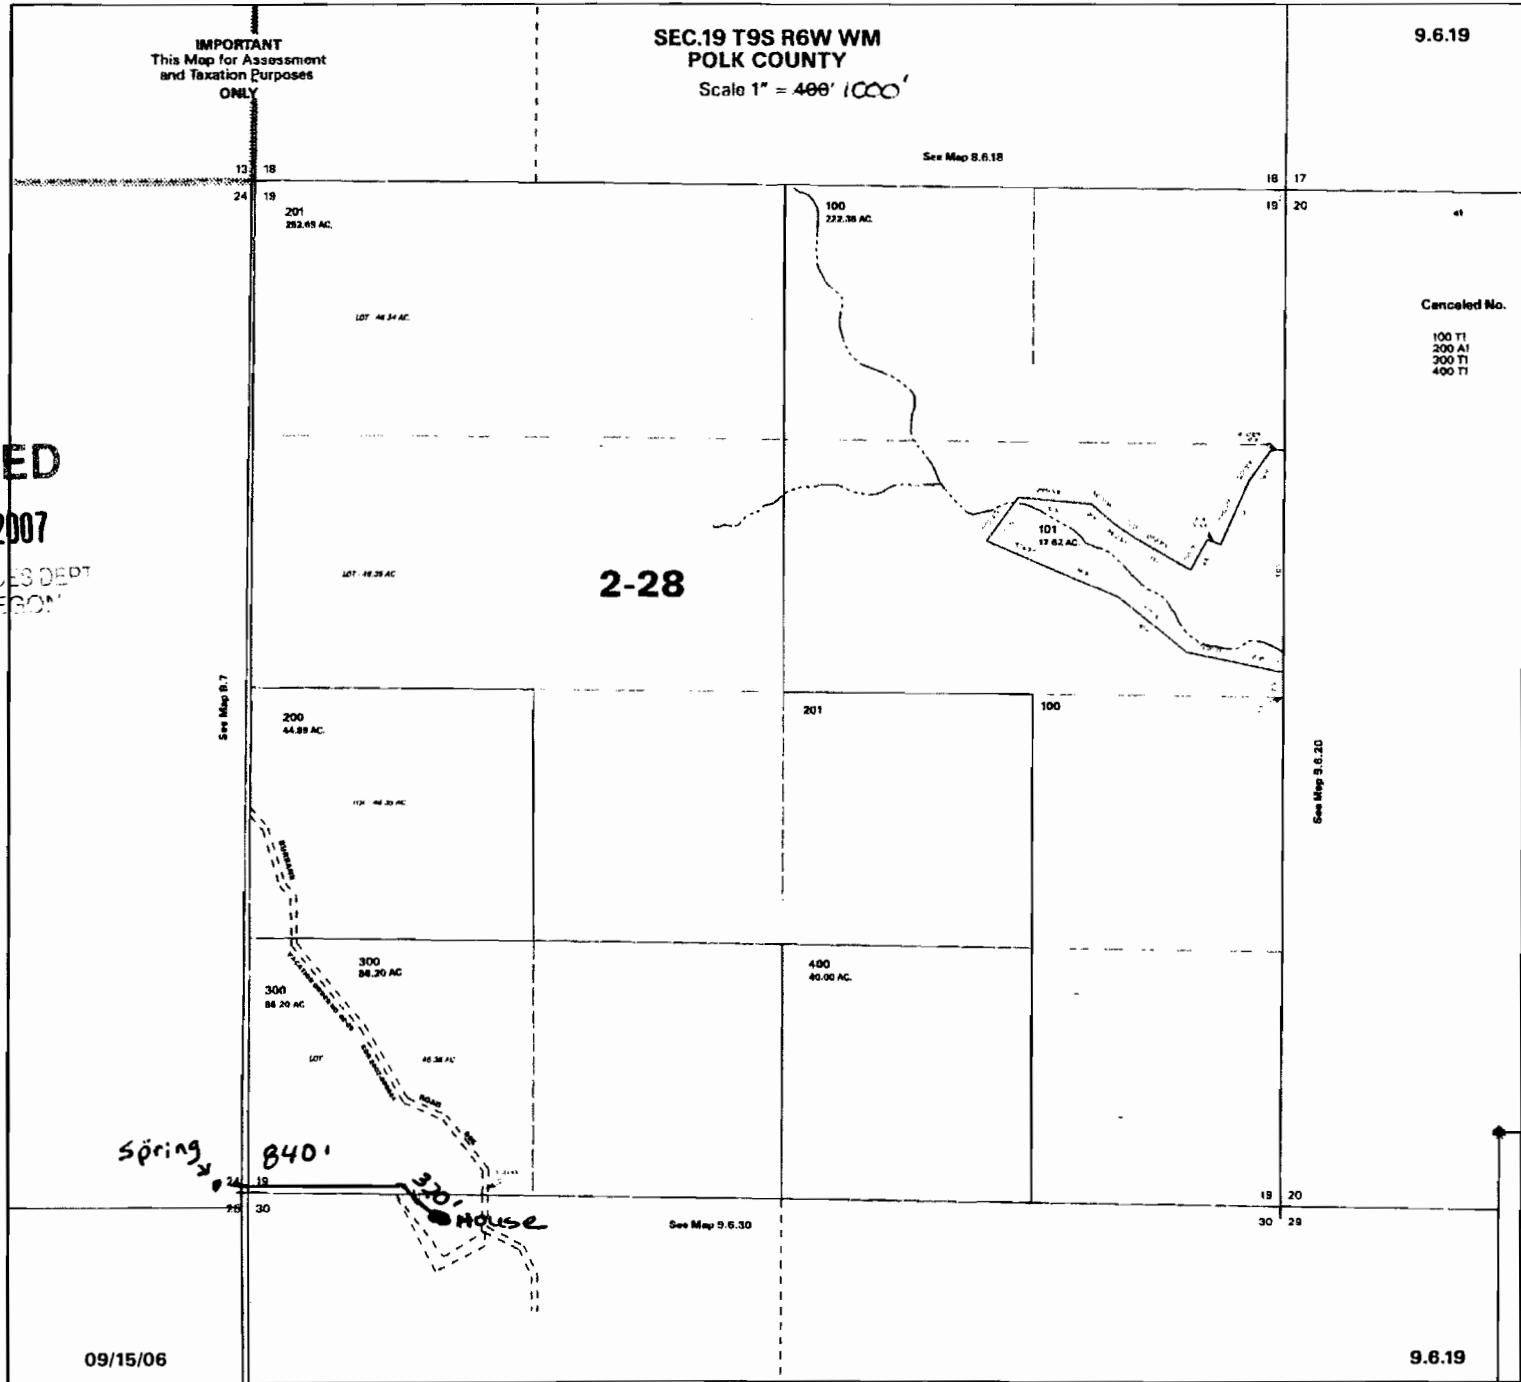

App No S-8 70S 2