

THIS MAP WAS PREPARED FOR  
ASSESSMENT PURPOSE ONLY

TILLAMOOK COUNTY  
1320'

IN 9 31

THIS MAP  
ASSESSOR

SEE MAP IN 9

CANCELLED NO.  
200


APPROX REVISED  
ADJUSTED SCALE  
1" = 1000 FEET.

RECEIVED

NOV 24 2000

72

72

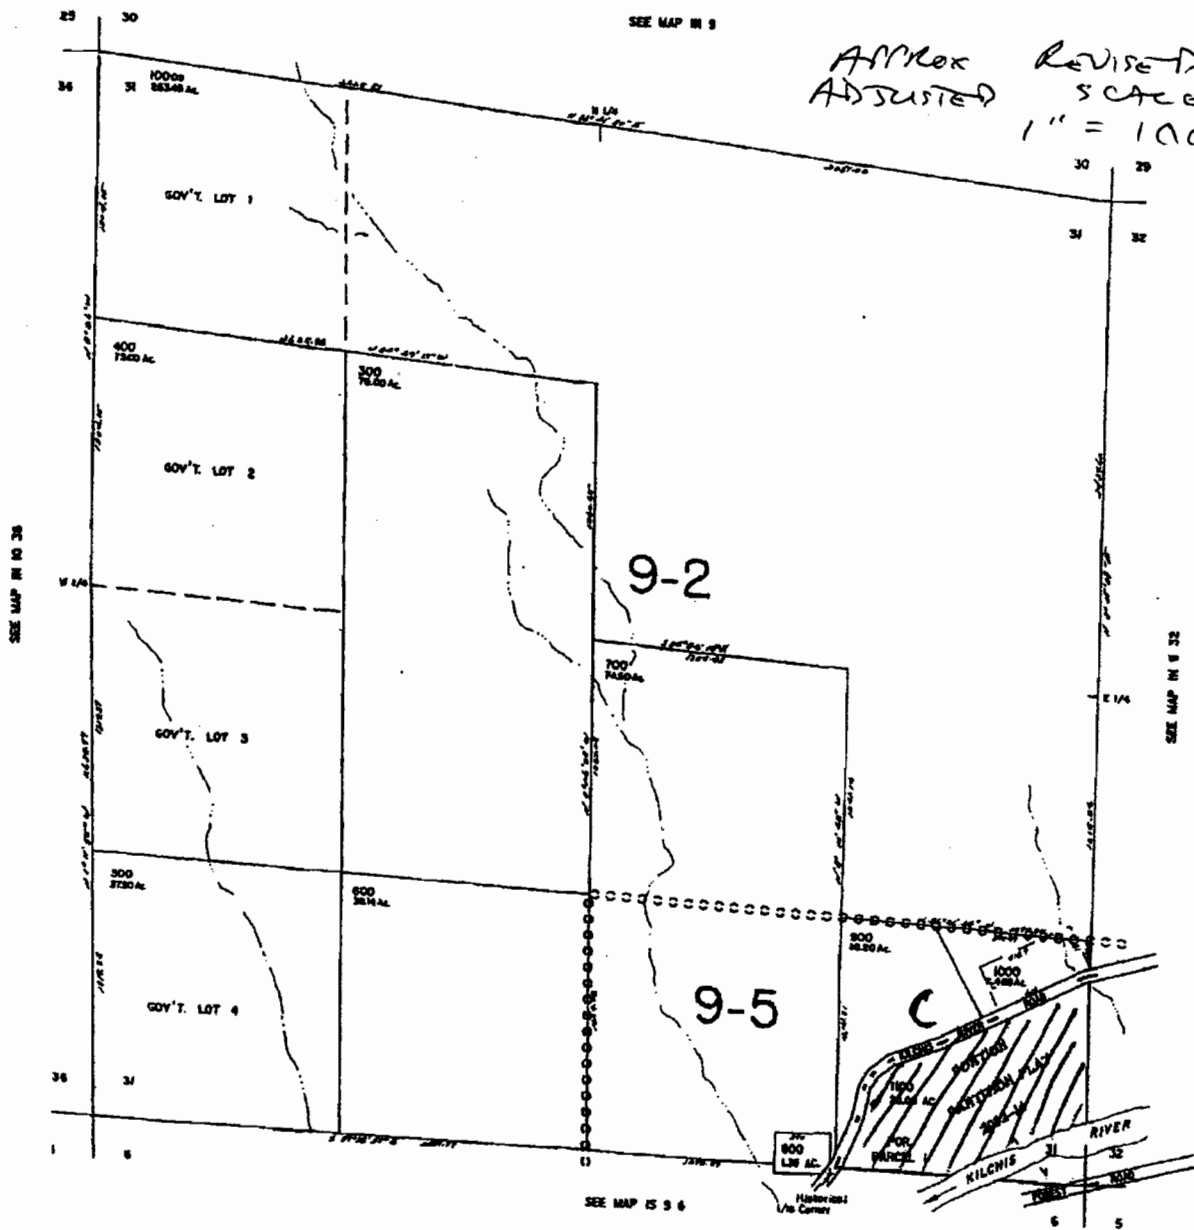

SEE MAP IN 9 6

IN 9 31

REVISED 10/21/02. KA


THIS MAP WAS PREPARED FOR  
ASSESSMENT PURPOSE ONLY

SECTION 32 T.1N. R.9W. W.M.  
TILLAMOOK COUNTY

IN 9 32

AMCOX COLLECTED  
REVISED SCALE  
1" = 1000 FEET

SEE MAP IN 9

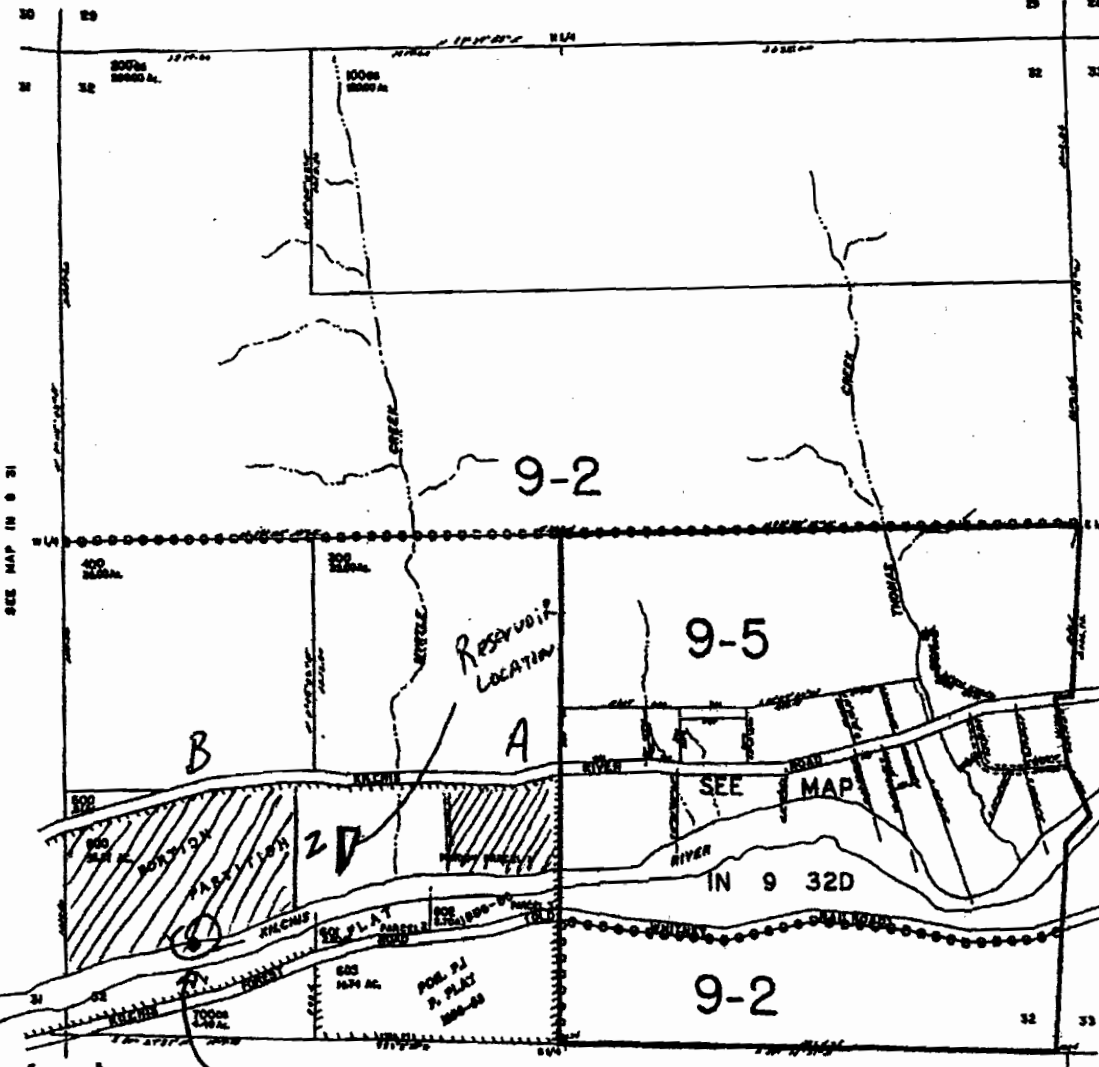

CANCELLED NO.

- 800
- 801
SEE MAP IN 9 32

Z-Reservoir Location-

Acres to be irrigated

A - 6.2 acres

B - 23.8 acres

C - 20 acres

Point of Diversion - 300 ft N. + 1700' E SE/SW 32 IN 9W

IN 9 32

REVISED 06/26/01, LA