

SPRING LOCATED FROM SE CORNER
SECTION 24
100 FE WEST
10 FE NORTH



RECEIVED

NOV 09 2007


WATER RESOURCES DEPT
SALEM, OREGON

unnamed Spring

For:

Marcia J. McBeth
11545 Burbank Rd
Monmouth, OR 97361

Tax Lot 200

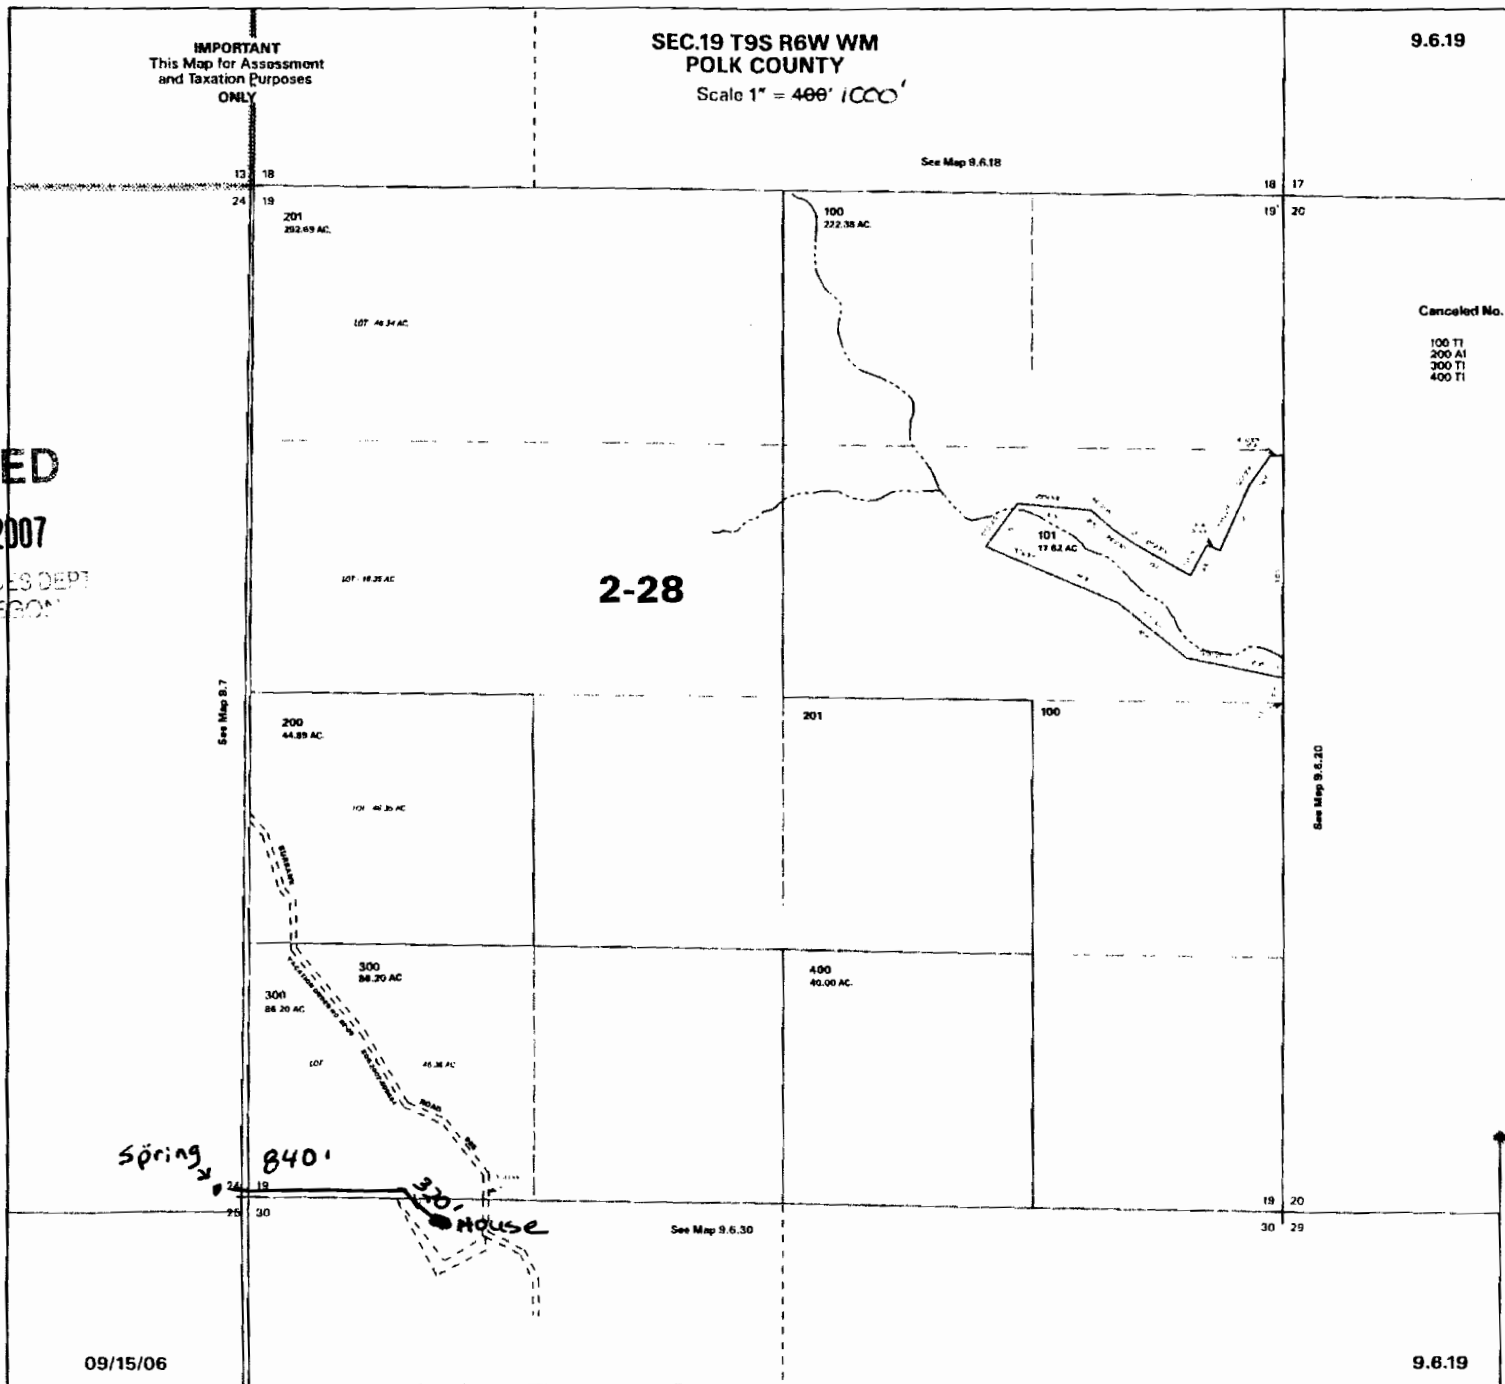

App No S-87057 Permit No S-54528