S-87356
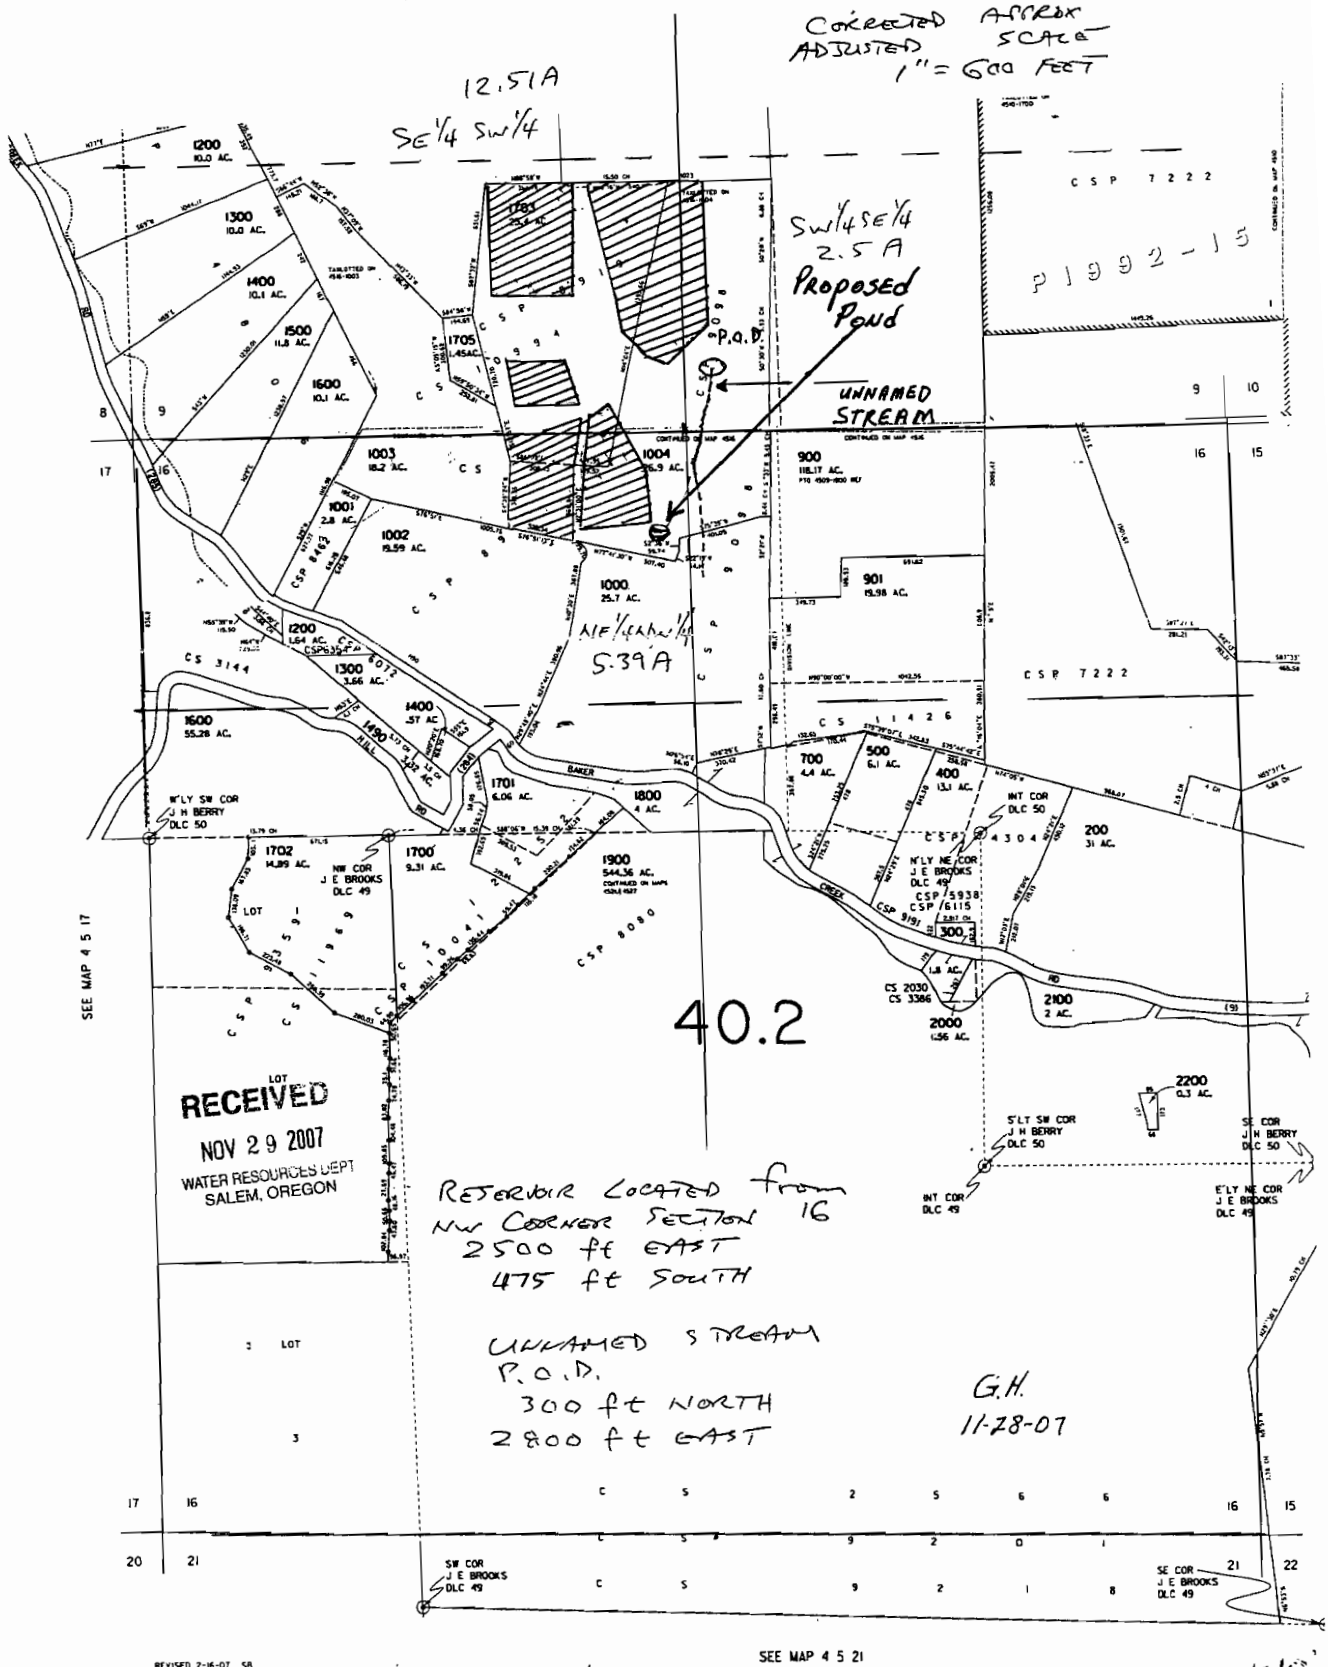
SECTION 9 T4S R5W W.M.
YAMHILL COUNTY