


T. 29 S. R. 6W. Sec. 11

DOUGLAS COUNTY  
Scale 1" = 1000'

RECEIVED

OCT 20 2009

WATER RESOURCES DEPT  
SALEM, OREGON

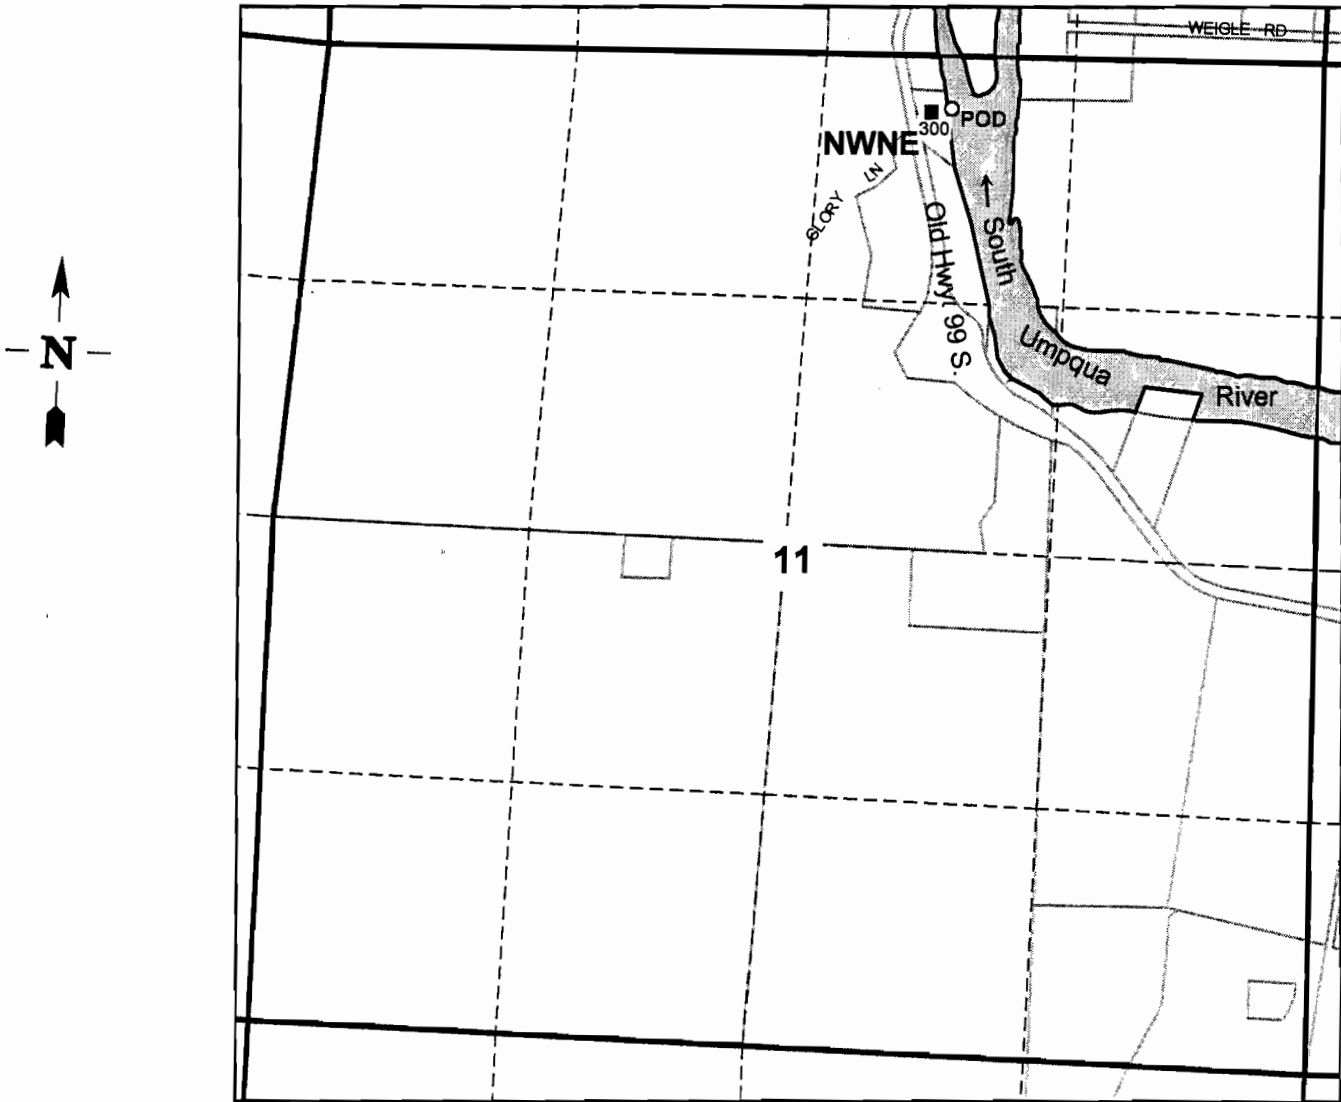

POD located 272 ft. S. and 631 ft. E. from the  
North Quarter Corner of Section 11.