

~~Nov 14, 2008~~  
JAN 21, 2010

# Application MAP for DARYL ROBISON to use stored water **John P. Prahar** LAND PLANNING AND SURVEYING

JUL - 9 1331

WATER RESOURCES DEPT  
SALEM, OREGON


Fern Park Building, Suite 1 • 1045 Baltimore Ave. • Bandon, Oregon 97411 • (503) 347 9517

~~R 64482~~ R 87351

Application No. ~~14766~~

Permit No. ~~14766~~ ~~14766~~

R-14766 Section 33 T31S R15W W.M TL1400

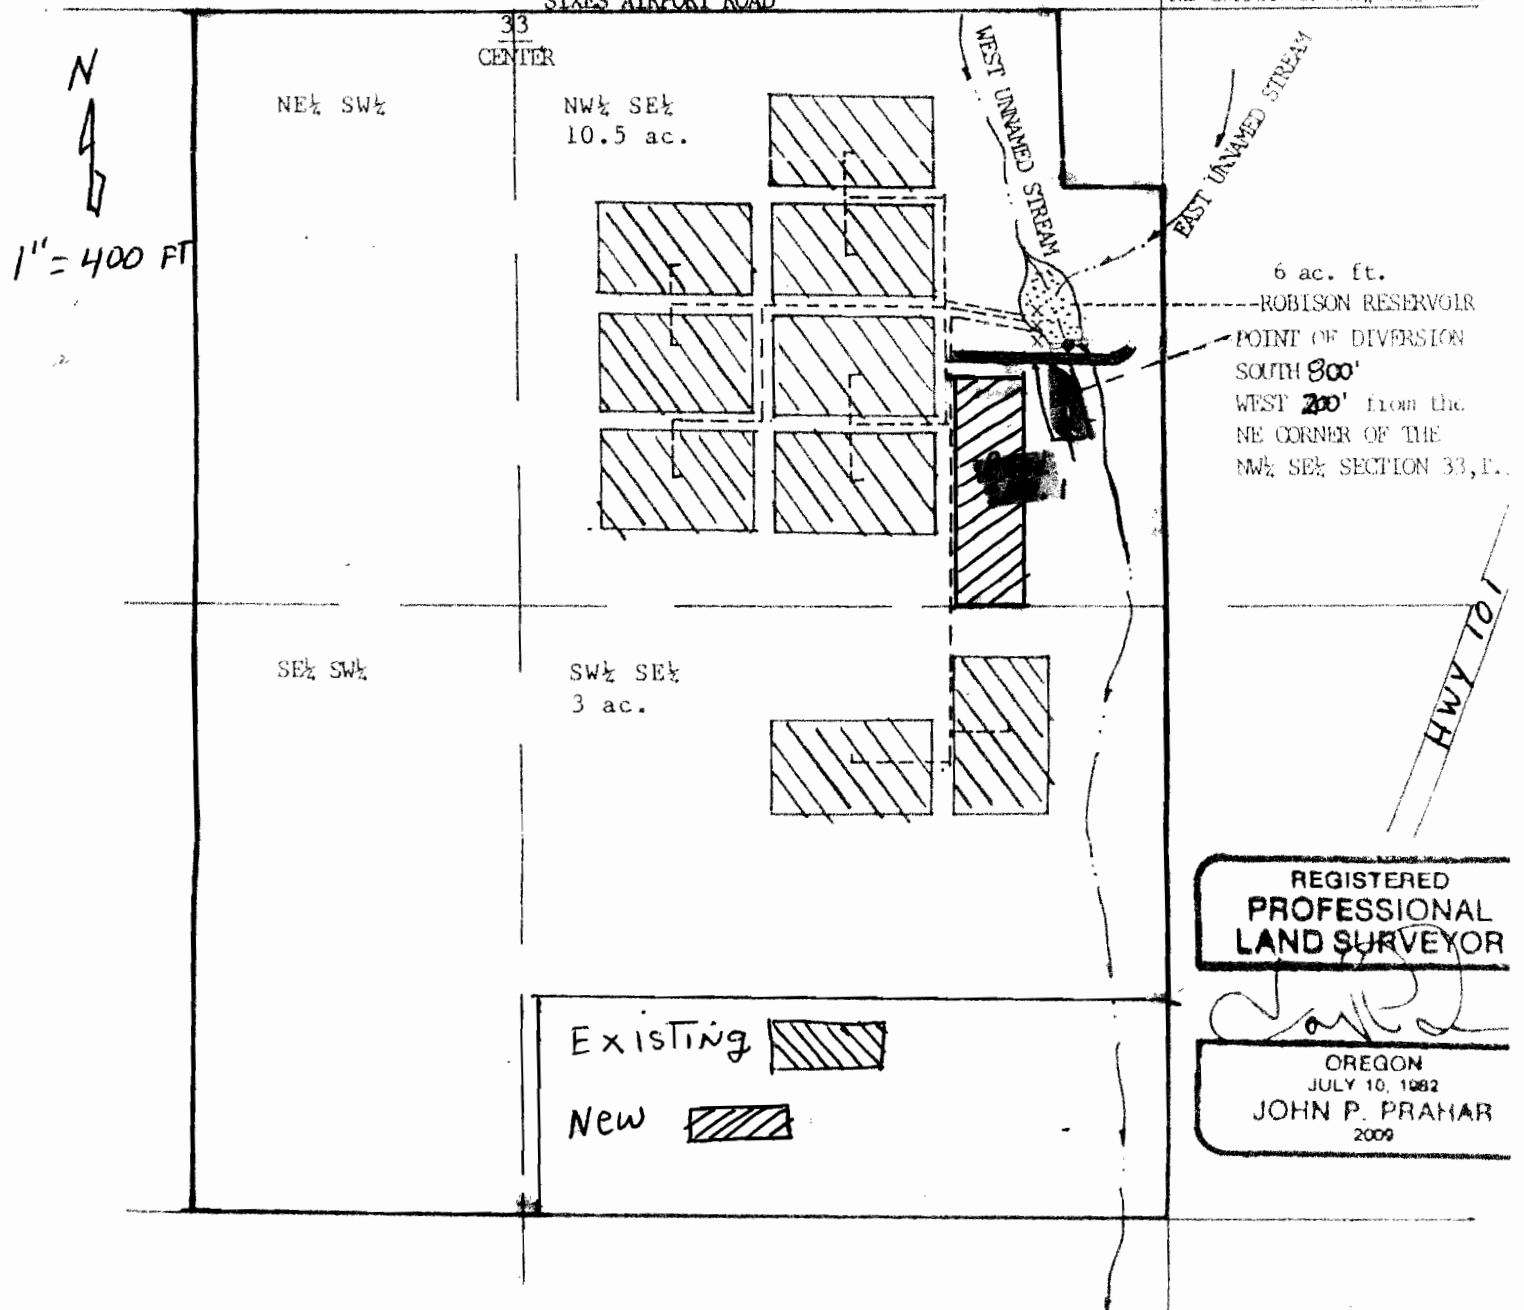

REGISTERED  
PROFESSIONAL  
LAND SURVEYOR

*John P. Prahar*  
OREGON  
JULY 10, 1982  
JOHN P. PRAHAR  
2009

**RECEIVED**

MAP FOR ADDITION TO APPROPRIATE SURFACE WATER AND CONSTRUCTION PERMITS

JAN 25 2010

WATER RESOURCES DEPT  
SALEM, OREGON