


T. 25S. R. 6W. W.M.
Douglas County
Scale 1" = 1000 ft.

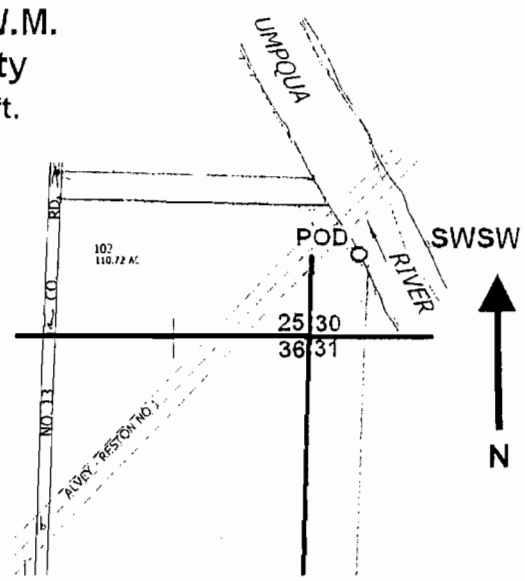

POD located 410 ft. N. and 210 ft. E. from the SW corner of Sec. 30.

RECEIVED

APR 29 2009

WATER RESOURCES DEPT
SALEM, OREGON

T. 25S. R. 7W. W.M.
Douglas County
Scale 1" = 1000 ft.

