

THIS MAP WAS PREPARED FOR ASSESSMENT PURPOSE ONLY

SW 1/4 SEC. 25 T.24S. R.11W. W.M. COOS COUNTY

CORRECTED ADJUSTED APPRox SCALE 1" = 400 FEET


24 11 25C & INDEX CANCELLED 601

Appl. 5-87557

SEE MAP 24 11 25

CEN. SEC.

From POD - 40 ft of 1" pipe to pump house/storage tank (2500 gal). Pressure air tank feeds to 1" pipe 50 ft in length to house.

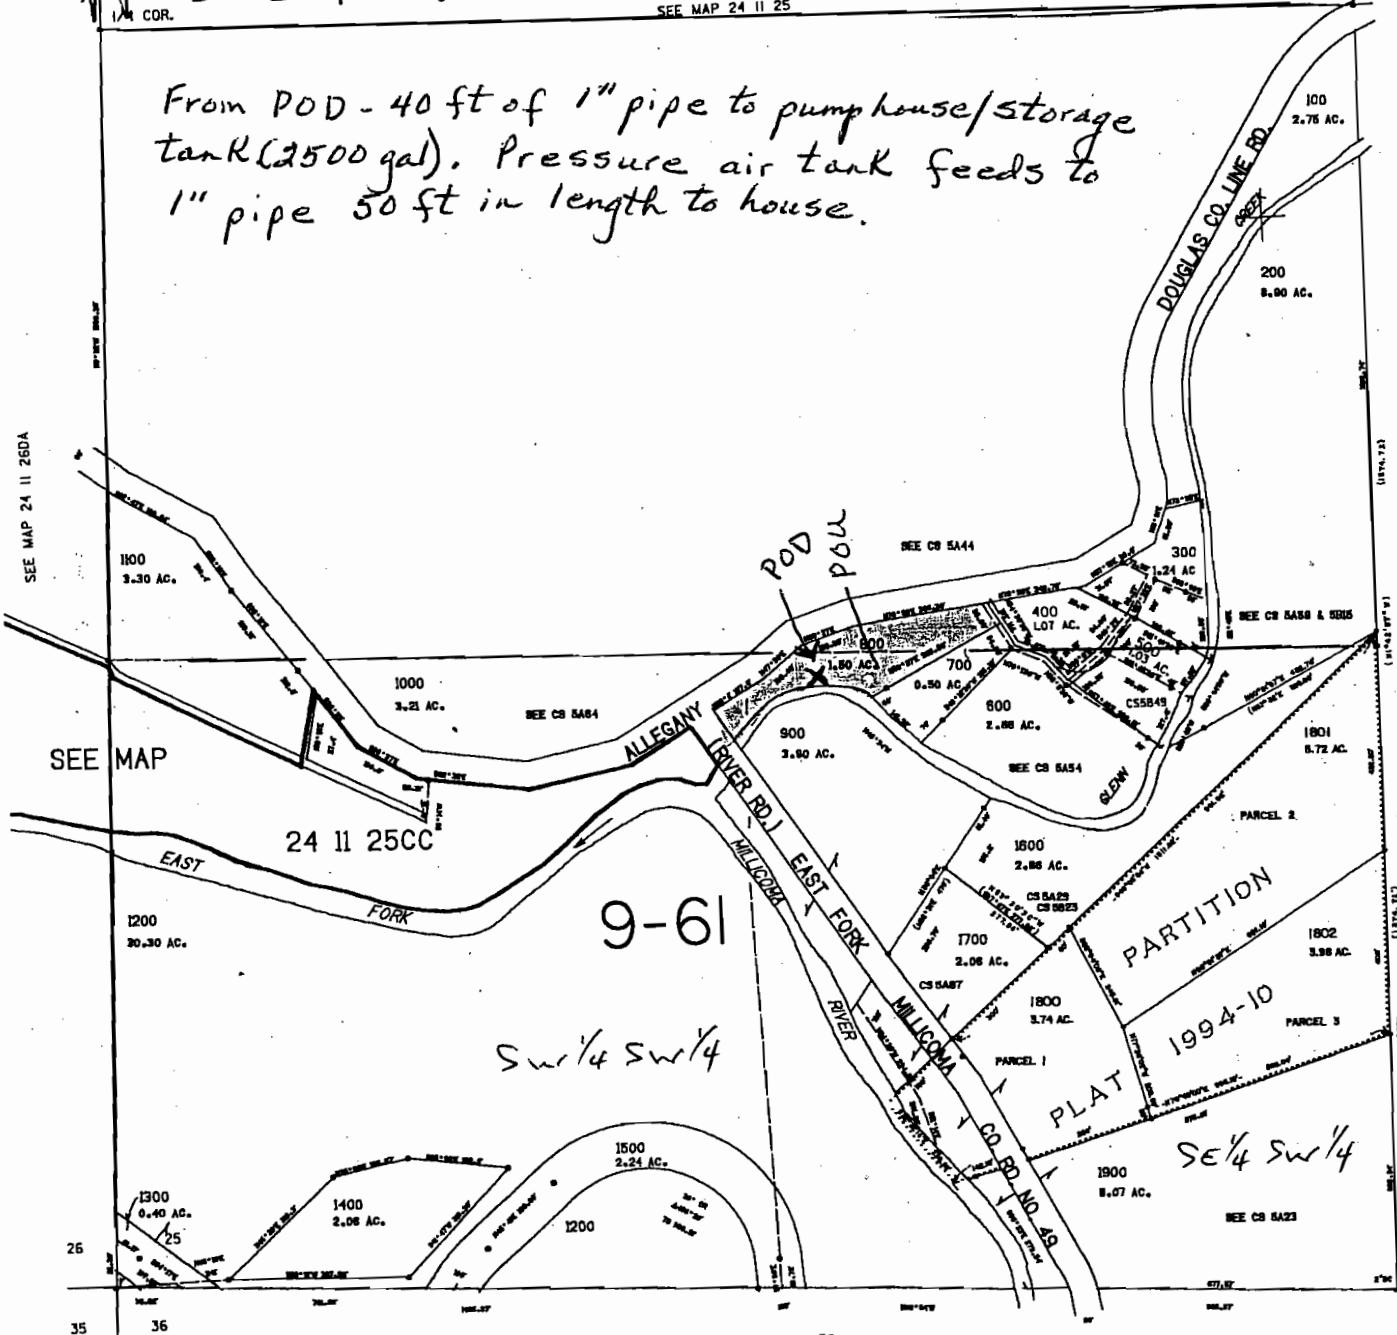

RECEIVED

Tax Lot # 800

SEE MAP 24 11 25

9-61

SW 1/4 SW 1/4

PARTITION PLAT 1994-10

SE 1/4 SW 1/4

POD LOCATED from SW CORNER SECTION 25

1475 ft EAST
1270 ft NORTH

SEE MAP 24 11 36

1/4 COR. 8-2-2004 24 11 25C