


APP # S.85481
Permit #

T. 19 S., R. 12 W., W.M.

Scale: 1" = 800'

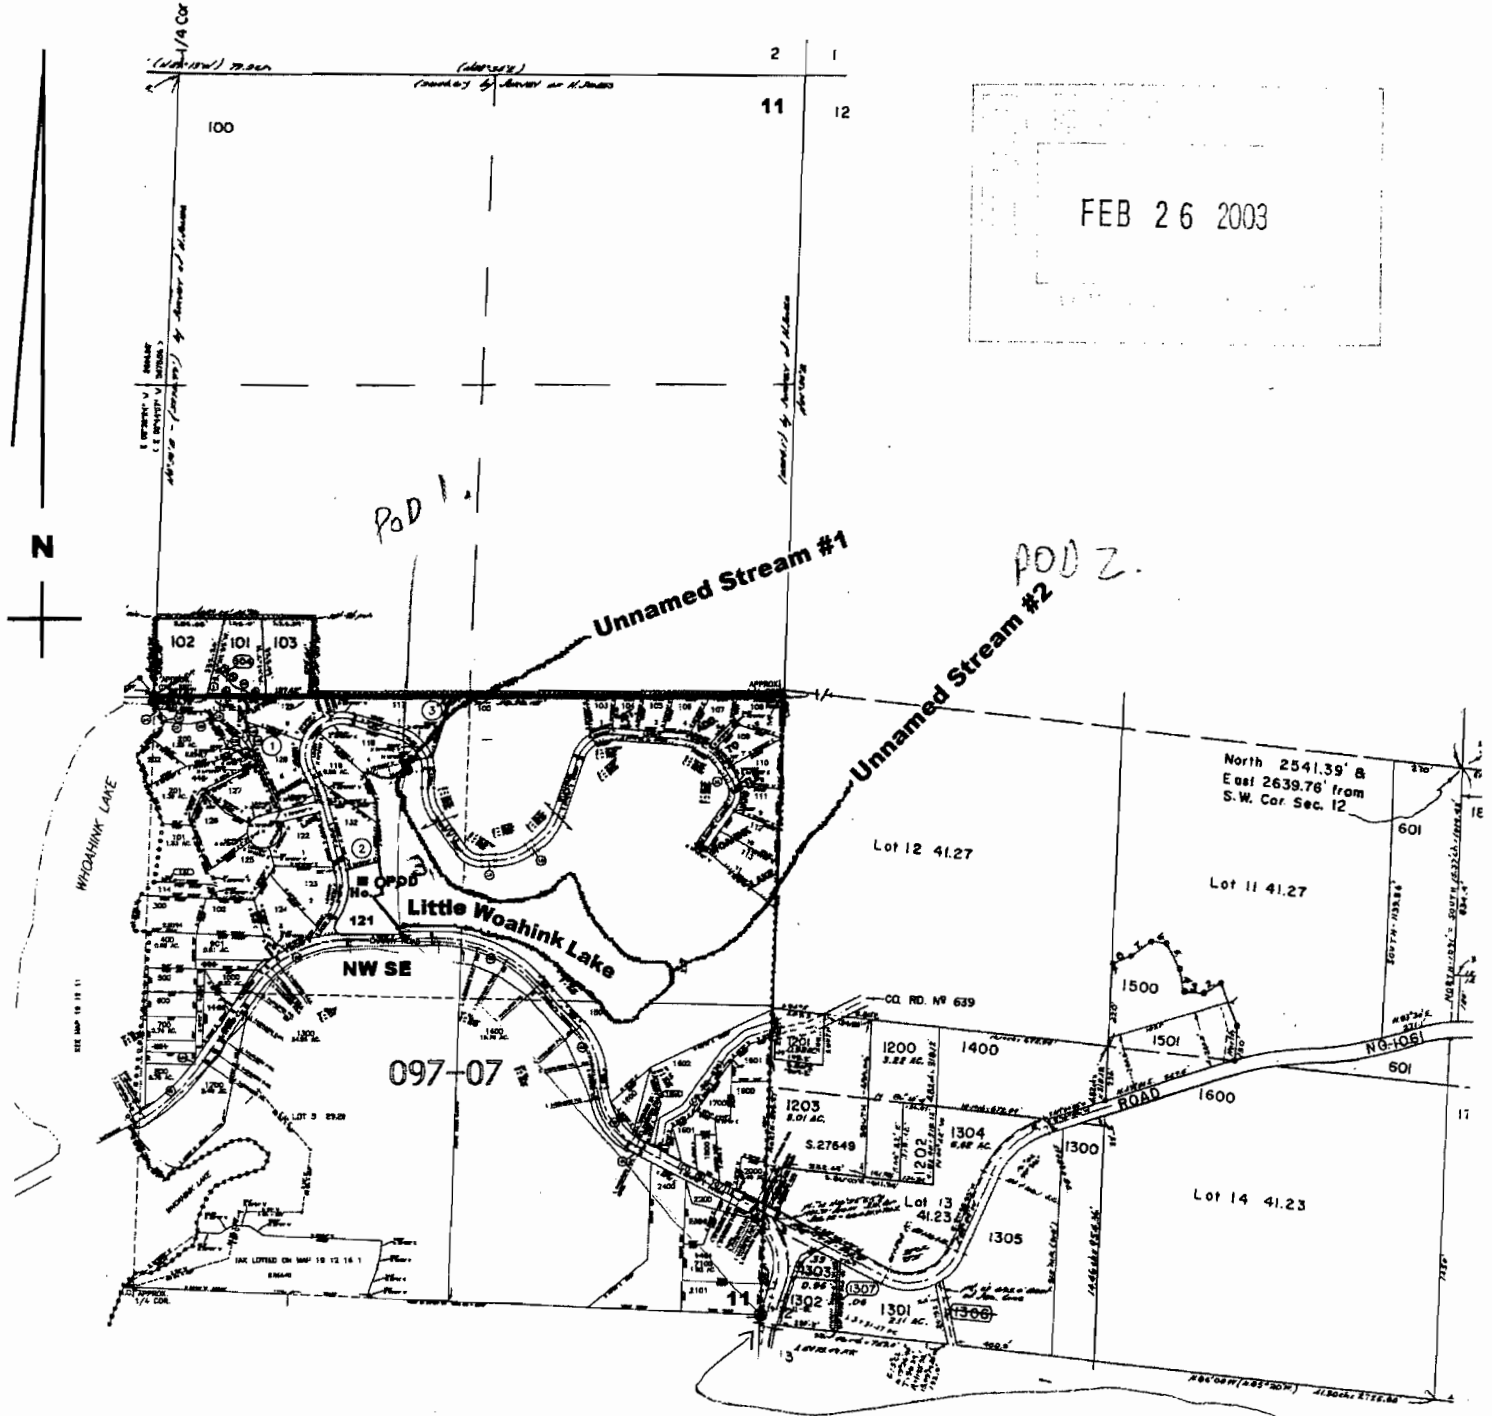

POD 3. POD is located 1760 ft. N. and 1660 ft. W. from the SE corner Sec. 11

POD #1. 1600' W & 300' E from SE corner Sec. 11
POD #2. 400' W & 1100' S from SE corner Sec. 11