


T295 R12W

15 14
22 23

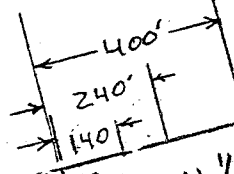

N 1/4 Corner


POD #1 (A SPRING)

NW 1/4 NE 1/4

POD #3

POD #2 (A SPRING)

NE 1/4 NW 1/4

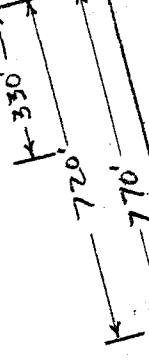

NW 1/4 NW 1/4

RECEIVED
MAR 16 2010
WATER RESOURCES DEPT
SALEM, OREGON

SW 1/4 NW 1/4

Mill Cr

SE 1/4 NE 1/4

P. Pipeline

From N 1/4 Cor Sec 23
POD's w/in NW 1/4 NE 1/4 Sec 23

POD #1	330'S	400'E
POD #2	770'S	240'E
POD #3	720'S	140'E



Scale
1" = 400'

NE 1/4 SE 1/4

J.P. Drolet / 08 MAR '10

S-87592

POU
Ho.

SE 1/4 SE 1/4

Guerin Lane

SW 1/4 SE 1/4