


SE1/4 SEC.14 T.26S. R.4W. W.M.
DOUGLAS COUNTY
Scale 1" = 500'

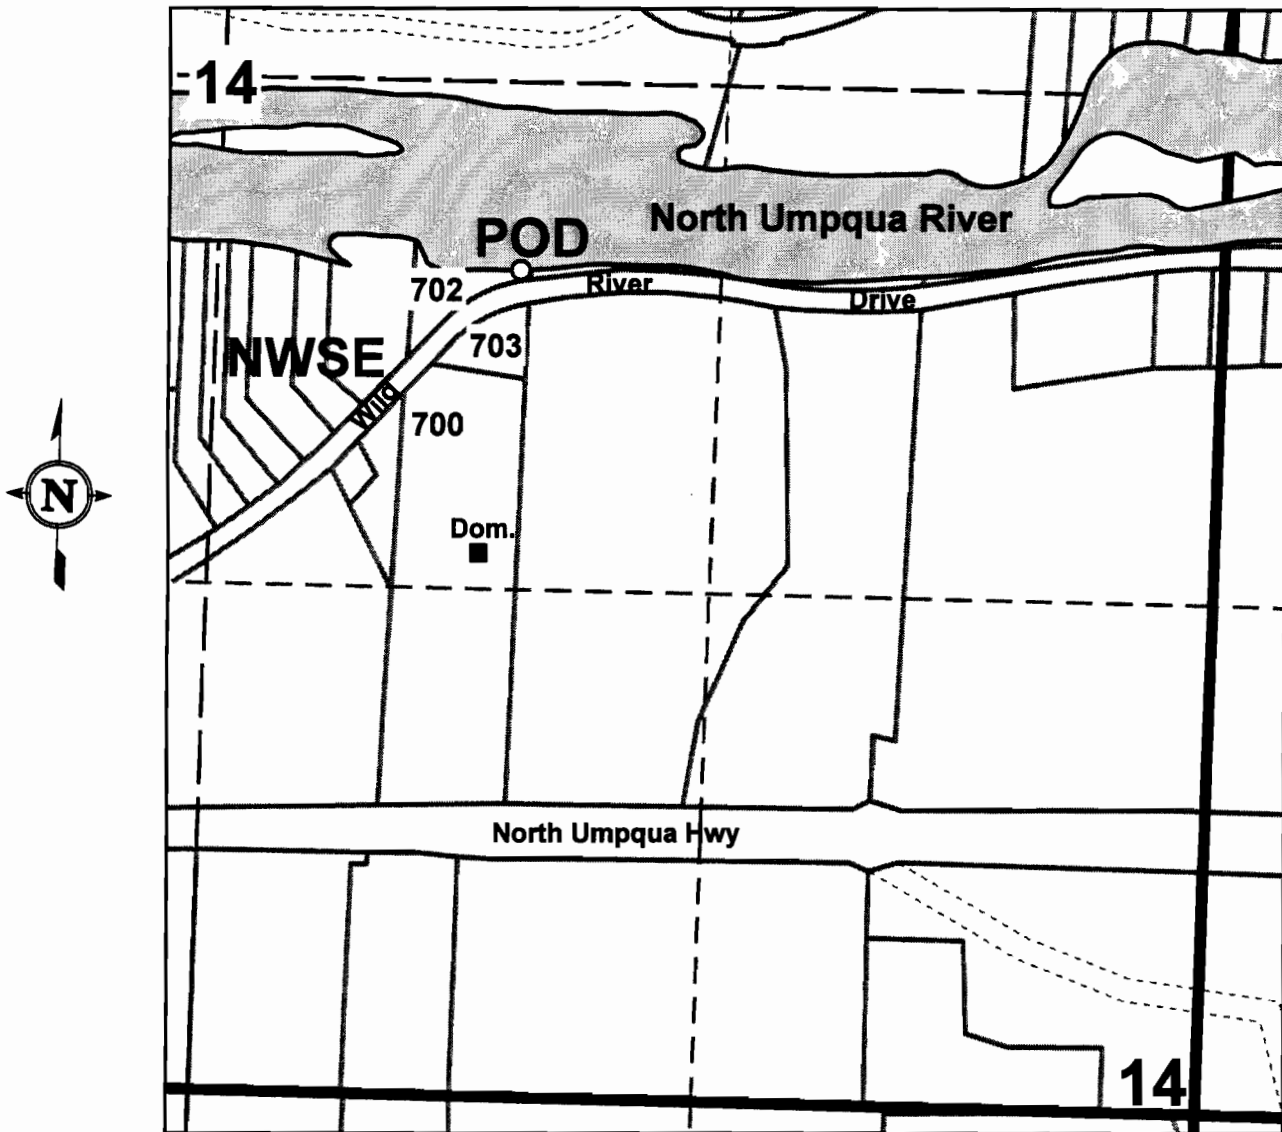

Point of Diversion is located 490 ft. South and
780 ft. East of the center of Section 14.

RECEIVED

JUL 6 7 2010

WATER RESOURCES DEPT
SALEM, OREGON

S- 87635