


RECEIVED
 APR 21 2011
 WATER RESOURCES DEPT
 SALEM, OREGON

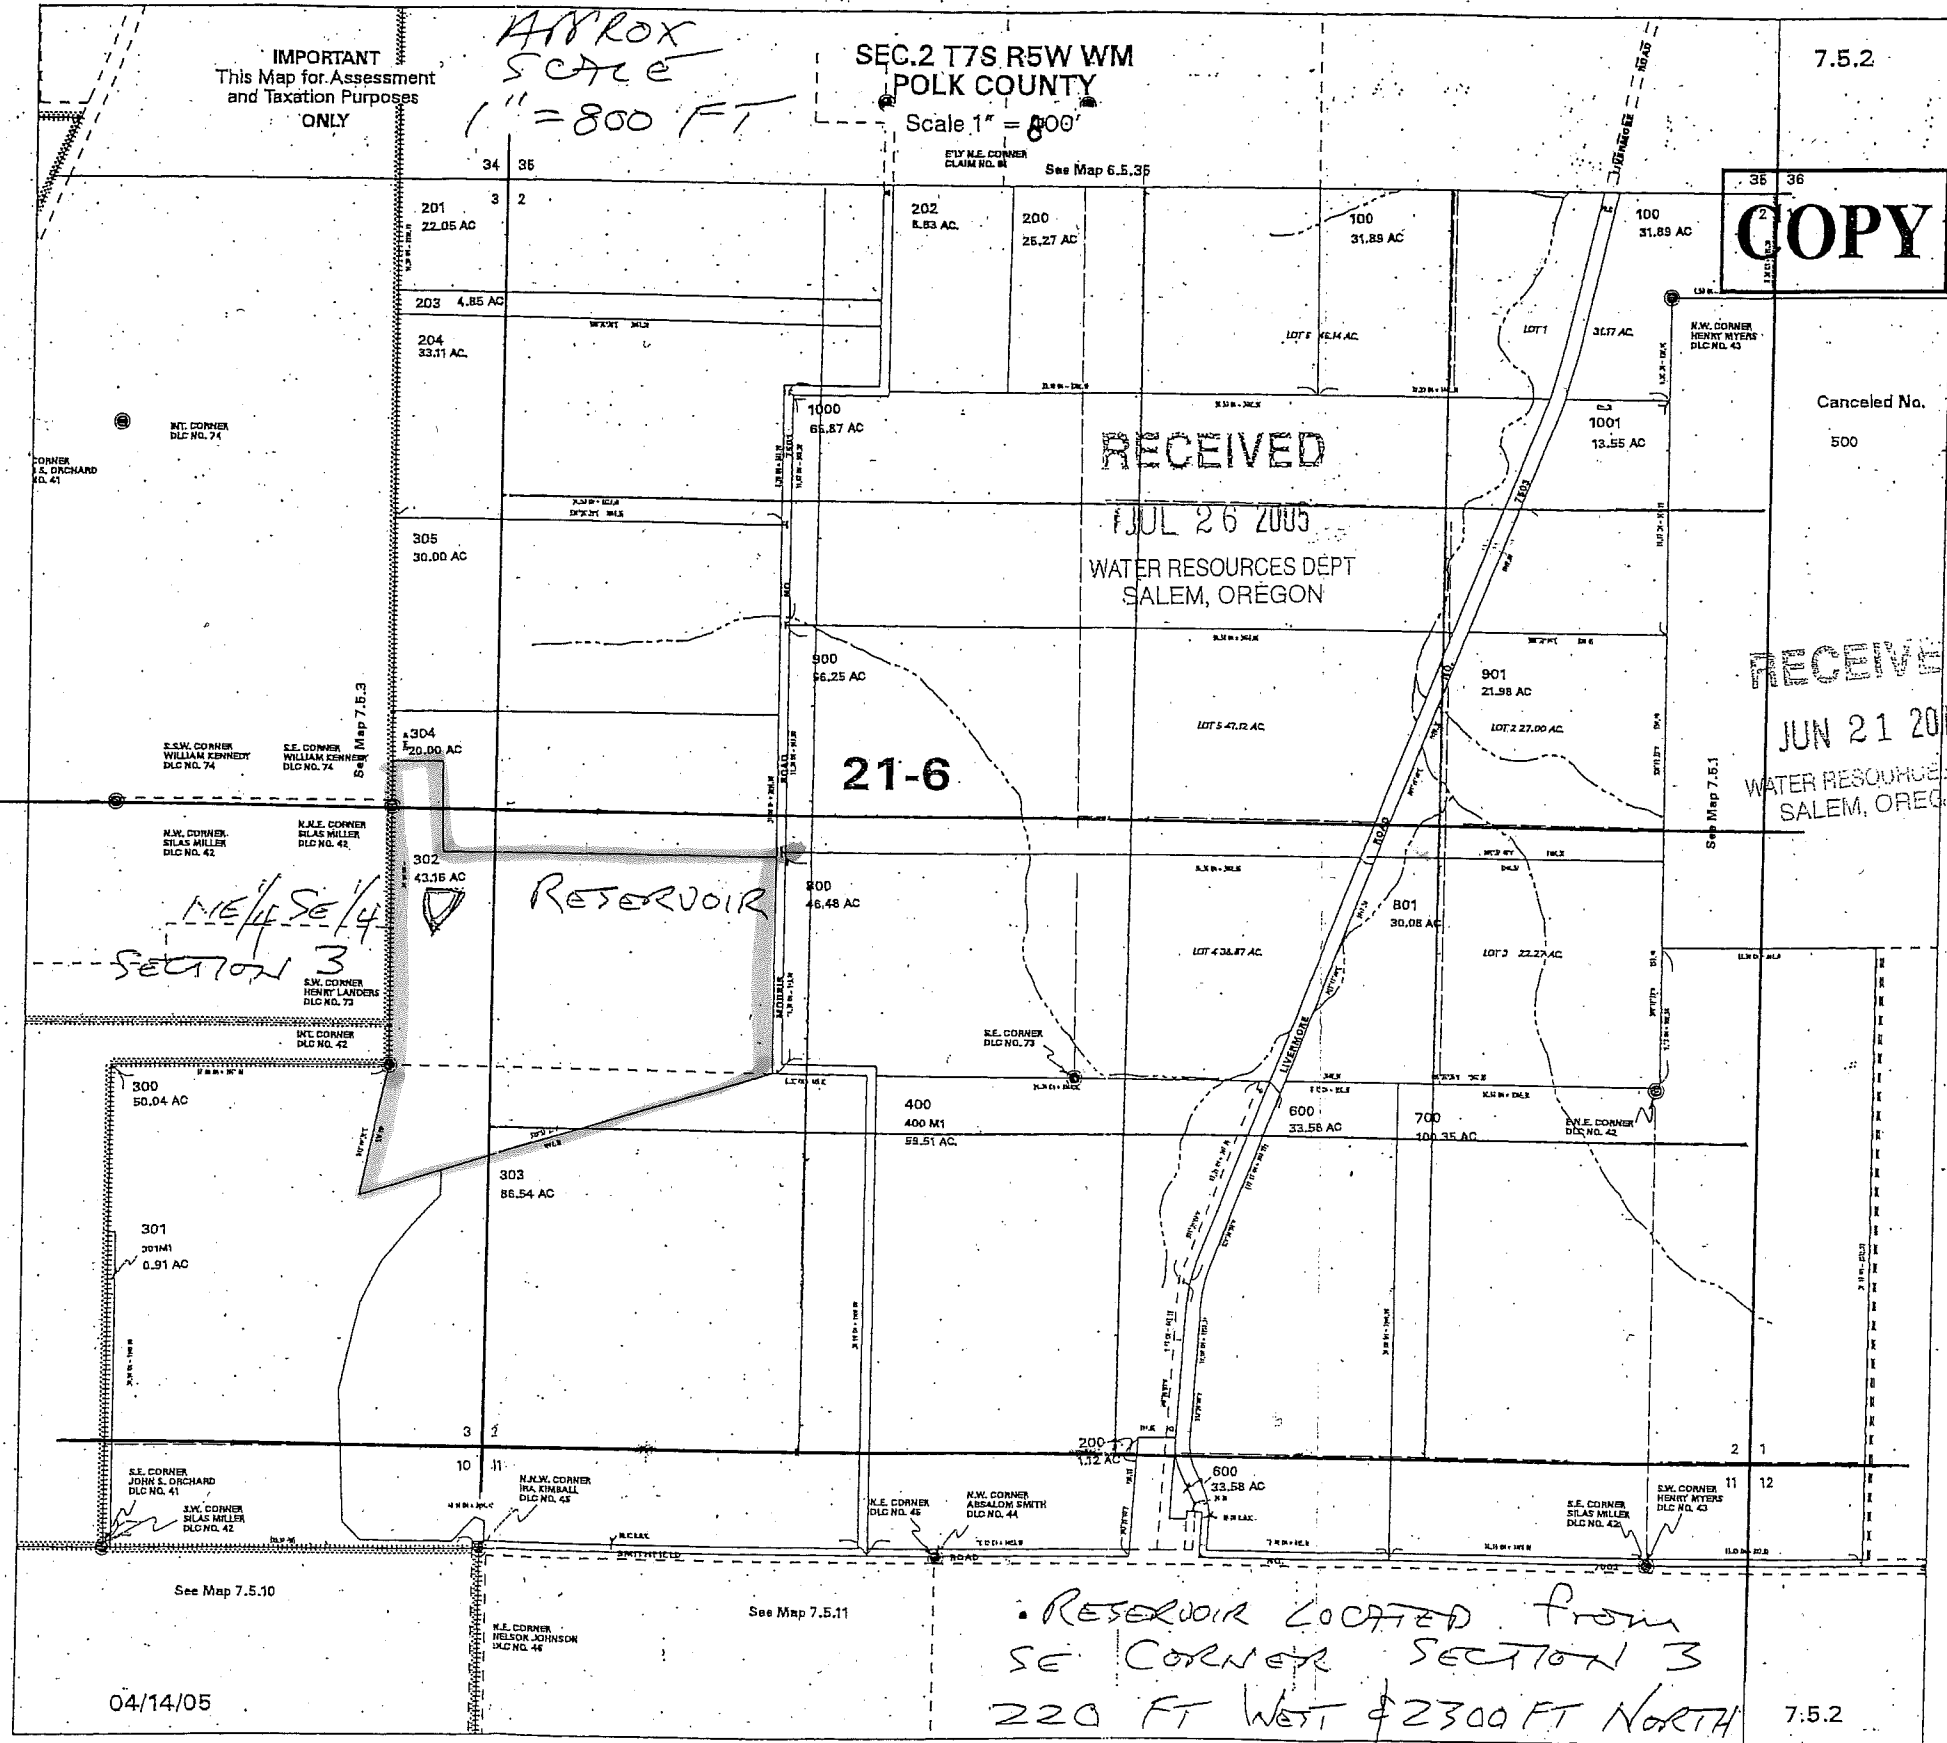

Tax Lot 302
 TOTAL of
 42 ACRES
 IRRIGATION

KCS 4/21/11

SECTION 2
 NW 1/4 SW 1/4
 27.5 A
 SW 1/4 SW 1/4
 0.5 A

SECTION 3
 NE 1/4 SE 1/4
 9.0 A
 SE 1/4 SE 1/4
 4.0 A
 SE 1/4 NE 1/4
 1.0 A

S-87715