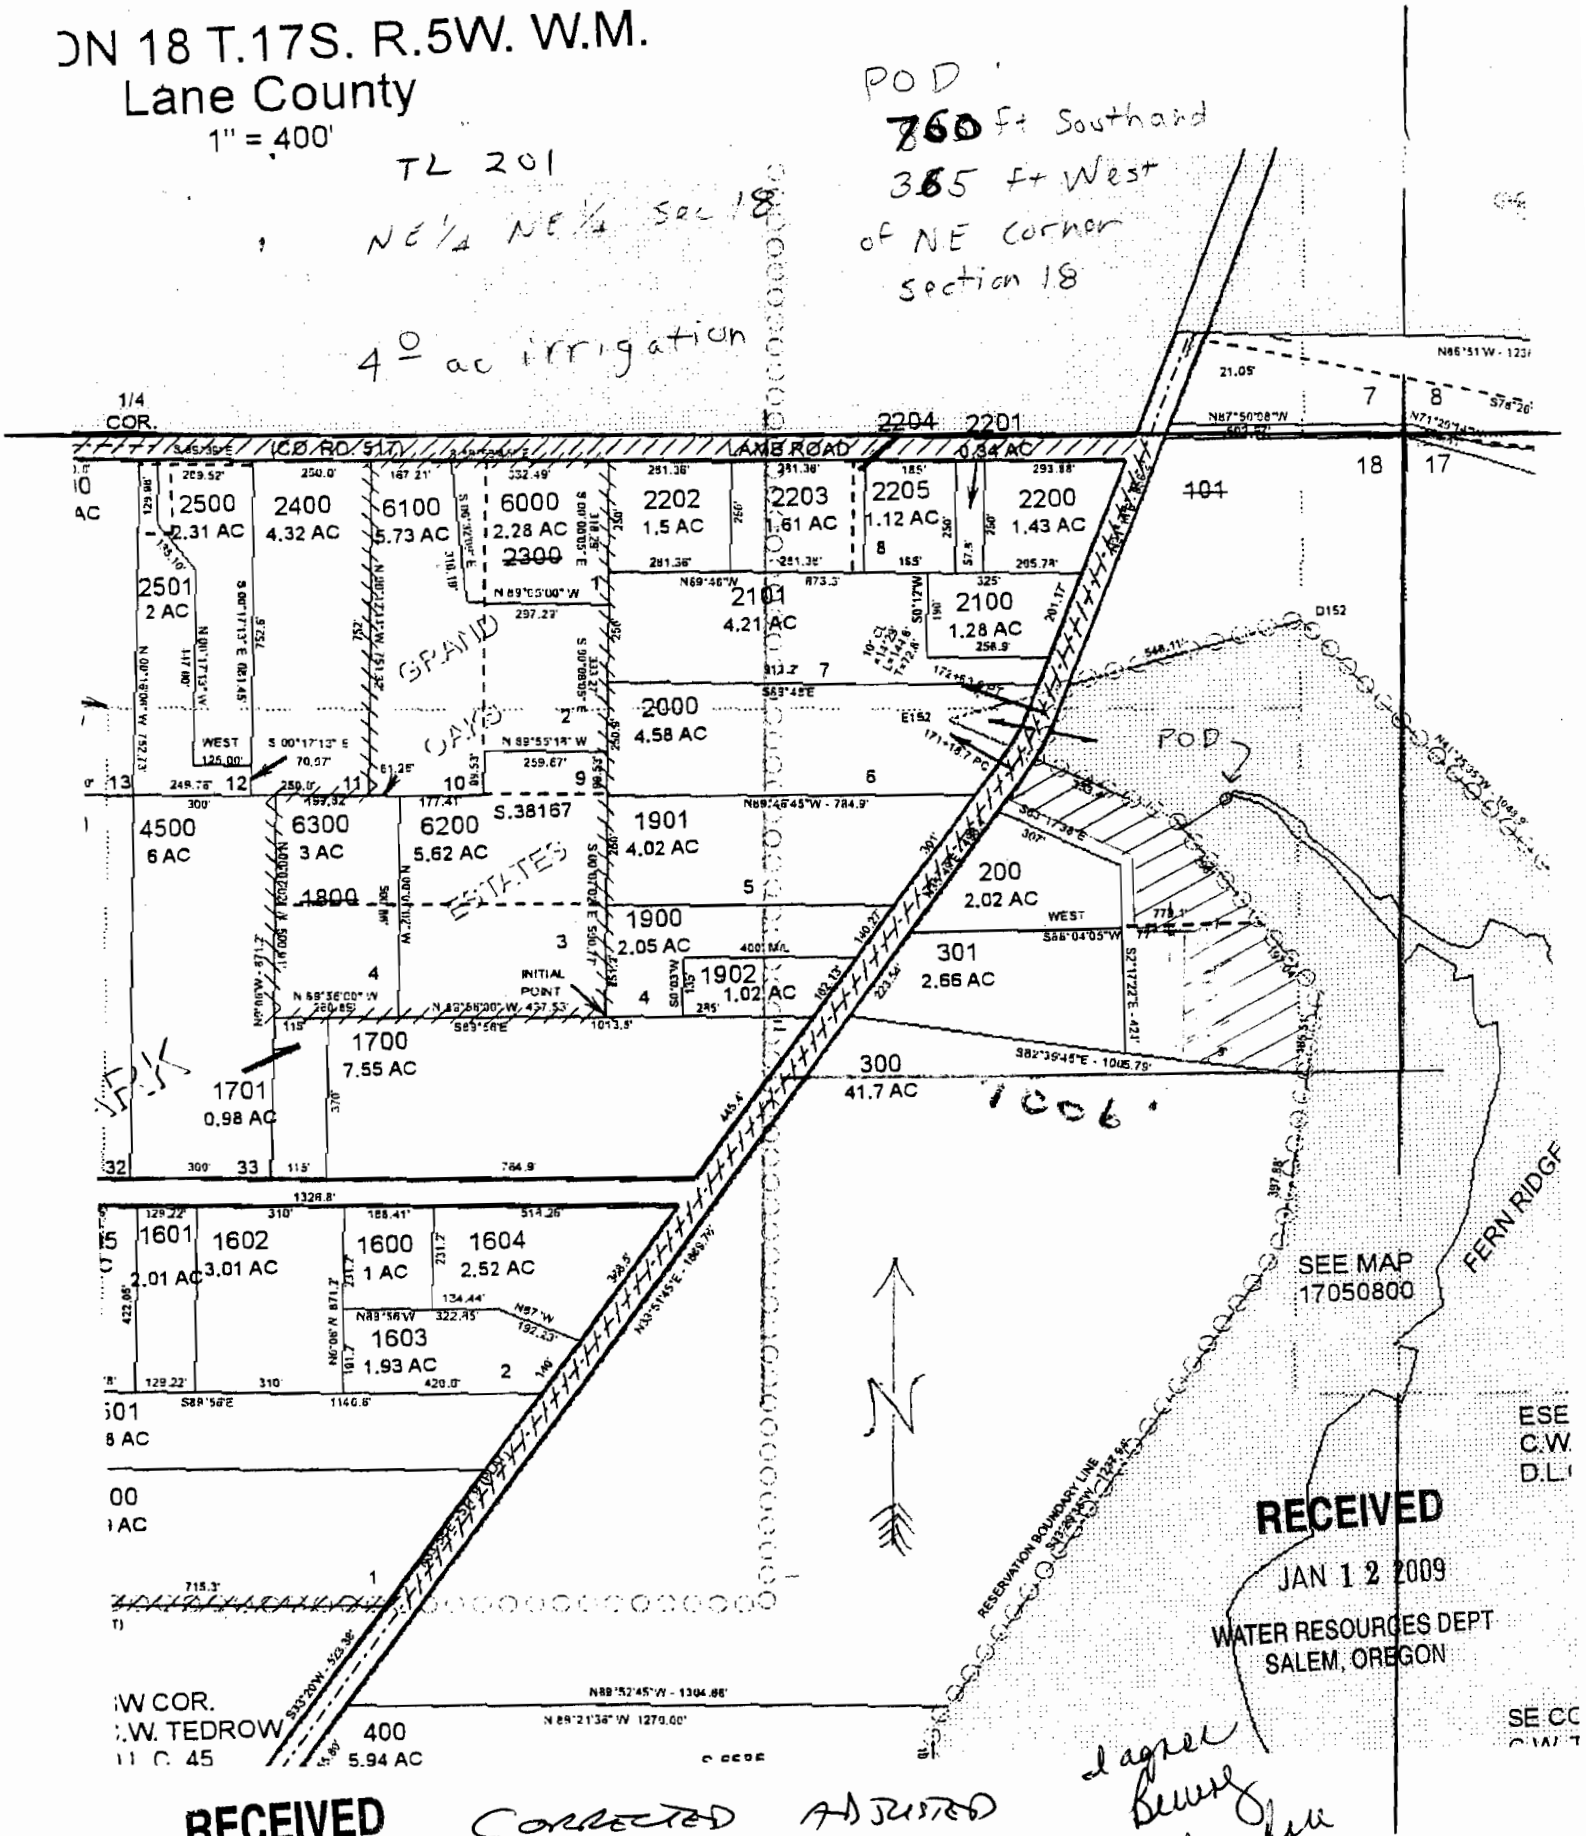
ON 18 T.17S. R.5W. W.M.
Lane County
1" = 400'
TL 201
NE¼ NE¼ Sec 18
40 ac irrigation
POD
760 ft Southand
365 ft West
of NE Corner
Section 18
1/4 COR.
CO. RD. 511
LAMB ROAD
2204
2201
0.84 AC
2500 2.31 AC
2400 4.32 AC
6100 5.73 AC
6000 2.28 AC
2300
2202 1.5 AC
2203 1.61 AC
2205 1.12 AC
2200 1.43 AC
2501 2 AC
2101 4.21 AC
2100 1.28 AC
OAKS
ESTATES
2000 4.58 AC
POD
4500 6 AC
6300 3 AC
6200 5.62 AC
S.38167
1901 4.02 AC
1800
1900 2.05 AC
200 2.02 AC
301 2.66 AC
INITIAL POINT
1902 1.02 AC
1700 7.55 AC
1701 0.98 AC
300 41.7 AC
1601 2.01 AC
1602 3.01 AC
1600 1 AC
1604 2.52 AC
1603 1.93 AC
400 5.94 AC
SEE MAP 17050800
FERN RIDGE
RESERVATION BOUNDARY LINE
RECEIVED
JAN 12 2009
WATER RESOURCES DEPT
SALEM, OREGON
RECEIVED
APR 04 2011
WATER RESOURCES DEPT
SALEM, OREGON
CORRECTED ADJUSTED APPROX. SCALE
1" = 400 FEET
S-87710
1-15-09