



T295 R12W

RECEIVED
MAR 24 2011
WATER RESOURCES DEPT
SALEM, OREGON

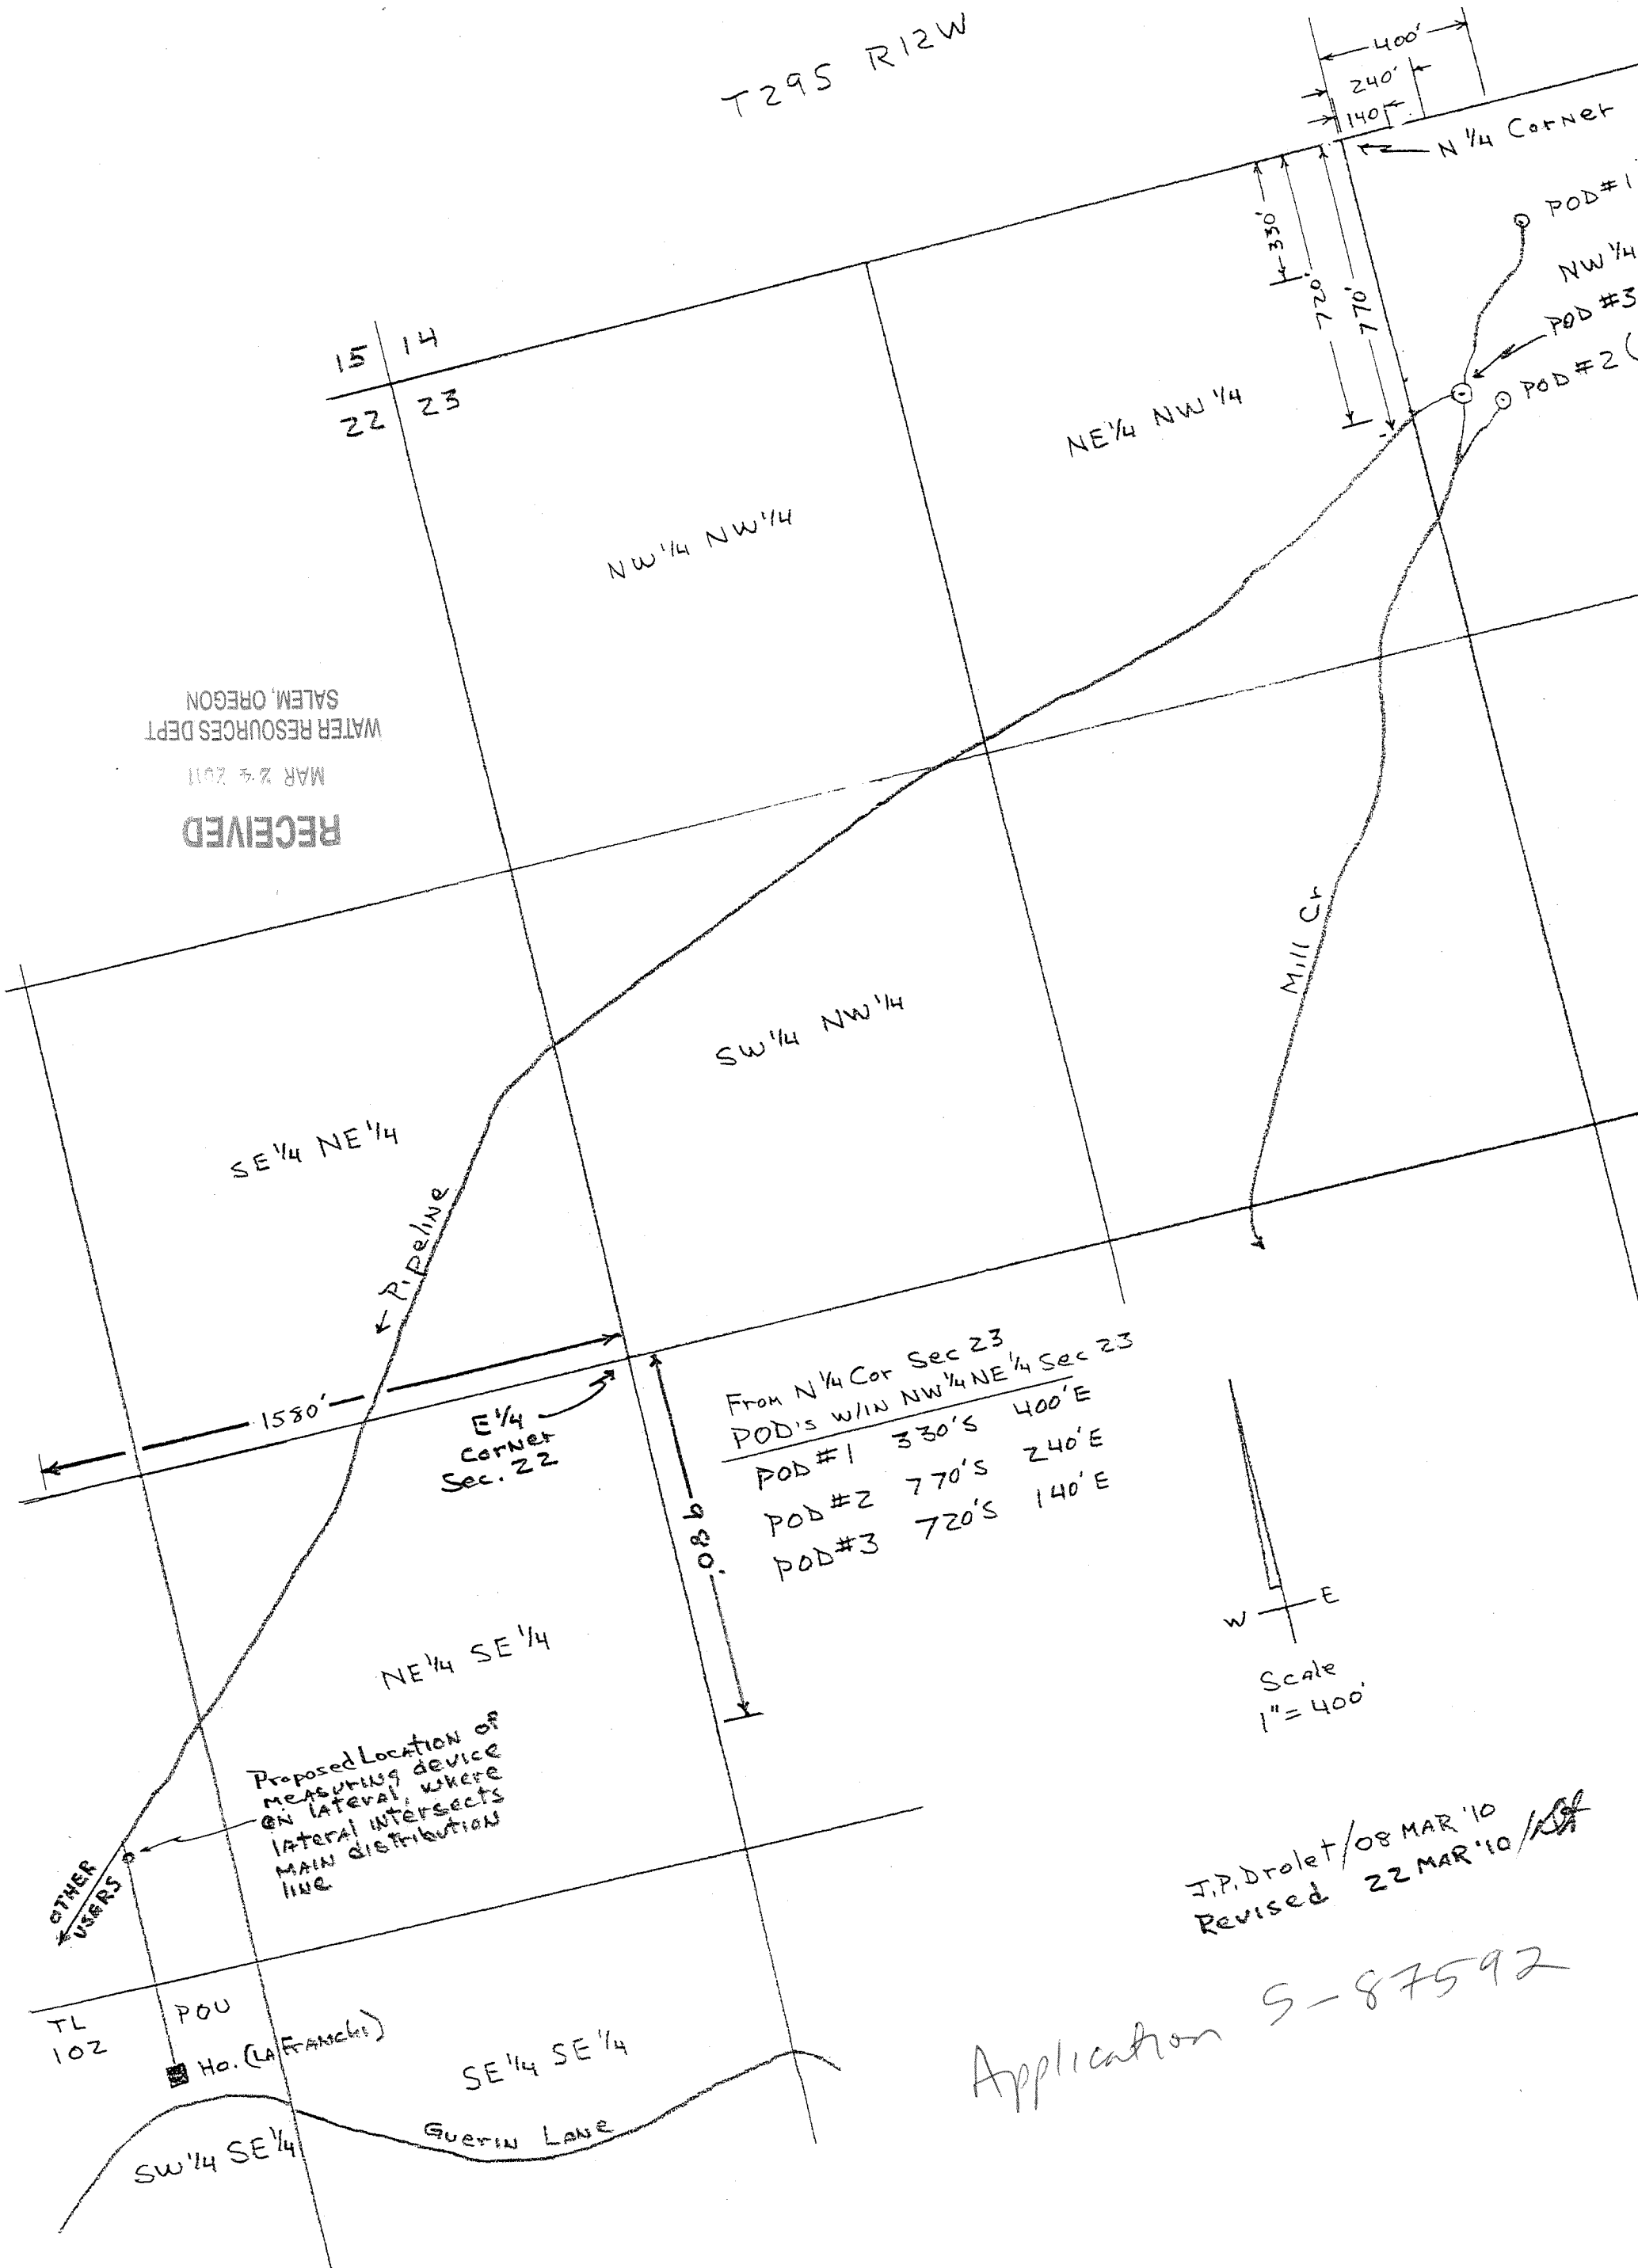

	From N 1/4 Cor Sec 23	POD's w/in NW 1/4 NE 1/4 Sec 23
POD #1	330'S	400'E
POD #2	770'S	240'E
POD #3	720'S	140'E

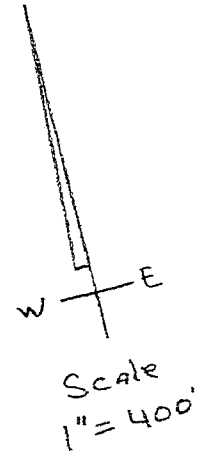

J.P. Drolet / 08 MAR '10
Revised 22 MAR '10

Application S-87592