


36S-3W-22-501

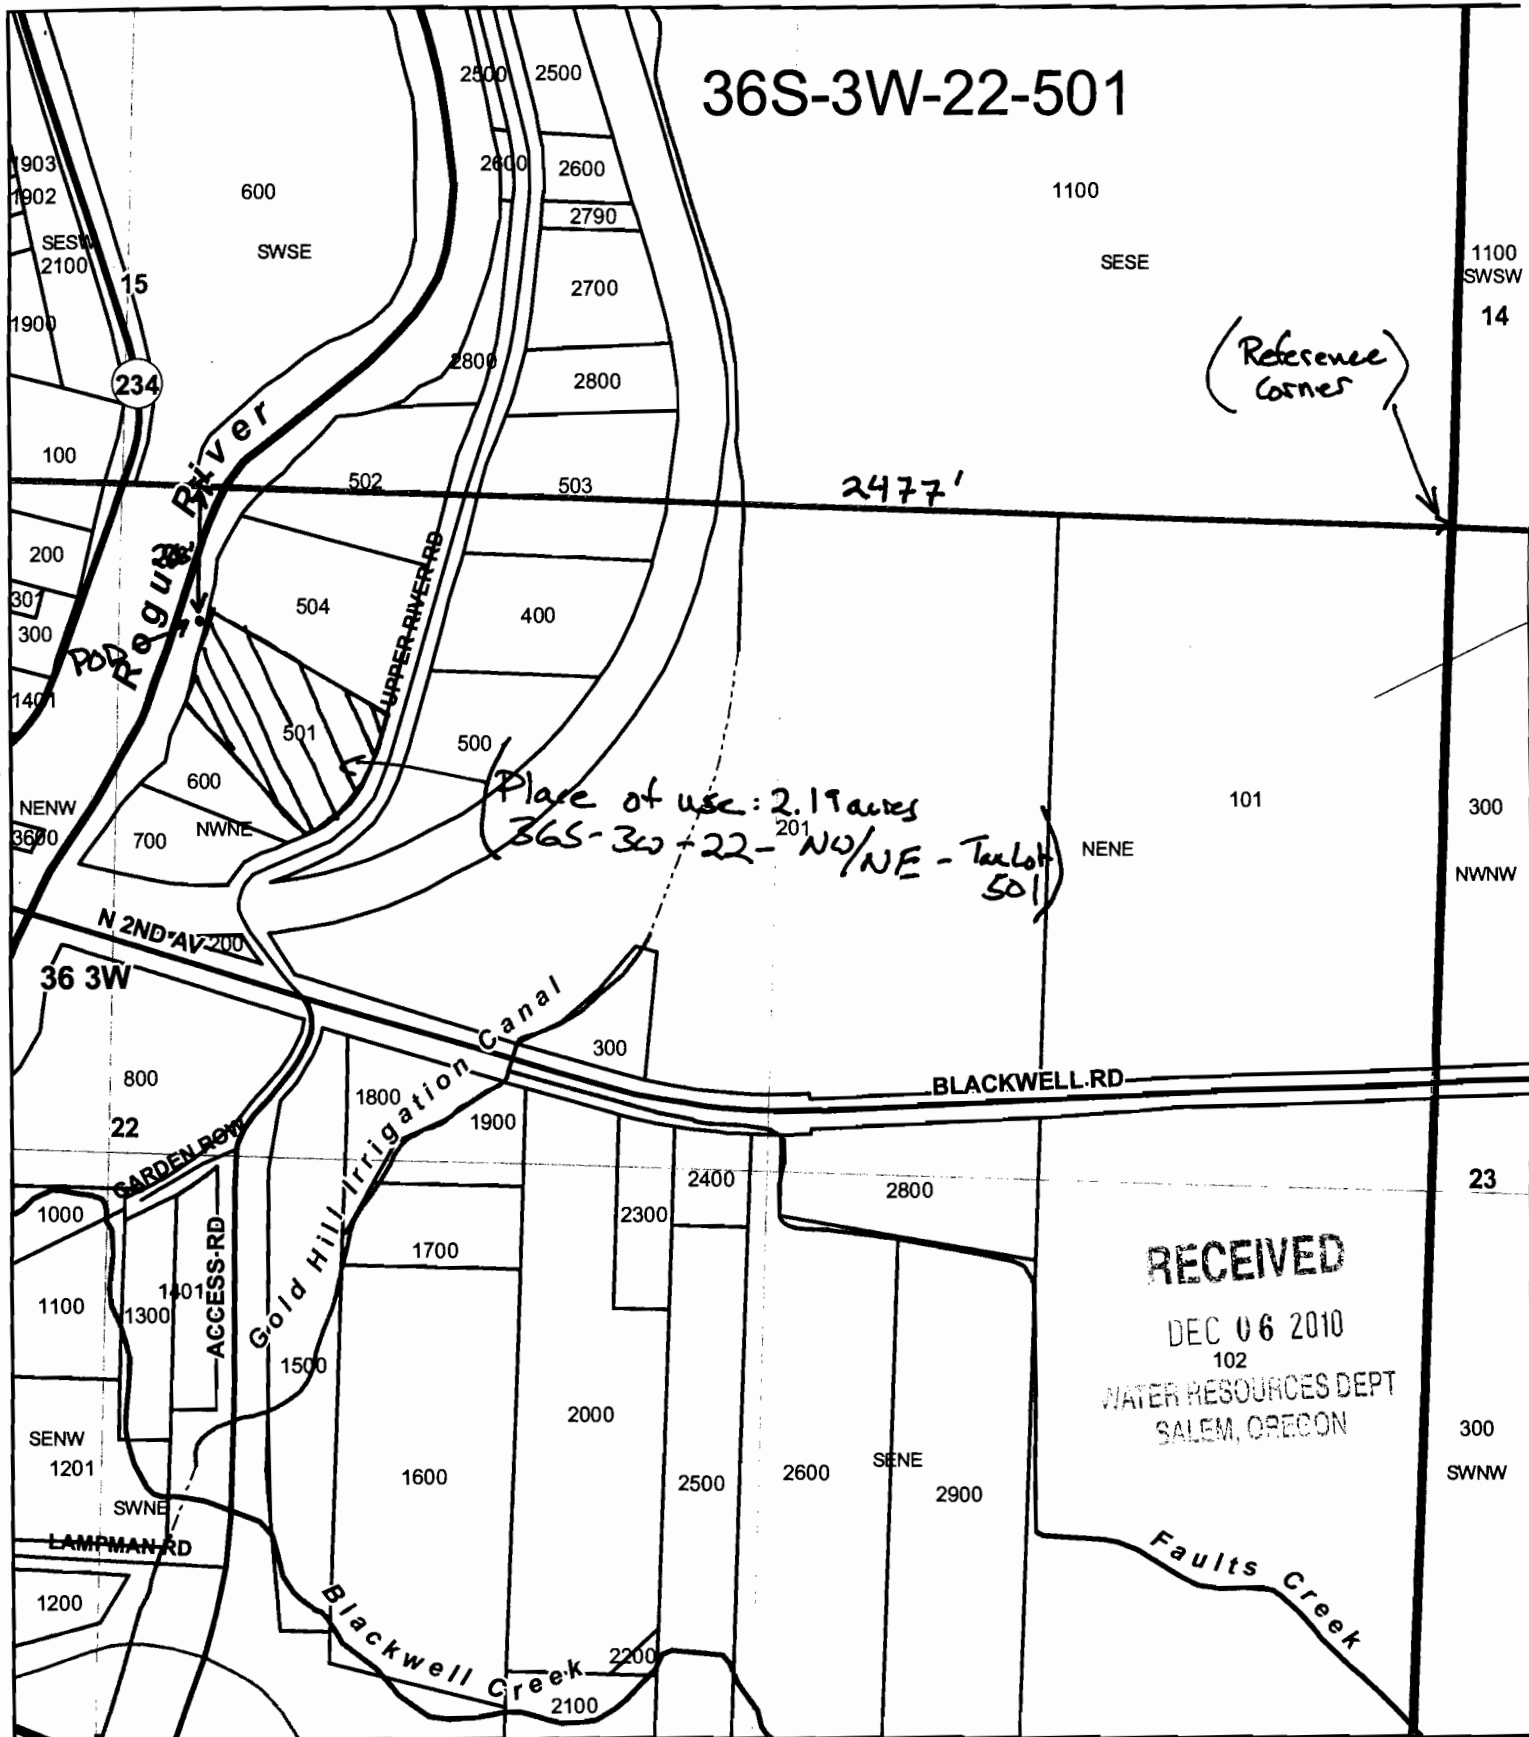

Place of use: 2.17 acres
36S-3W-22-201 NW/NE - Tax Lot 501

(Reference Corner)


RECEIVED
DEC 06 2010
102
WATER RESOURCES DEPT
SALEM, OREGON

Legend

- Tax Lots
- Sections
- Townships
- quarter quarters



1 inch = 384 feet

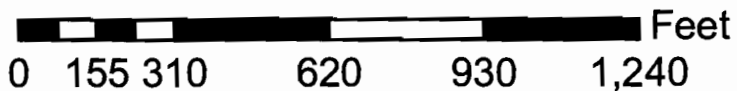

S-B7670