

W 1/4 →
Corner
Sec 23

LANE COUNTY

NW 1/4, SW 1/4, Sec 23 T.21S, R.3E.

All USFS property
All Tax Lot 100

Scale 1" = 200'


RECEIVED

DEC 14 2011

WATER RESOURCES DEPT
SALEM, OREGON

POD 1: 850'S; 180'E
POD 2: 900'S; 360'E
POD 3: 960'S; 555'E
POD 4: 970'S; 725'E
POD 5: 945'S; 810'E

all from W 1/4 corner
Section 23
T21S R3E

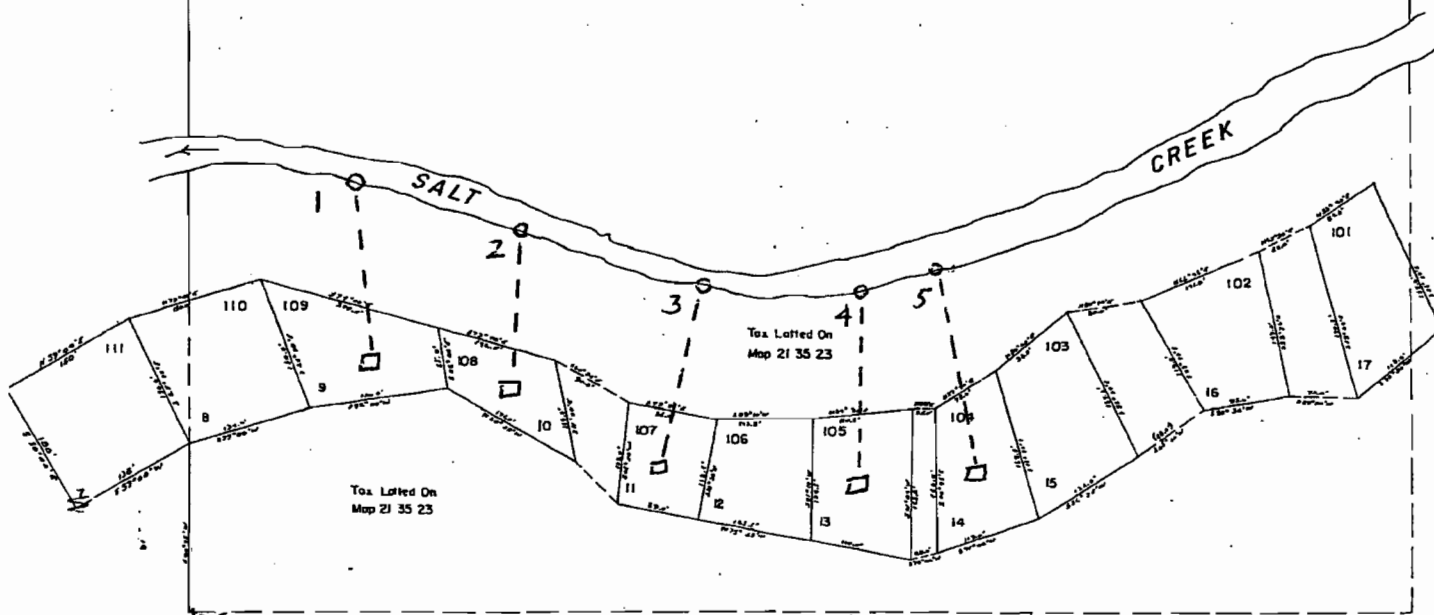

See Map 21 35 23



Appl. S-87499