


40S-3W-19-NE/SW-Tax Lot700

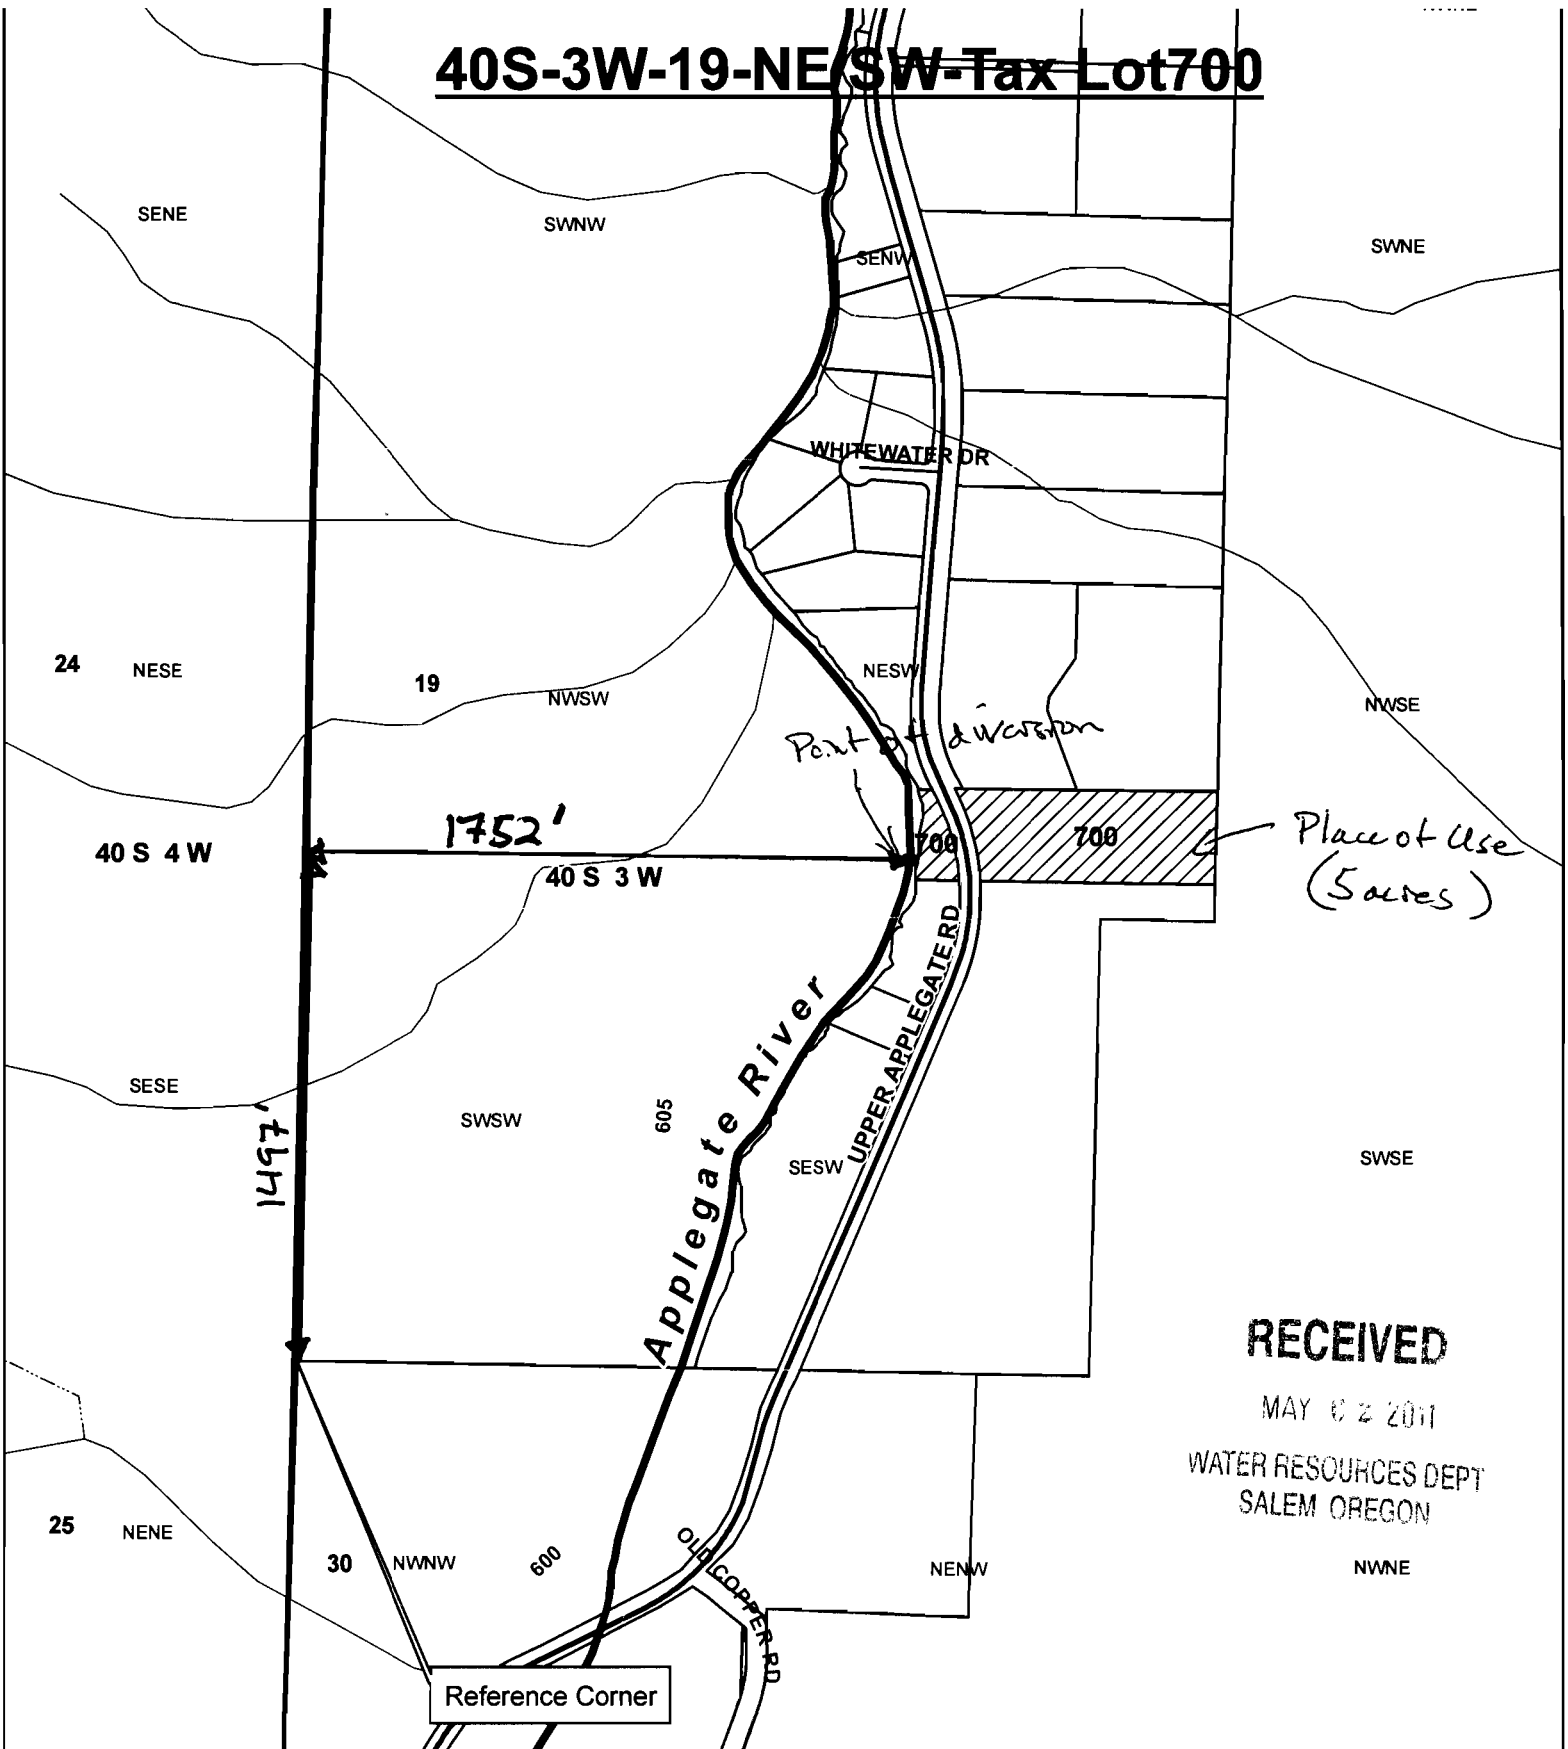


RECEIVED

MAY 02 2011


 




WATER RESOURCES DEPT
SALEM OREGON

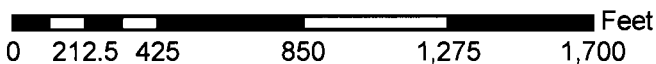

1 inch = 565 feet



Legend

-  POU
-  Tax Lots
-  Townships
-  Sections
-  Quarter quarters
-  POD