


S-87737

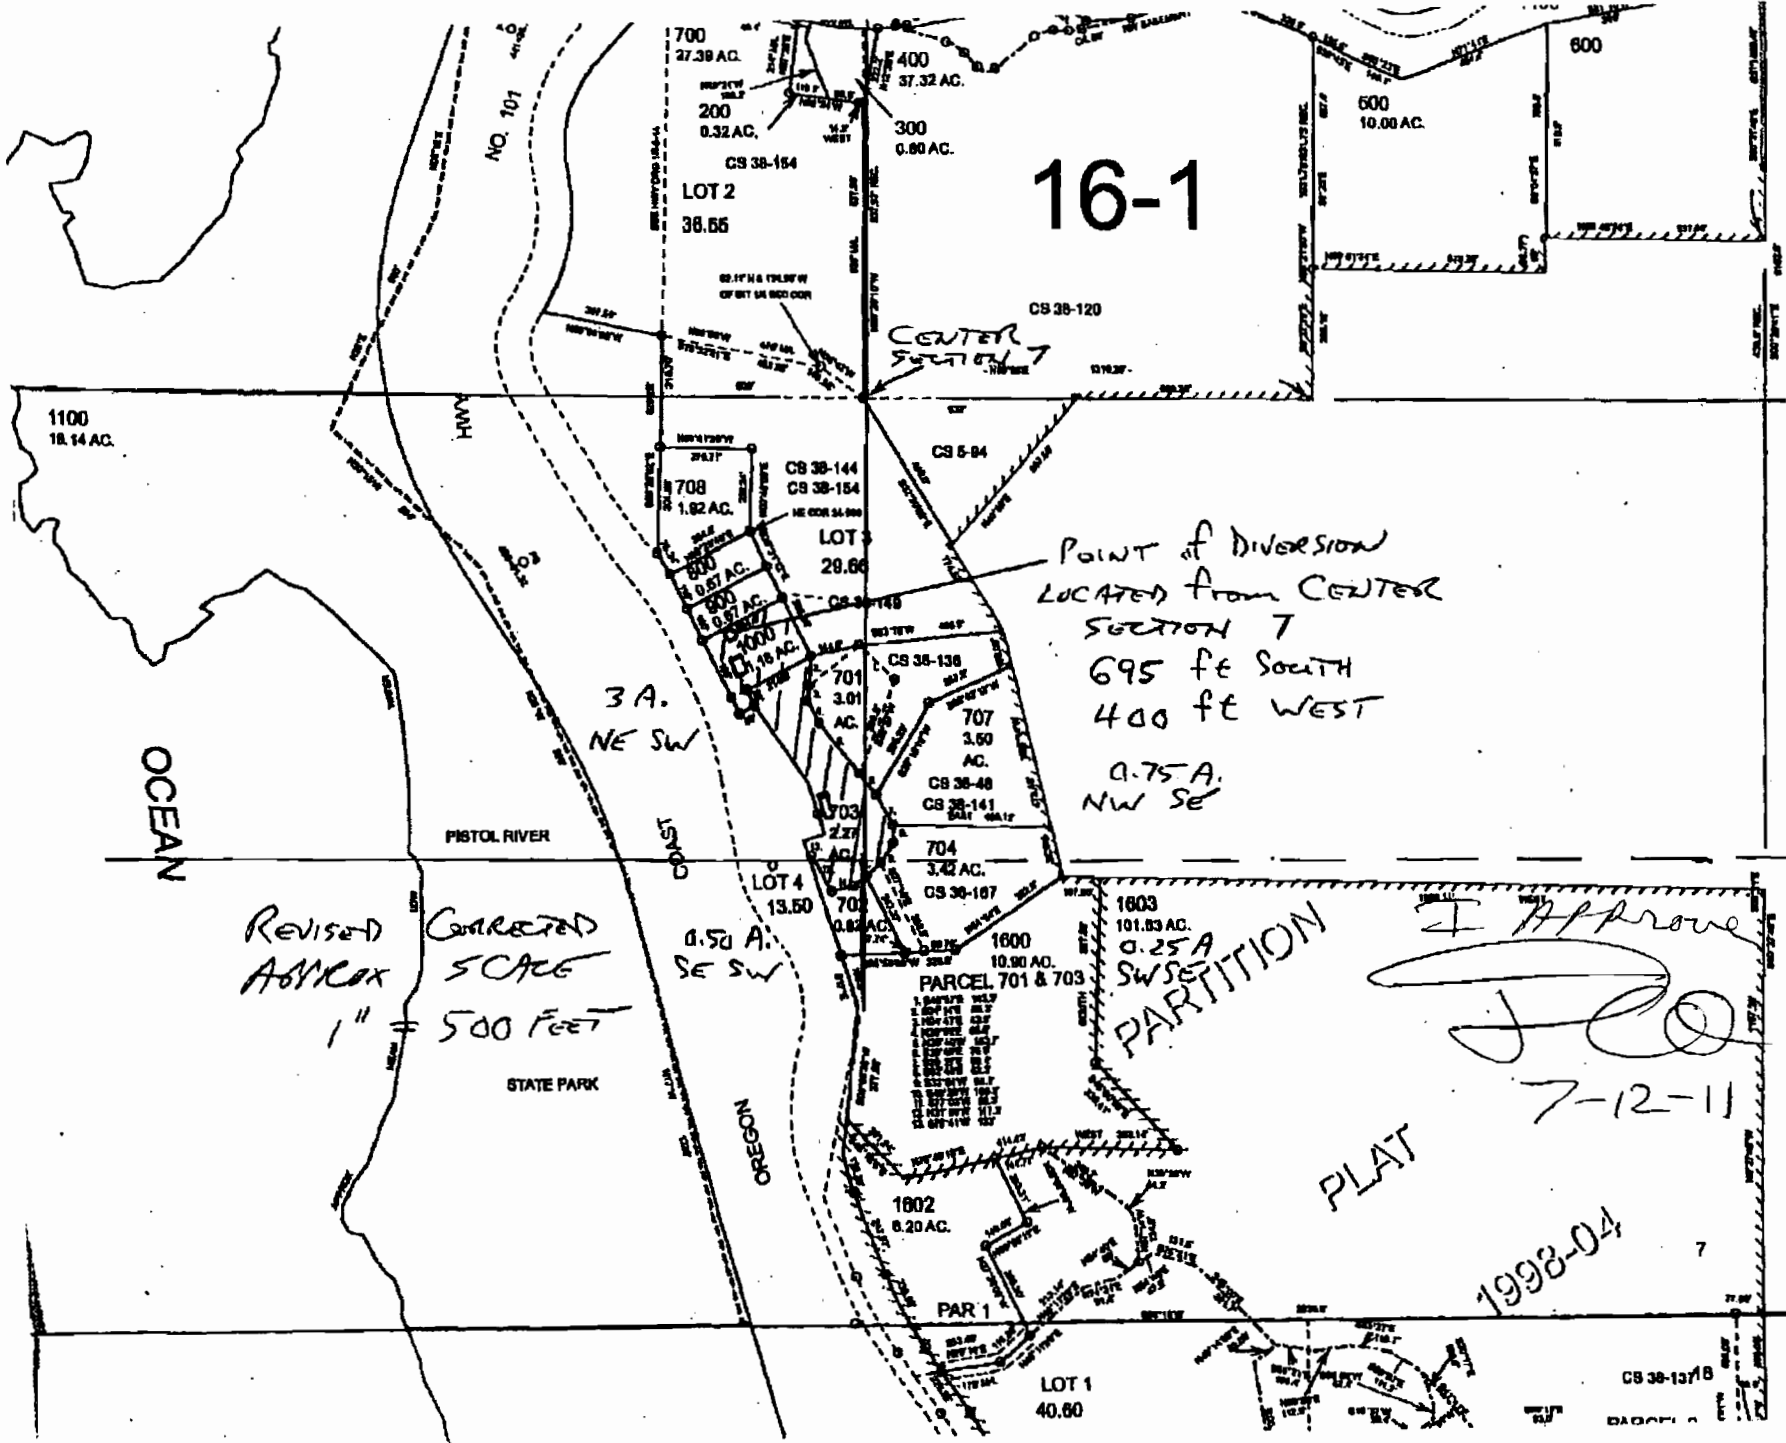

Revised
CORRECTED
SCALE
1" = 500 FEET
STATE PARK

16-1

CENTER SECTION 7

POINT of DIVERSION
LOCATED from CENTER
SECTION 7
695 FE SOUTH
400 FE WEST
0.75 A.
NW SE

PARITION
PLAT


I Approve
[Signature]
7-12-11

1998-04


SEE MAP 38S 14W

SECTION 07 T.38S. R.14W. W.M.
CURRY COUNTY

1" = 400'

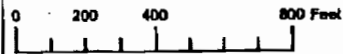

56112


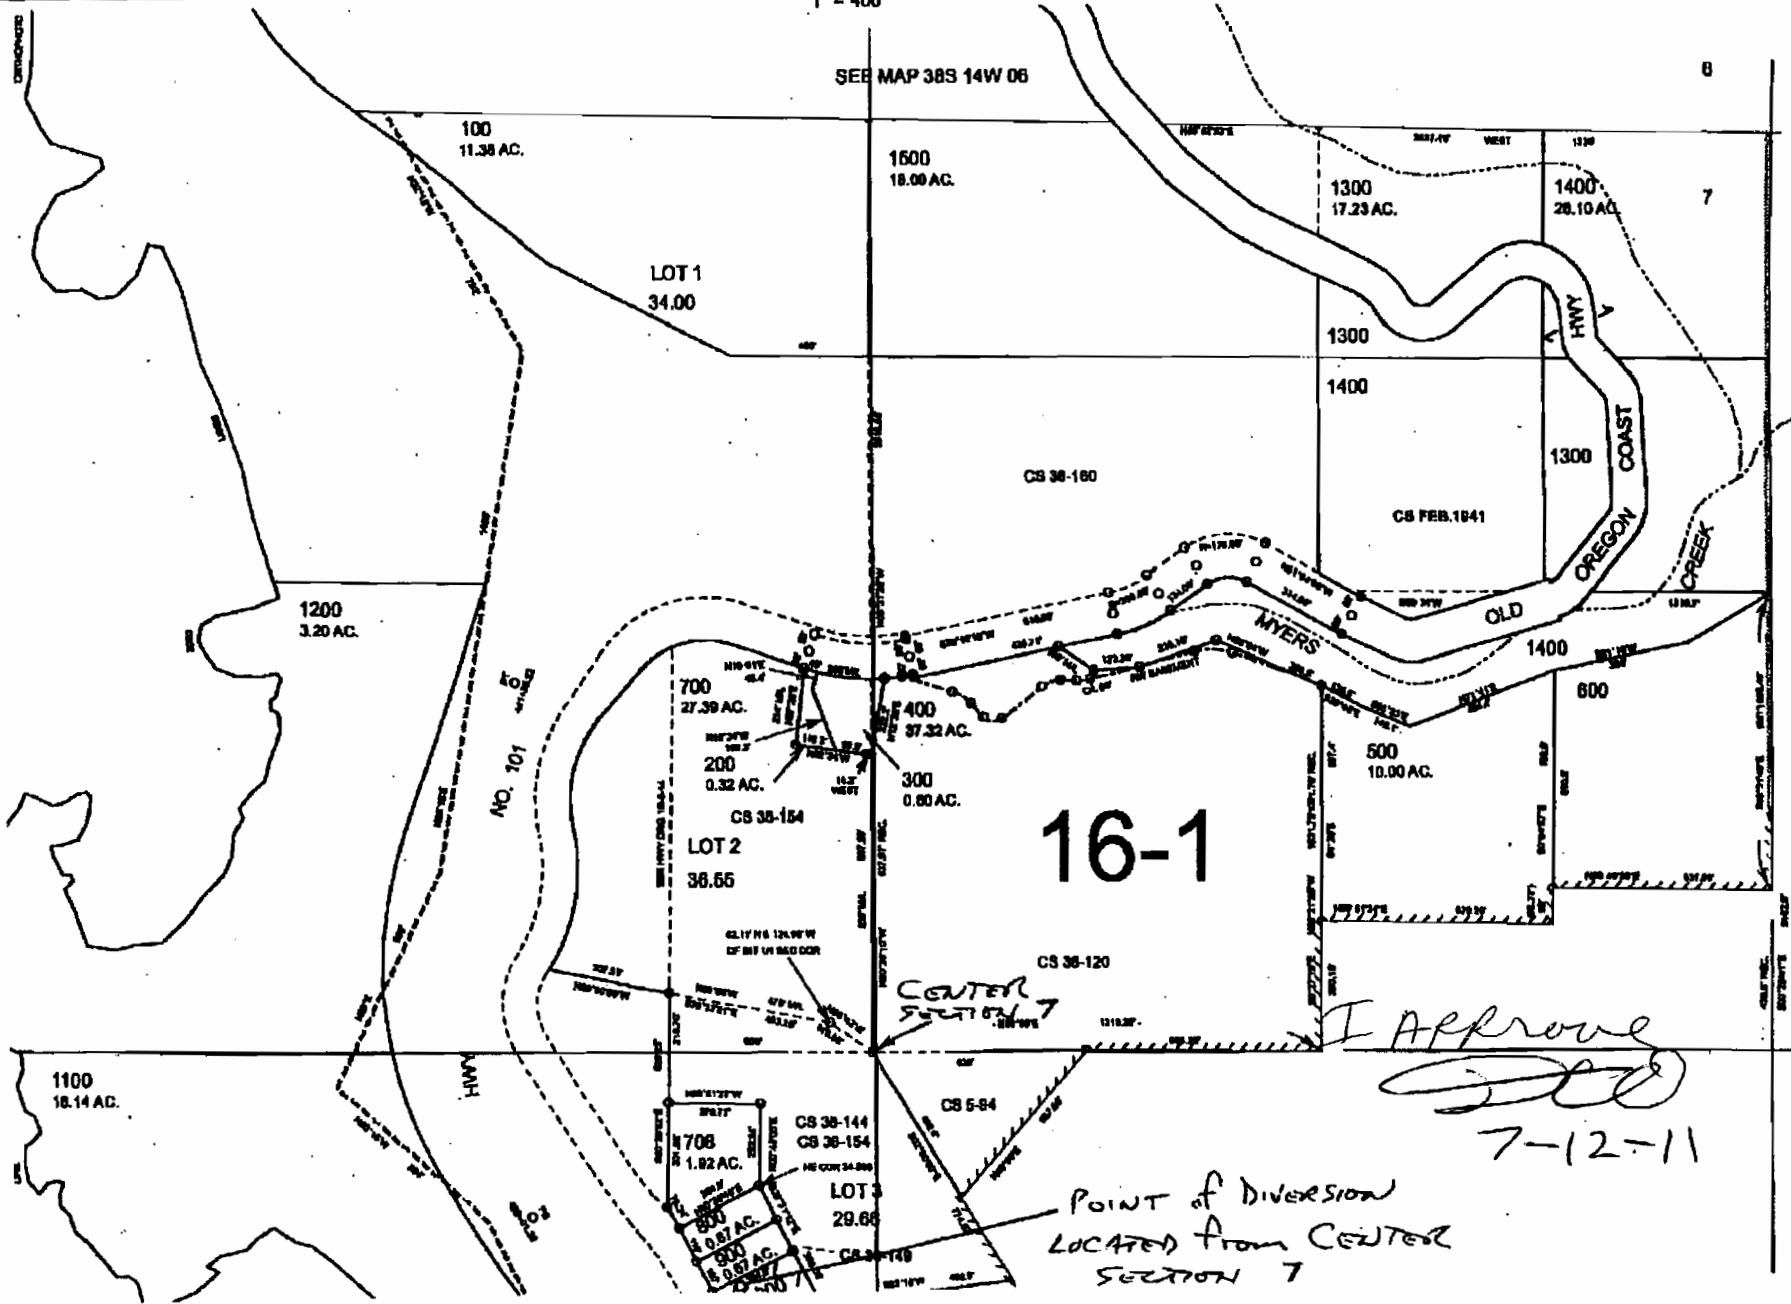


I Approve

7-12-11

POINT OF DIVERSION
LOCATED FROM CENTER
SECTION 7

Curry County Enterprise GIS

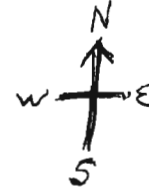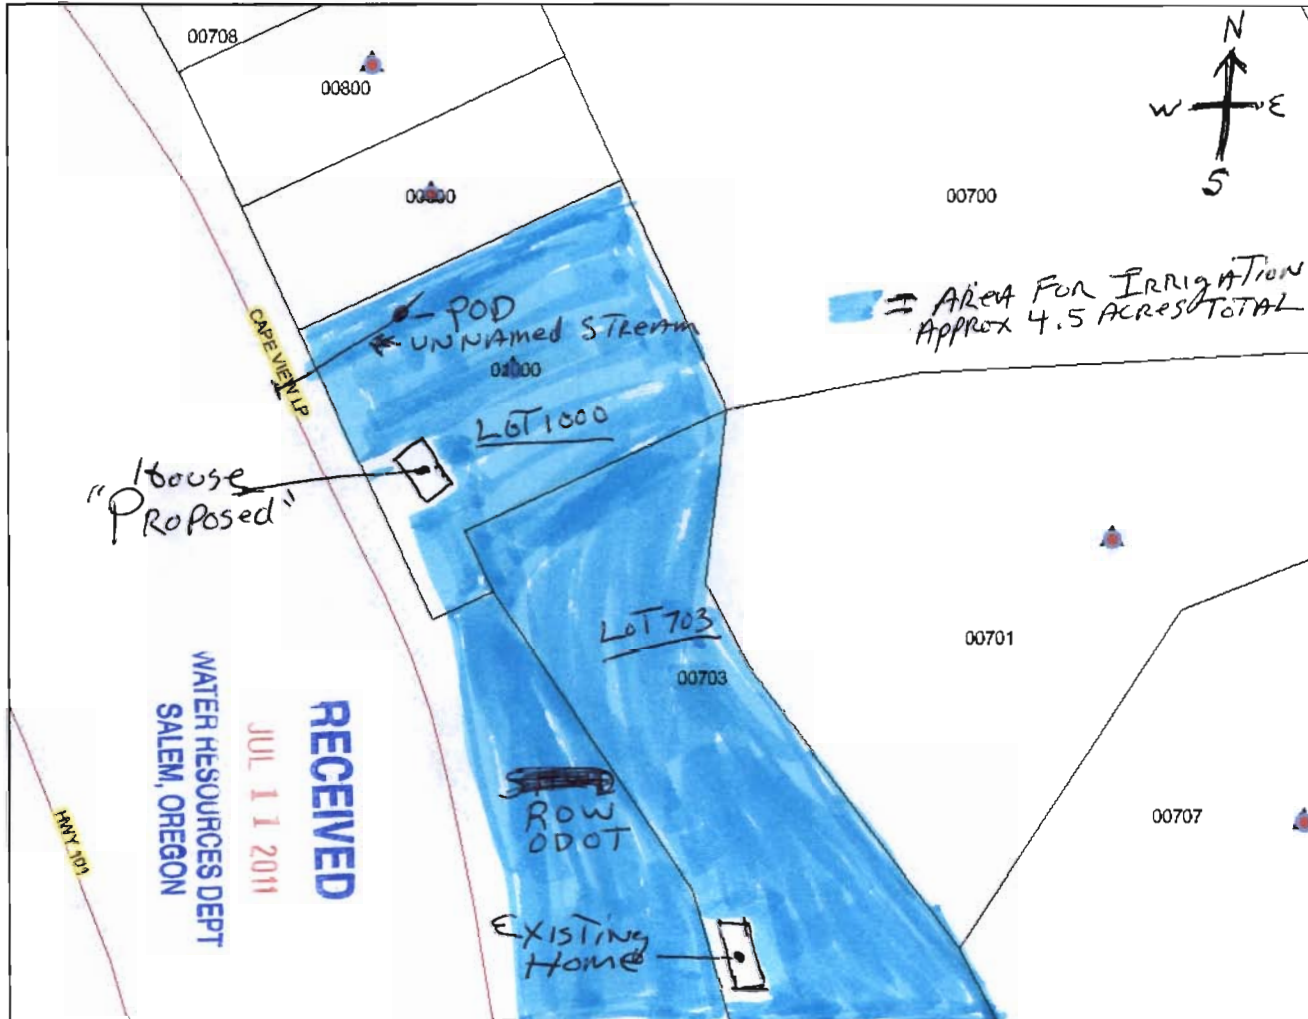

Legend

- TOWNSHIPS
- SITUS
- TAX CODES
- ▲ ASSESSMENT
- ~ ROADS
- PARCELS
- CITY LIMITS
- URBAN GROWTH BOUNDARY

RECEIVED
JUL 11 2011
WATER RESOURCES DEPT
SALEM, OREGON

Township 38-NE corner of the SW corner SECTION 7- Range 14



Map center: 42° 17' 57.4" N, 124° 24' 25.7" W



Scale: 1:1,601

This map is a public resource of general information. Use this information at your own risk. Curry County makes no warranty of any kind, expressed or implied, including any warranty of merchantability, fitness for any particular purpose or any other matter.

12118-5