


SW 1/4 NW 1/4 Sec. 11 T.26S. R.3W. W.M.

DOUGLAS COUNTY

Scale 1" = 200'

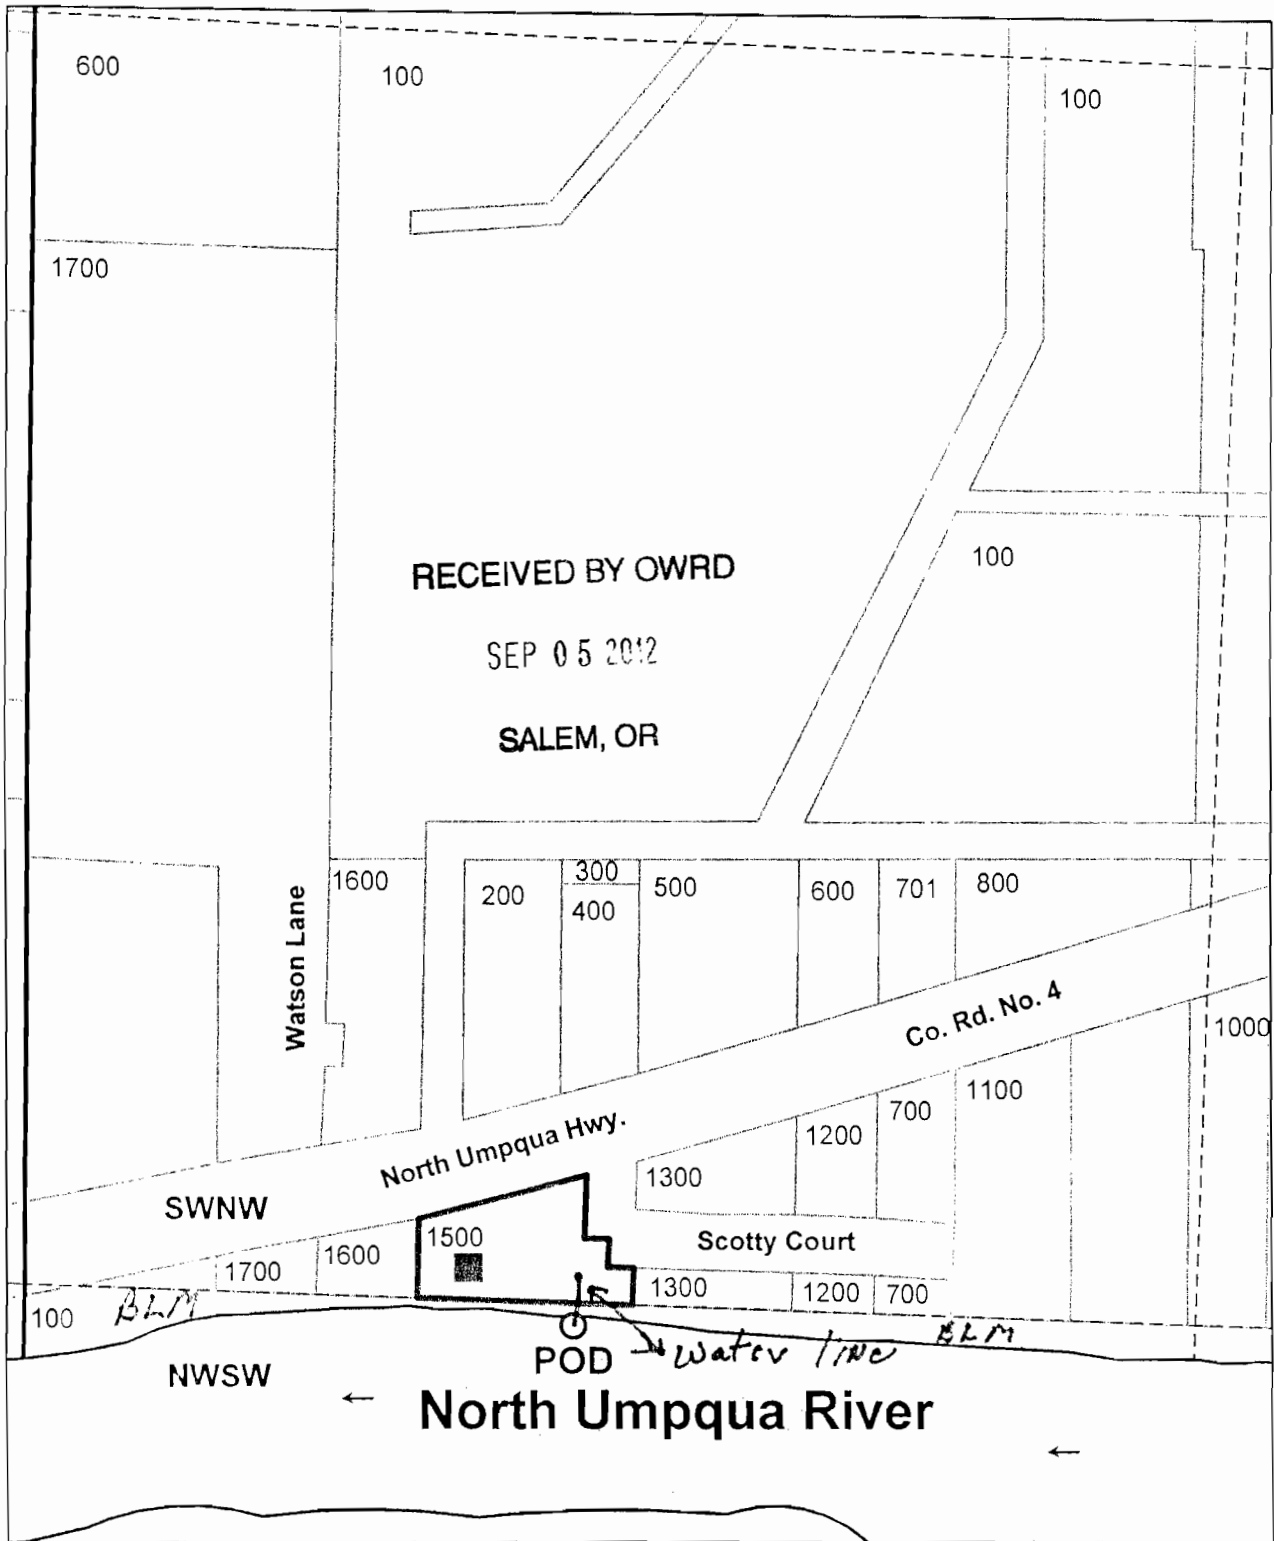

POD is 575 ft. east and 20 ft. south of the
West Quarter Corner of Section 11

2-87837