



Sidney 1991 permit Certification

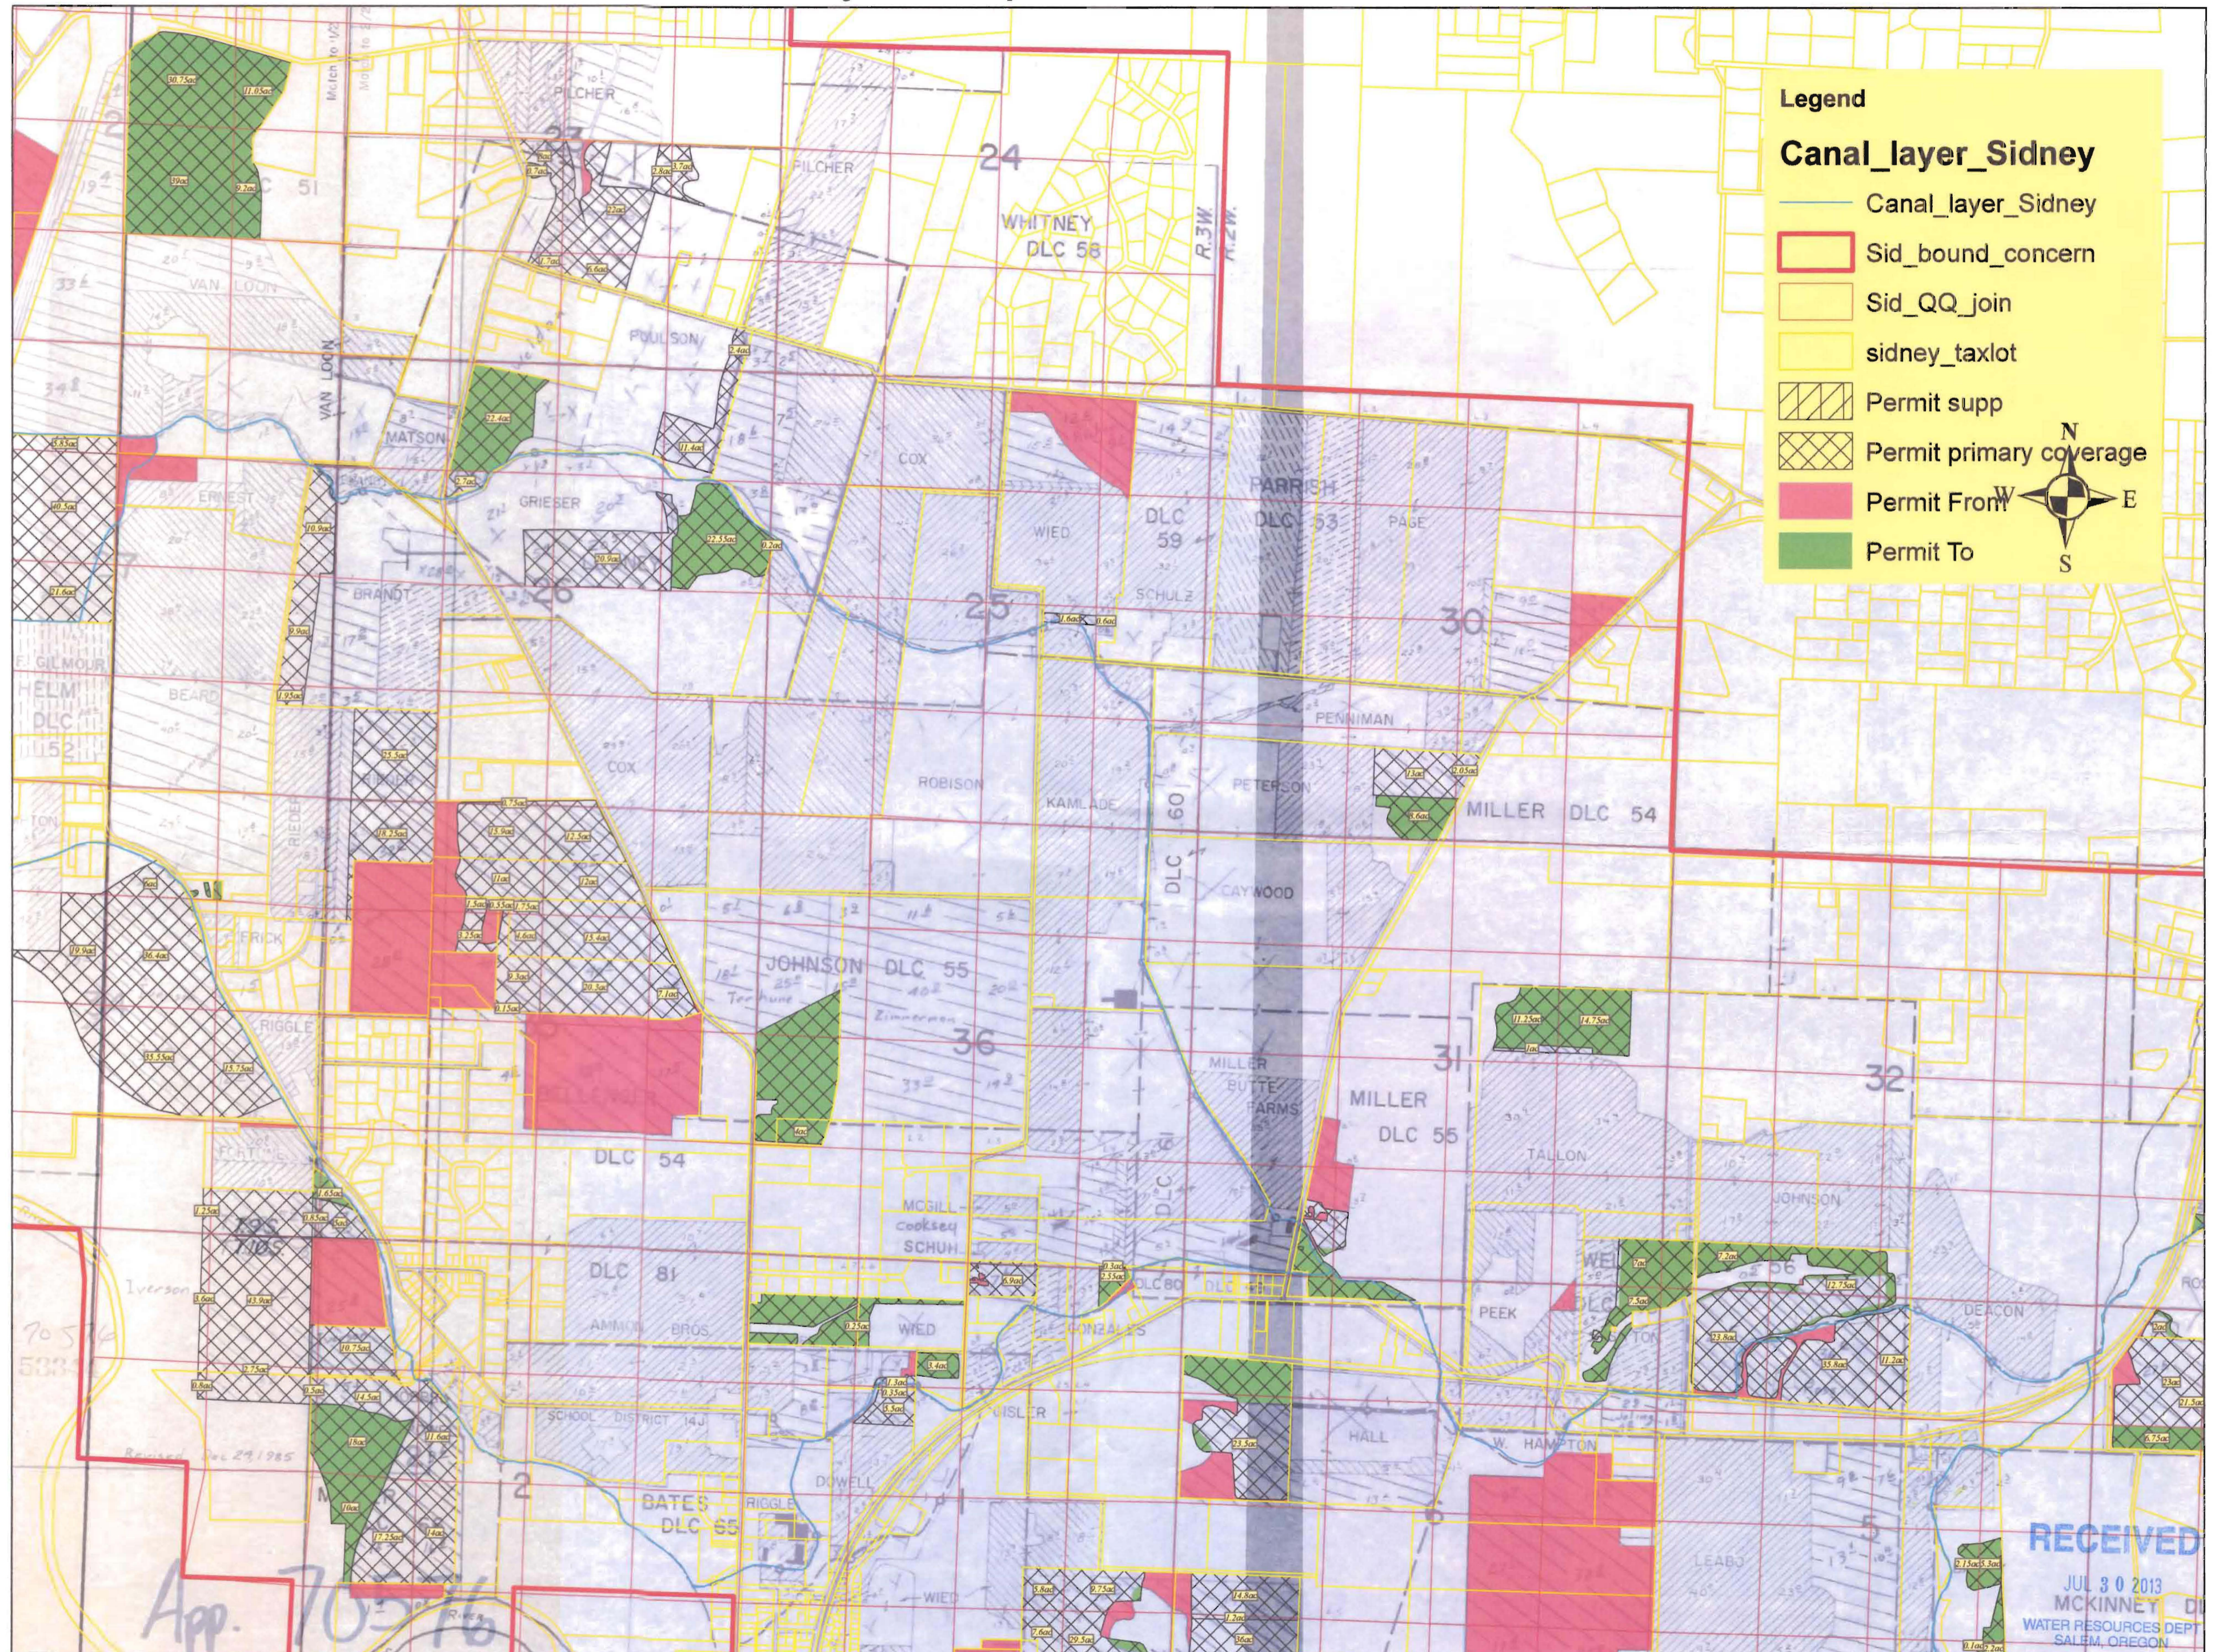

3,700 1,850 0 3,700 Feet

Sidney 1991 permit Certification

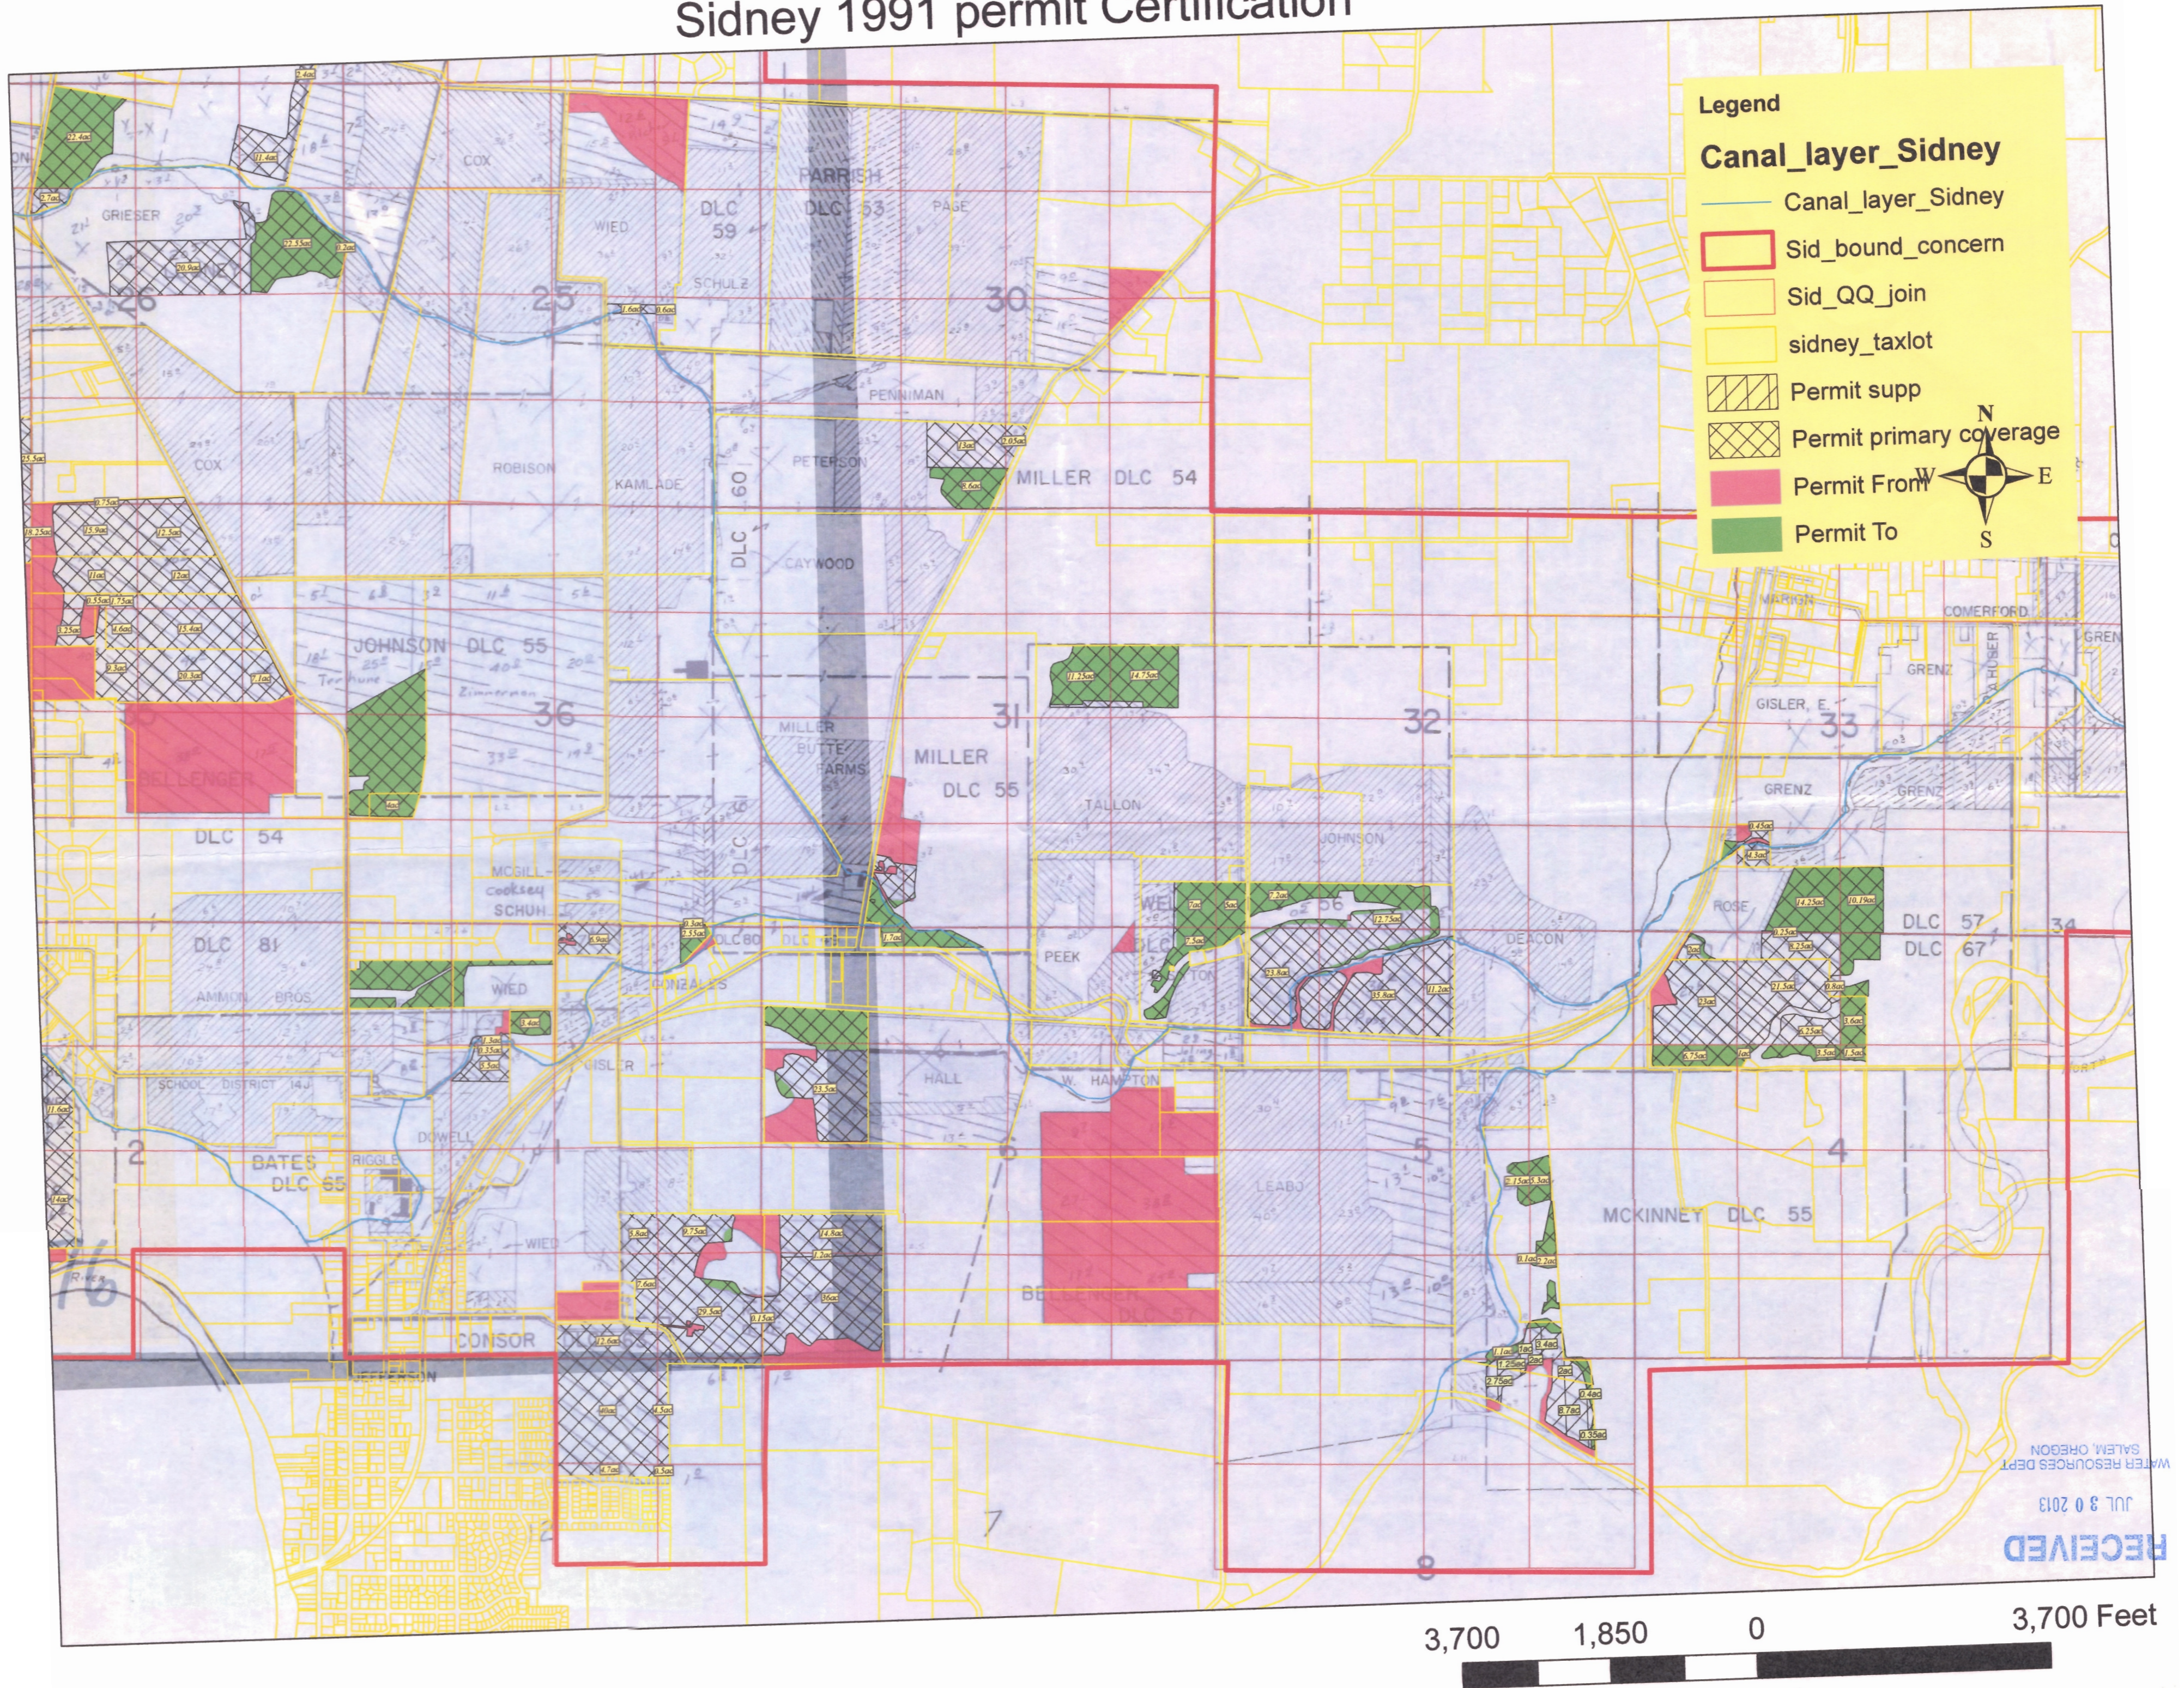


Sidney 1991 permit Certification

RECEIVED

JUL 30 2013


WATER RESOURCES DEPT
SALEM, OREGON

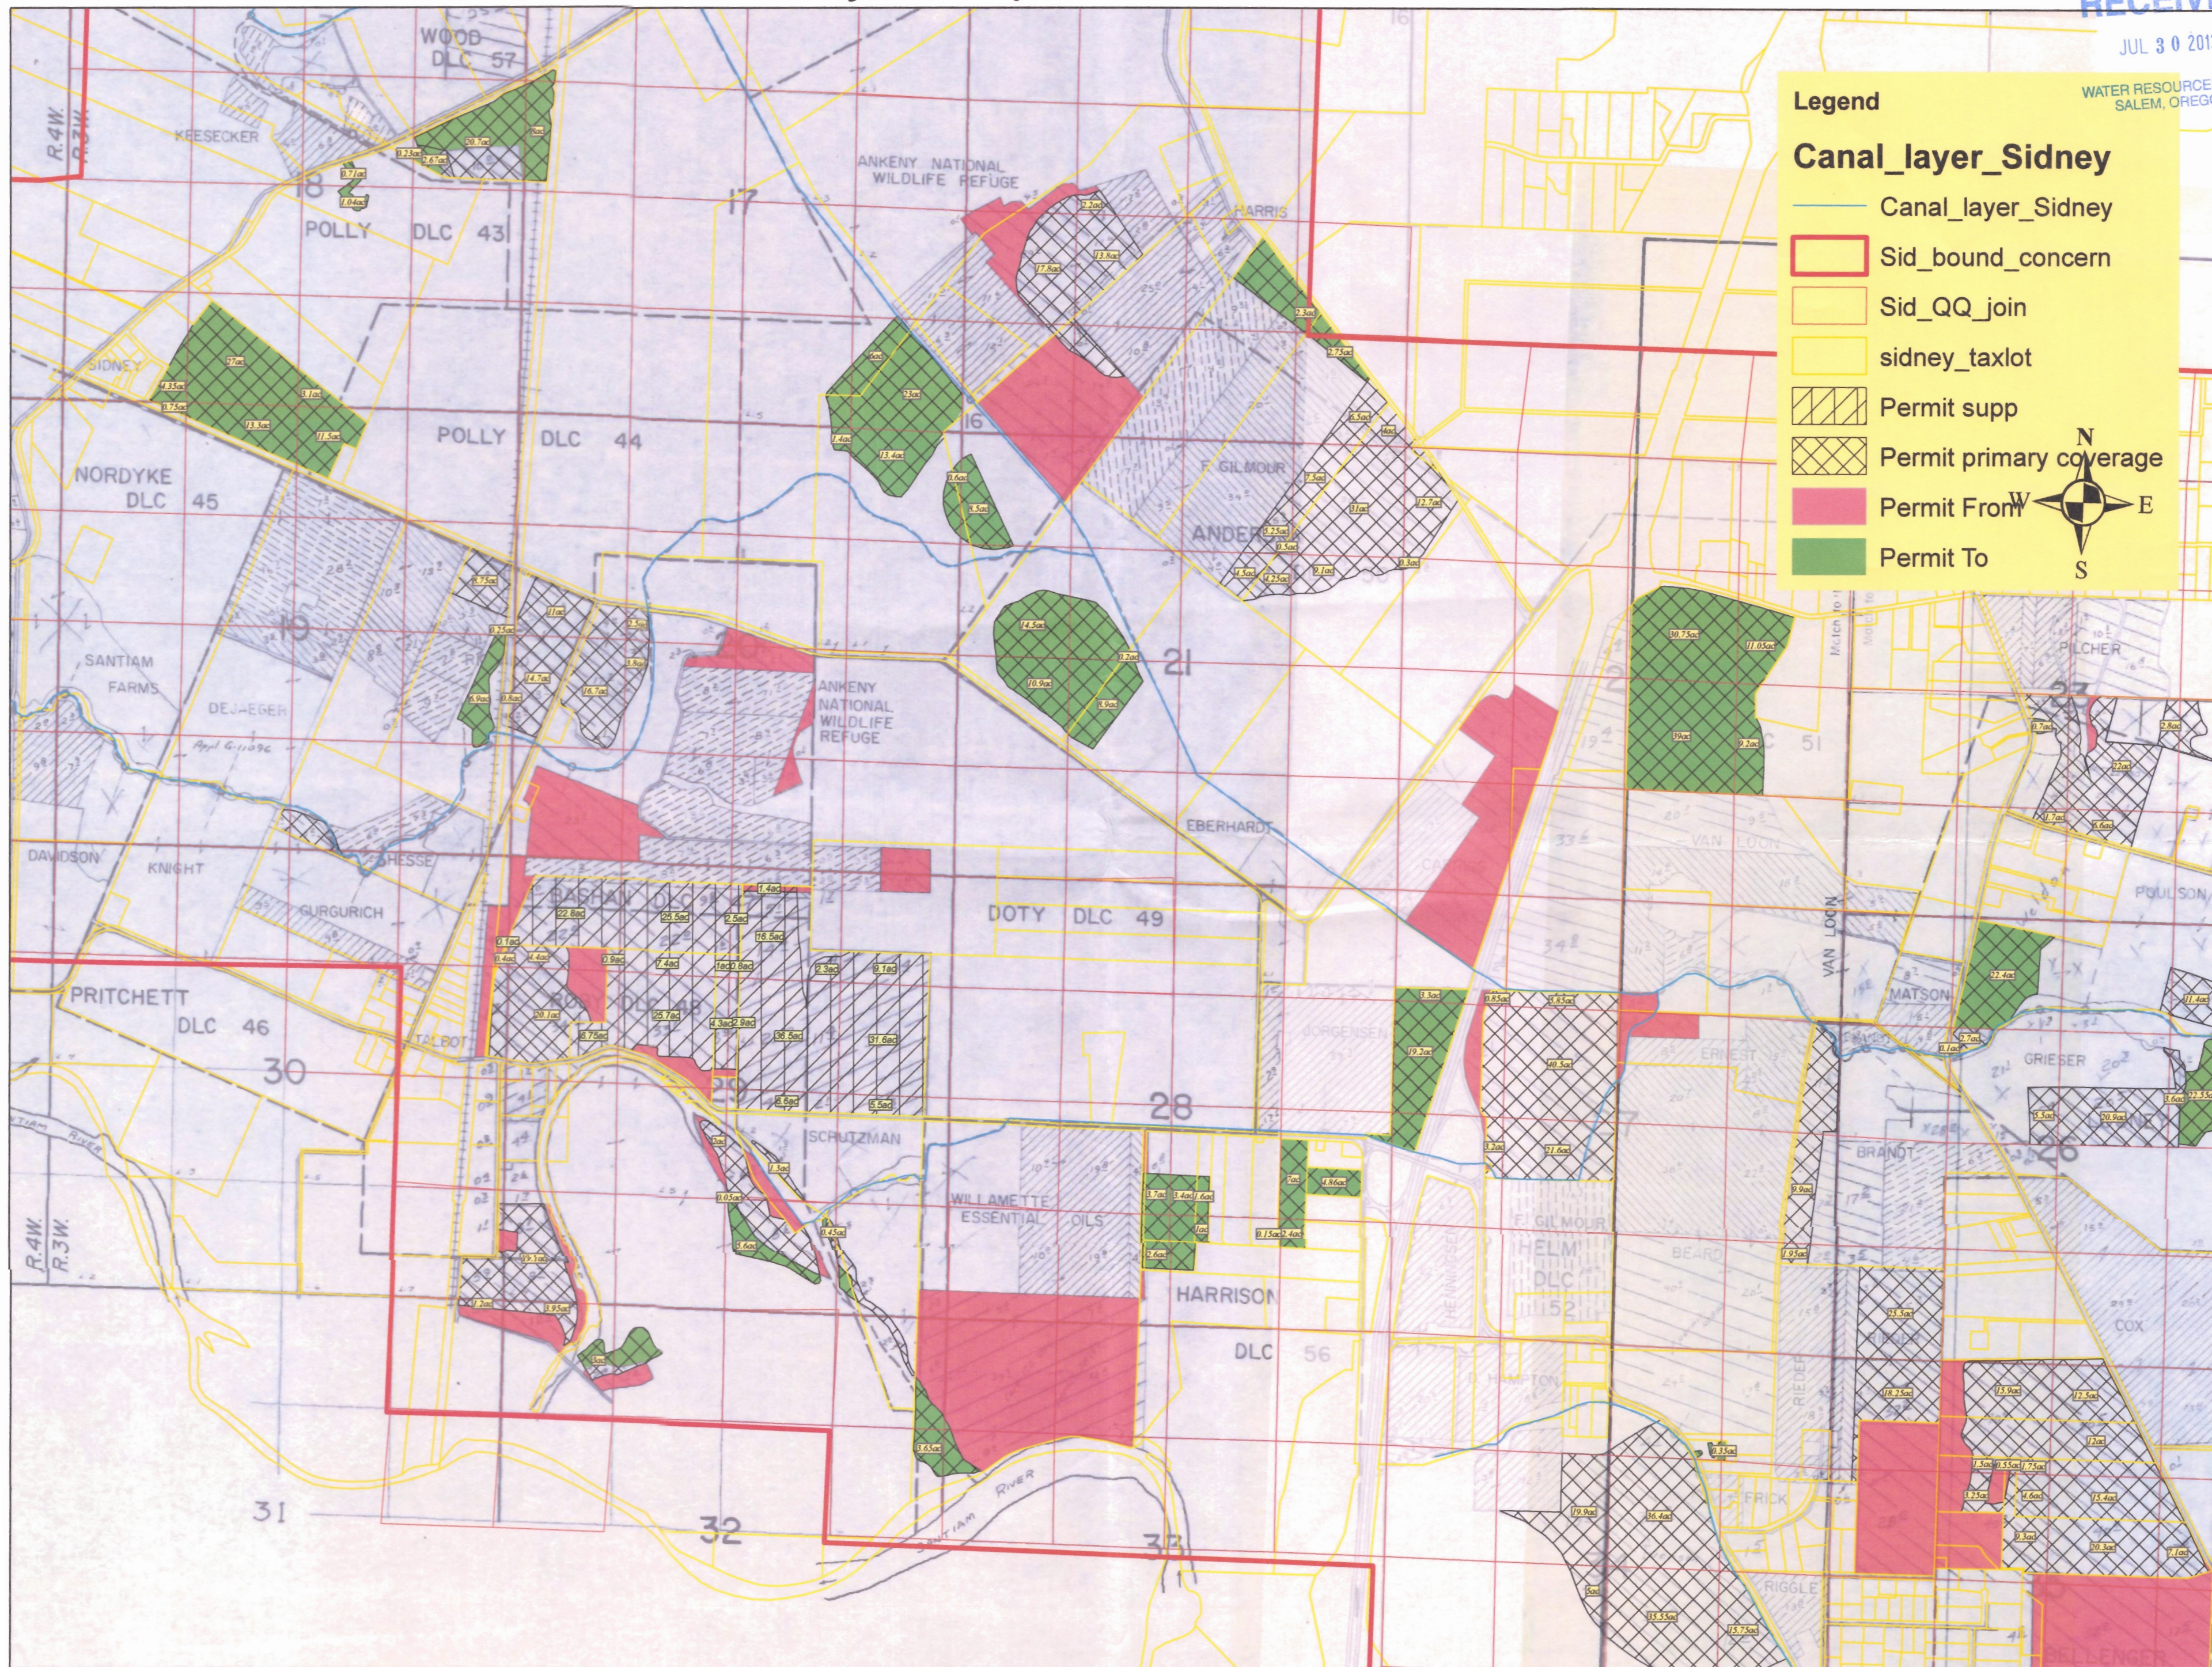


Legend

Canal_layer_Sidney

- Canal_layer_Sidney
- Sid_bound_concern
- Sid_QQ_join
- sidney_taxlot
- Permit supp
- Permit primary coverage
- Permit Front
- Permit To

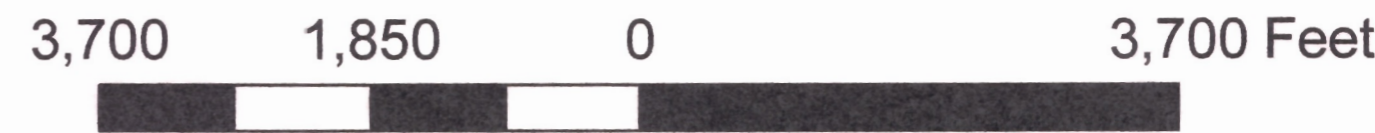


Sidney 1991 permit Certification

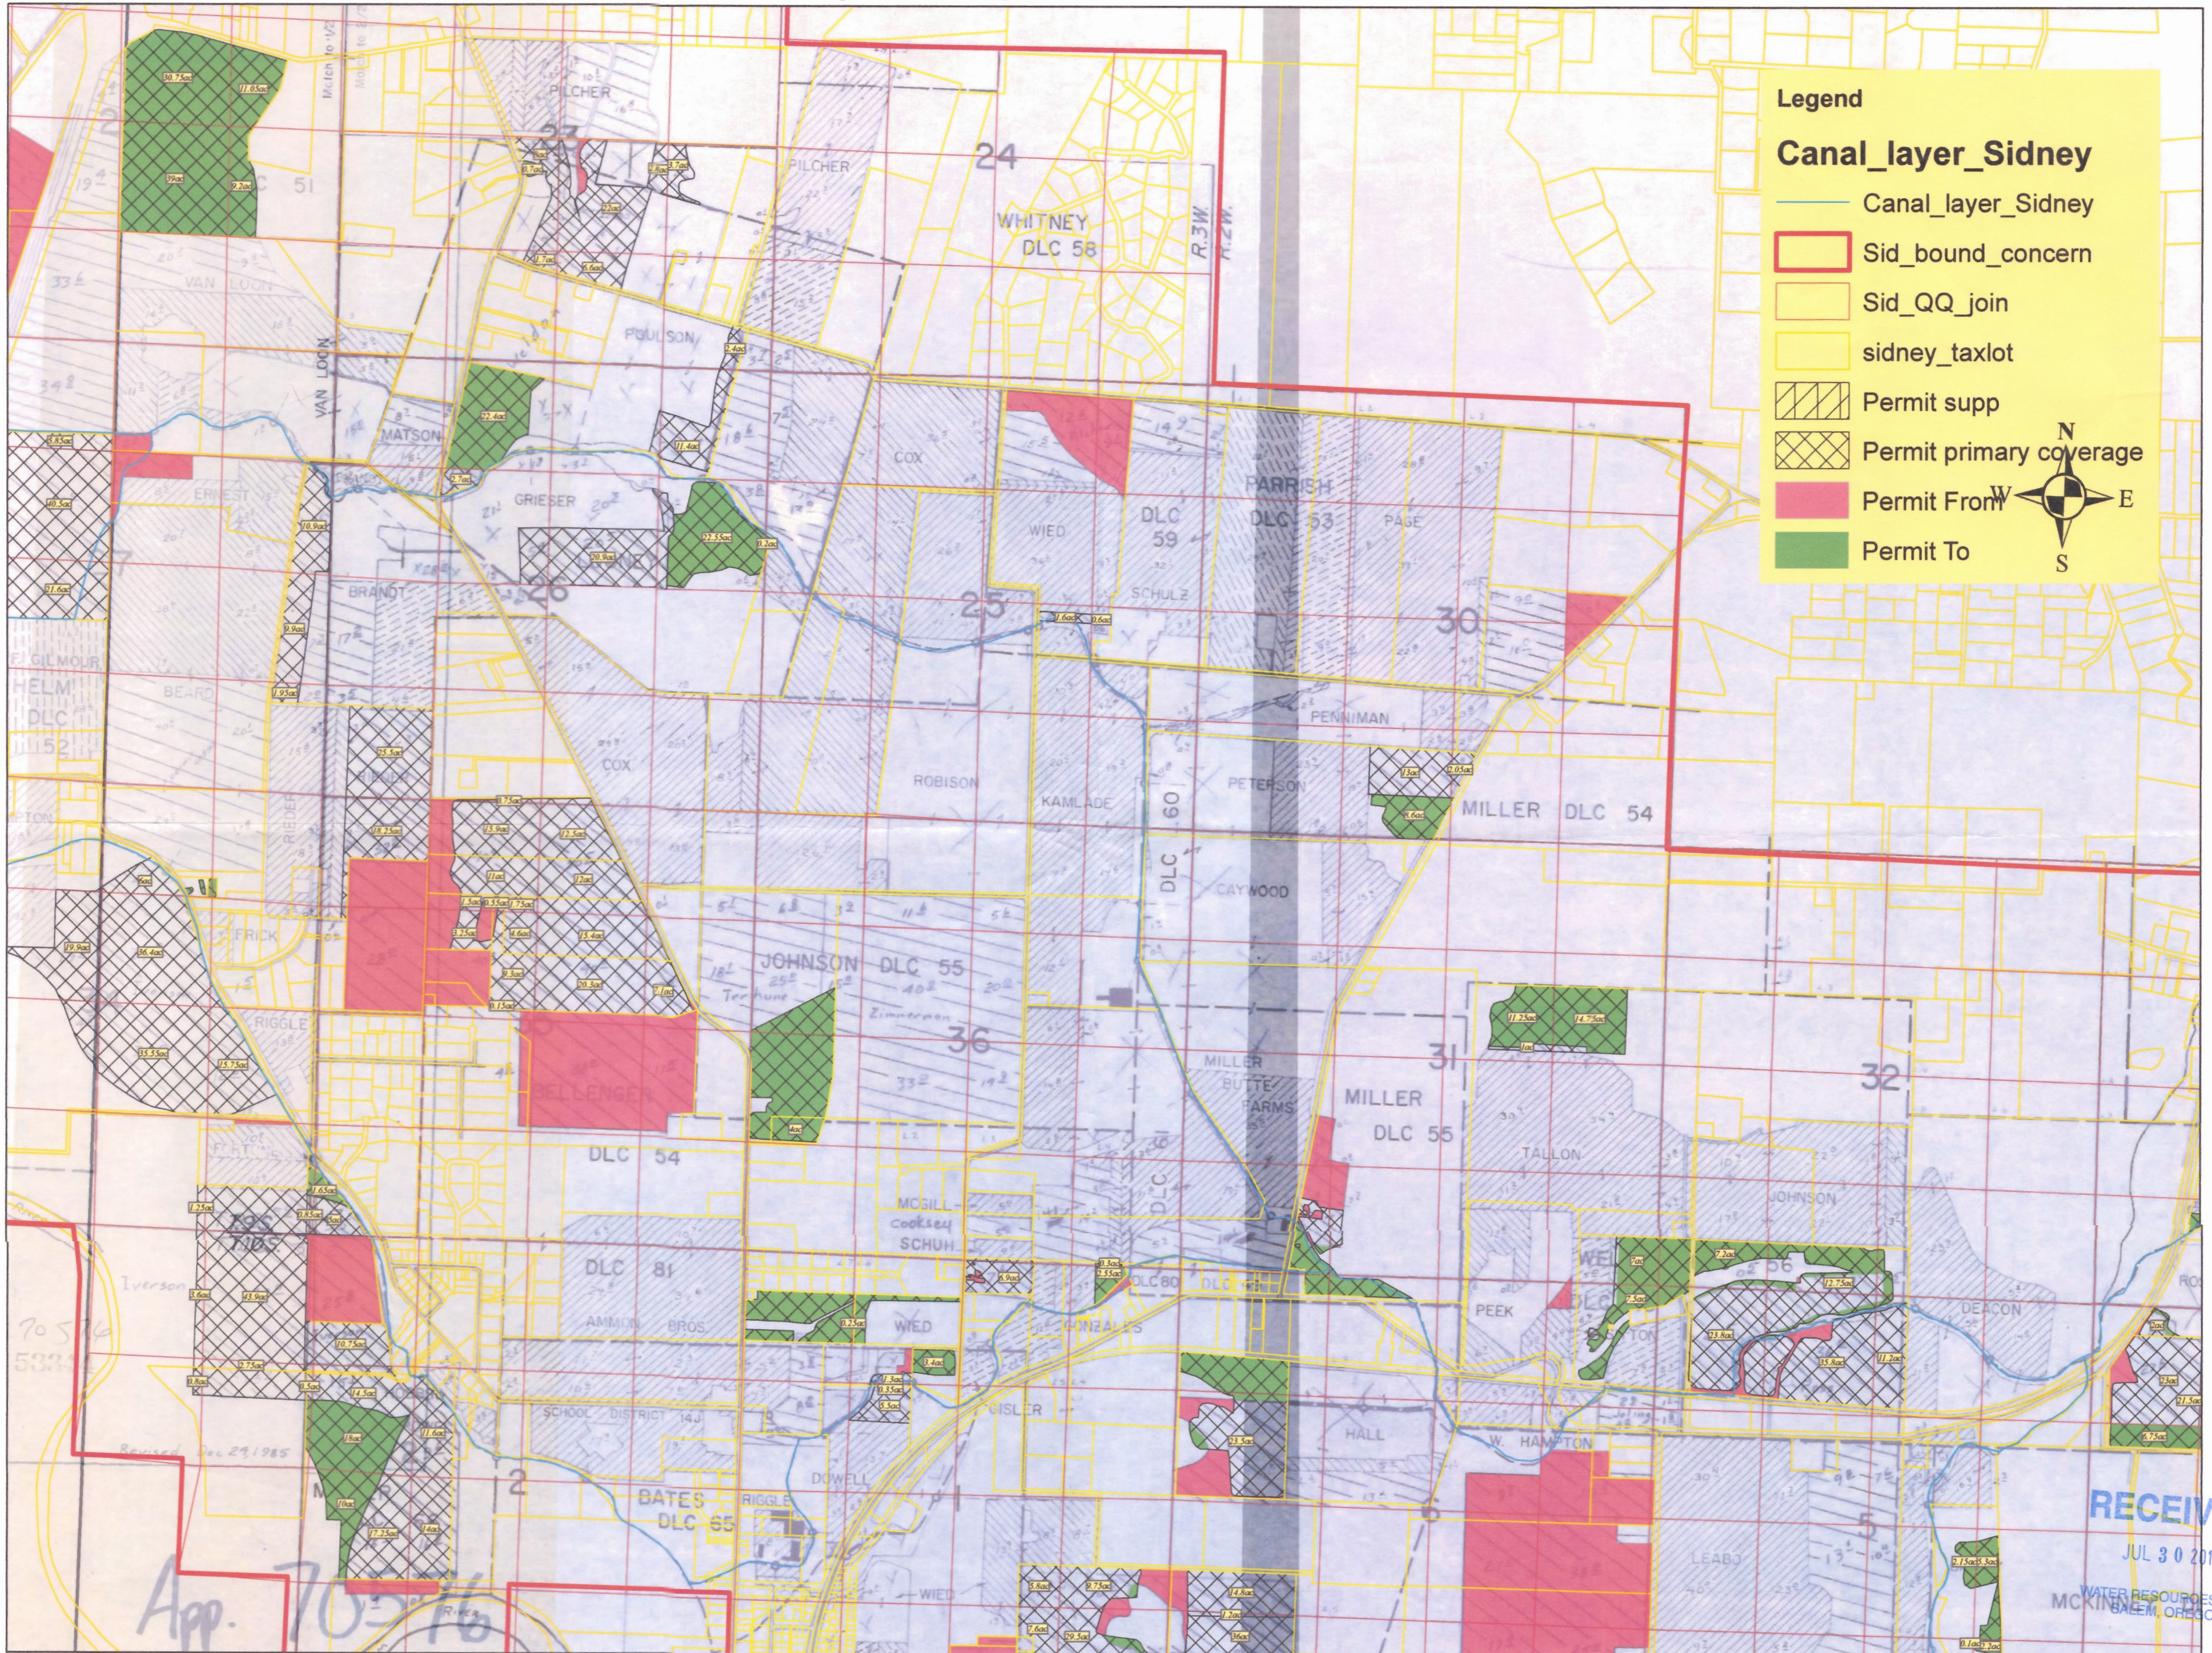

Legend

Canal_layer_Sidney

- Canal_layer_Sidney
- Sid_bound_concern
- Sid_QQ_join
- sidney_taxlot
- Permit supp
- Permit primary coverage
- Permit From
- Permit To

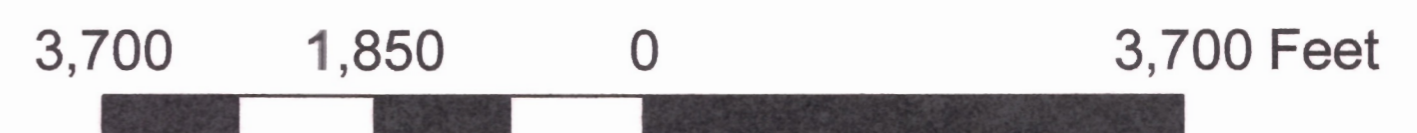

App. 70316


RECEIVED
JUL 30 2013
WATER RESOURCES DEPT

Sidney 1991 permit Certification

RECEIVED

JUL 30 2013


WATER RESOURCES DEPT
SALEM, OREGON

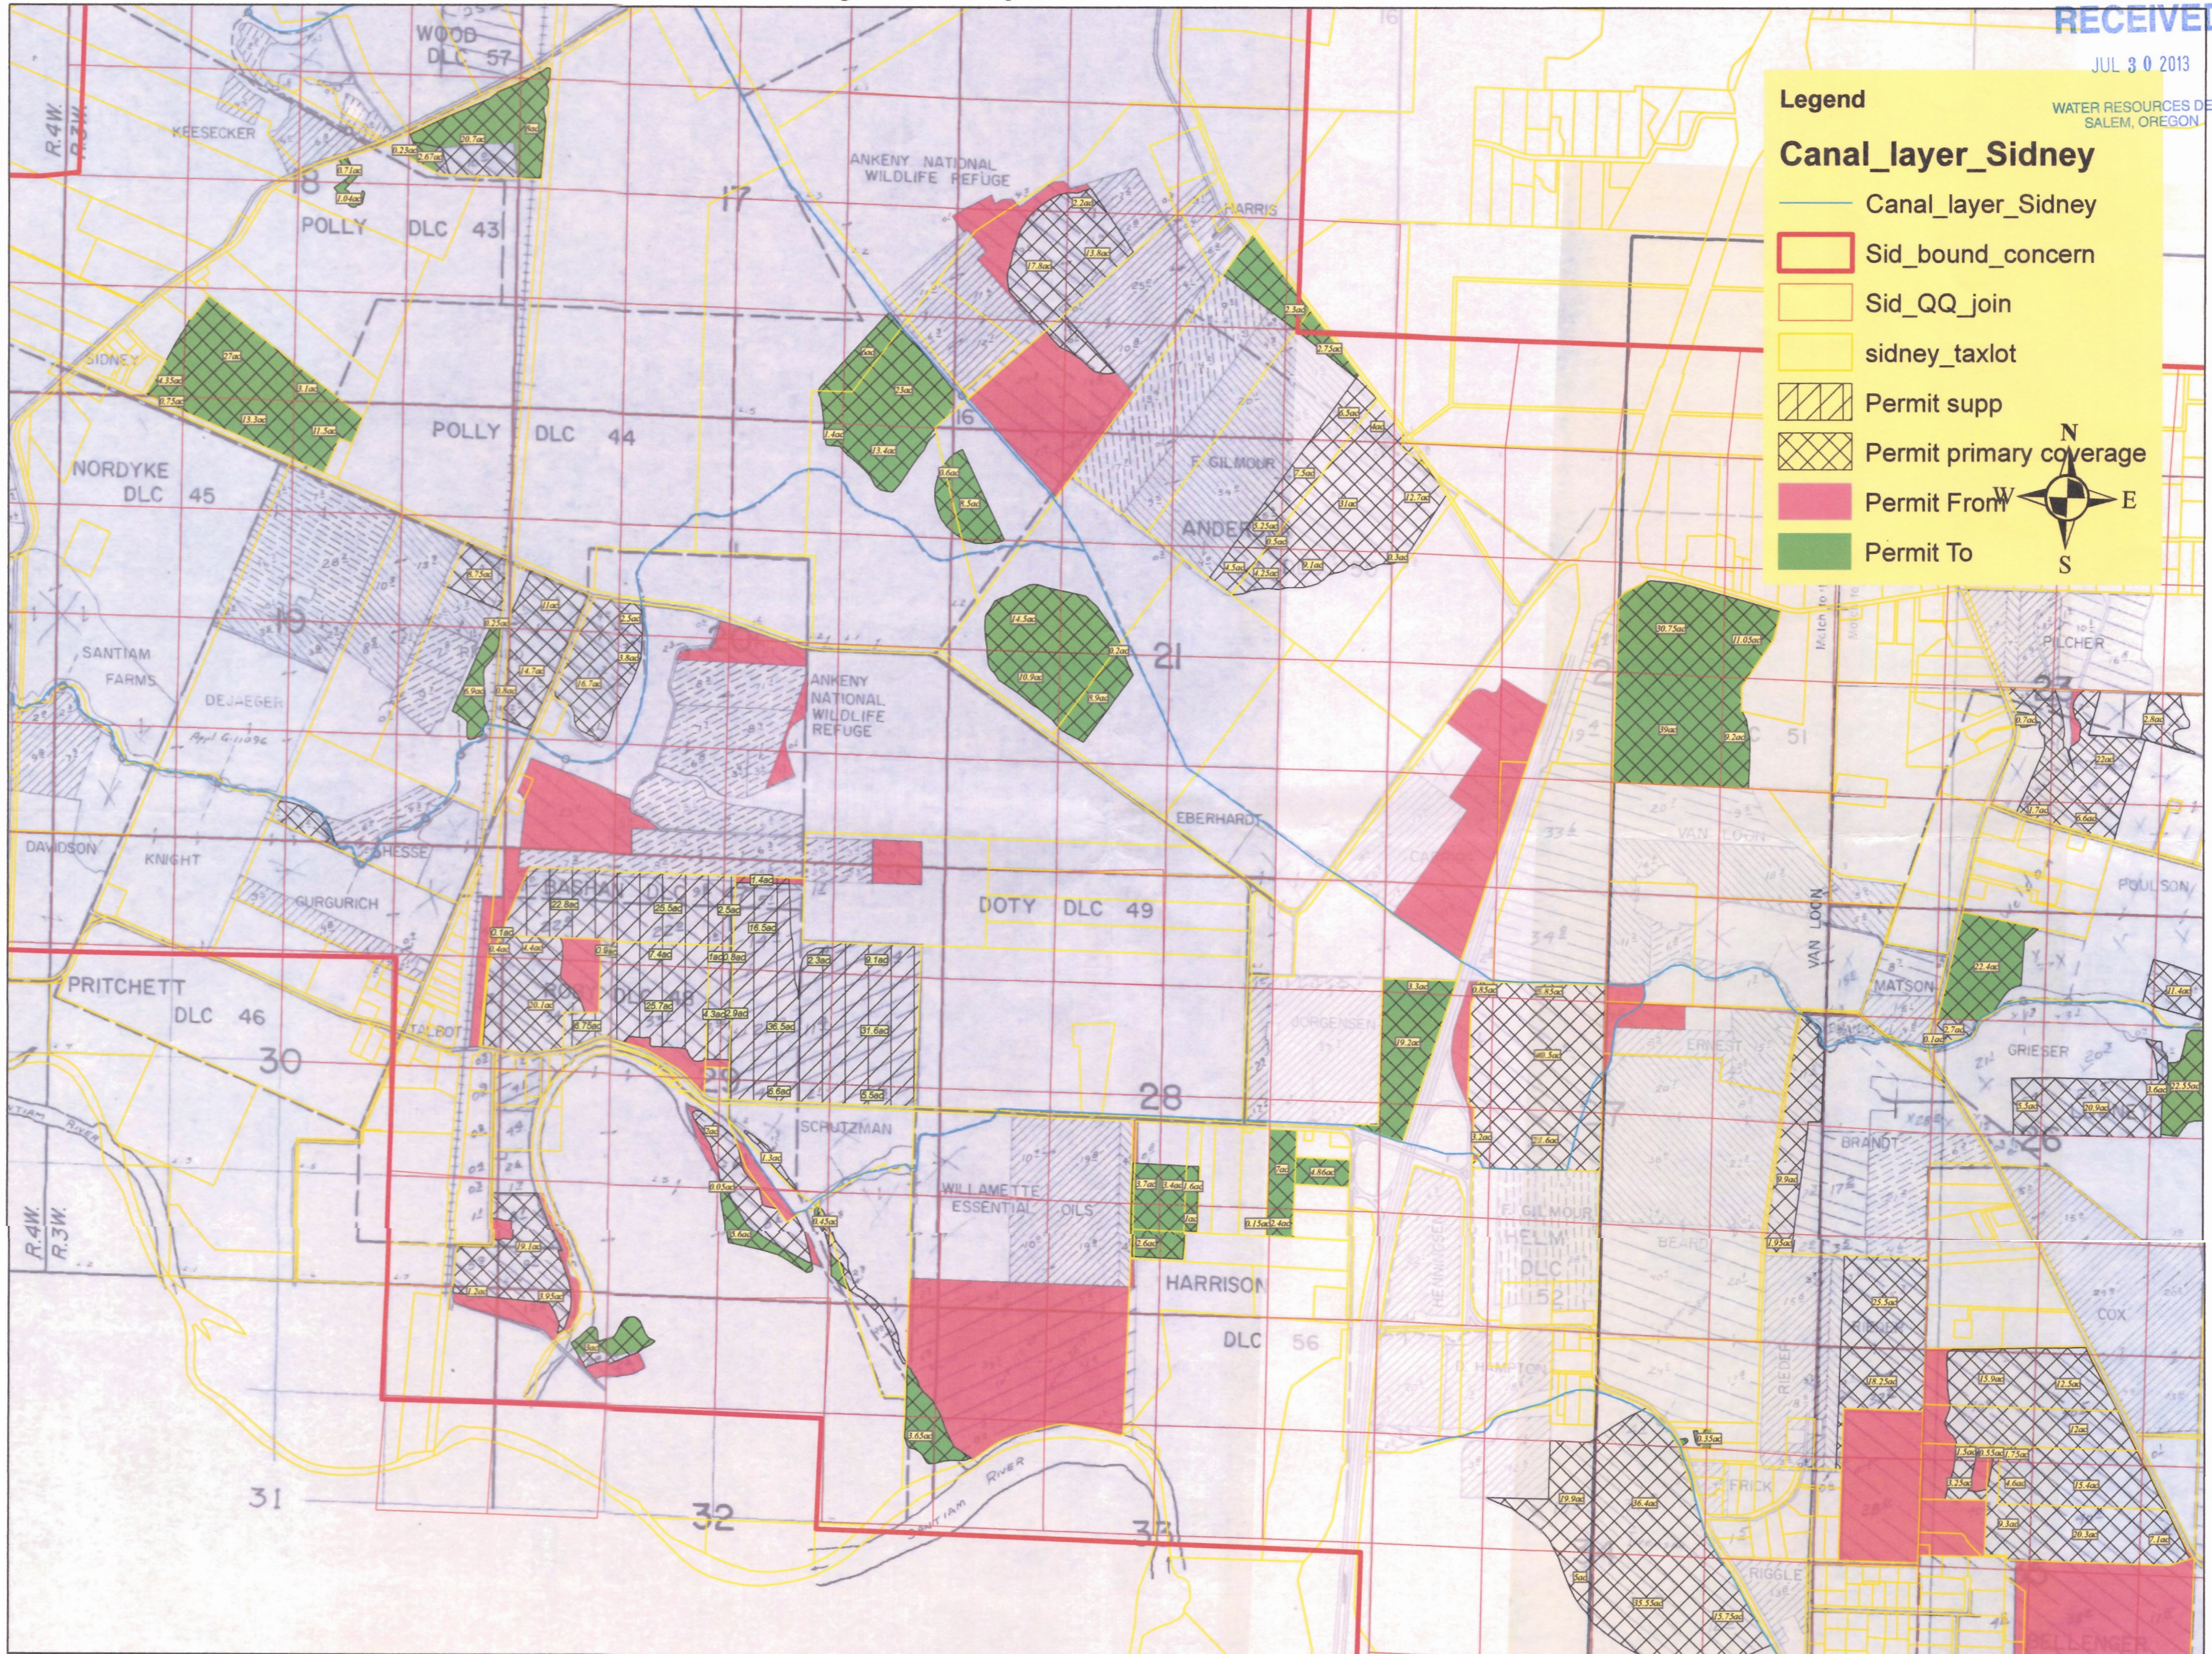


Legend

Canal_layer_Sidney

- Canal_layer_Sidney
- Sid_bound_concern
- Sid_QQ_join
- sidney_taxlot
- Permit supp
- Permit primary coverage
- Permit From
- Permit To

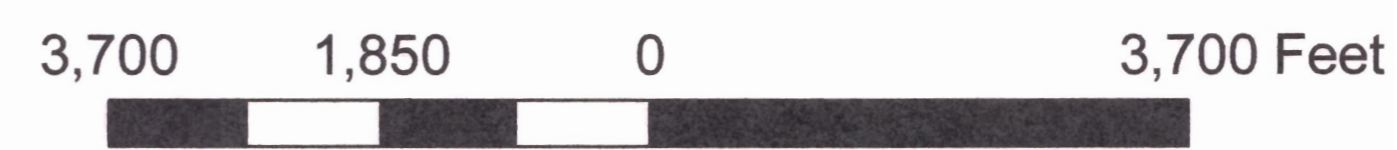

Sidney 1991 permit Certification

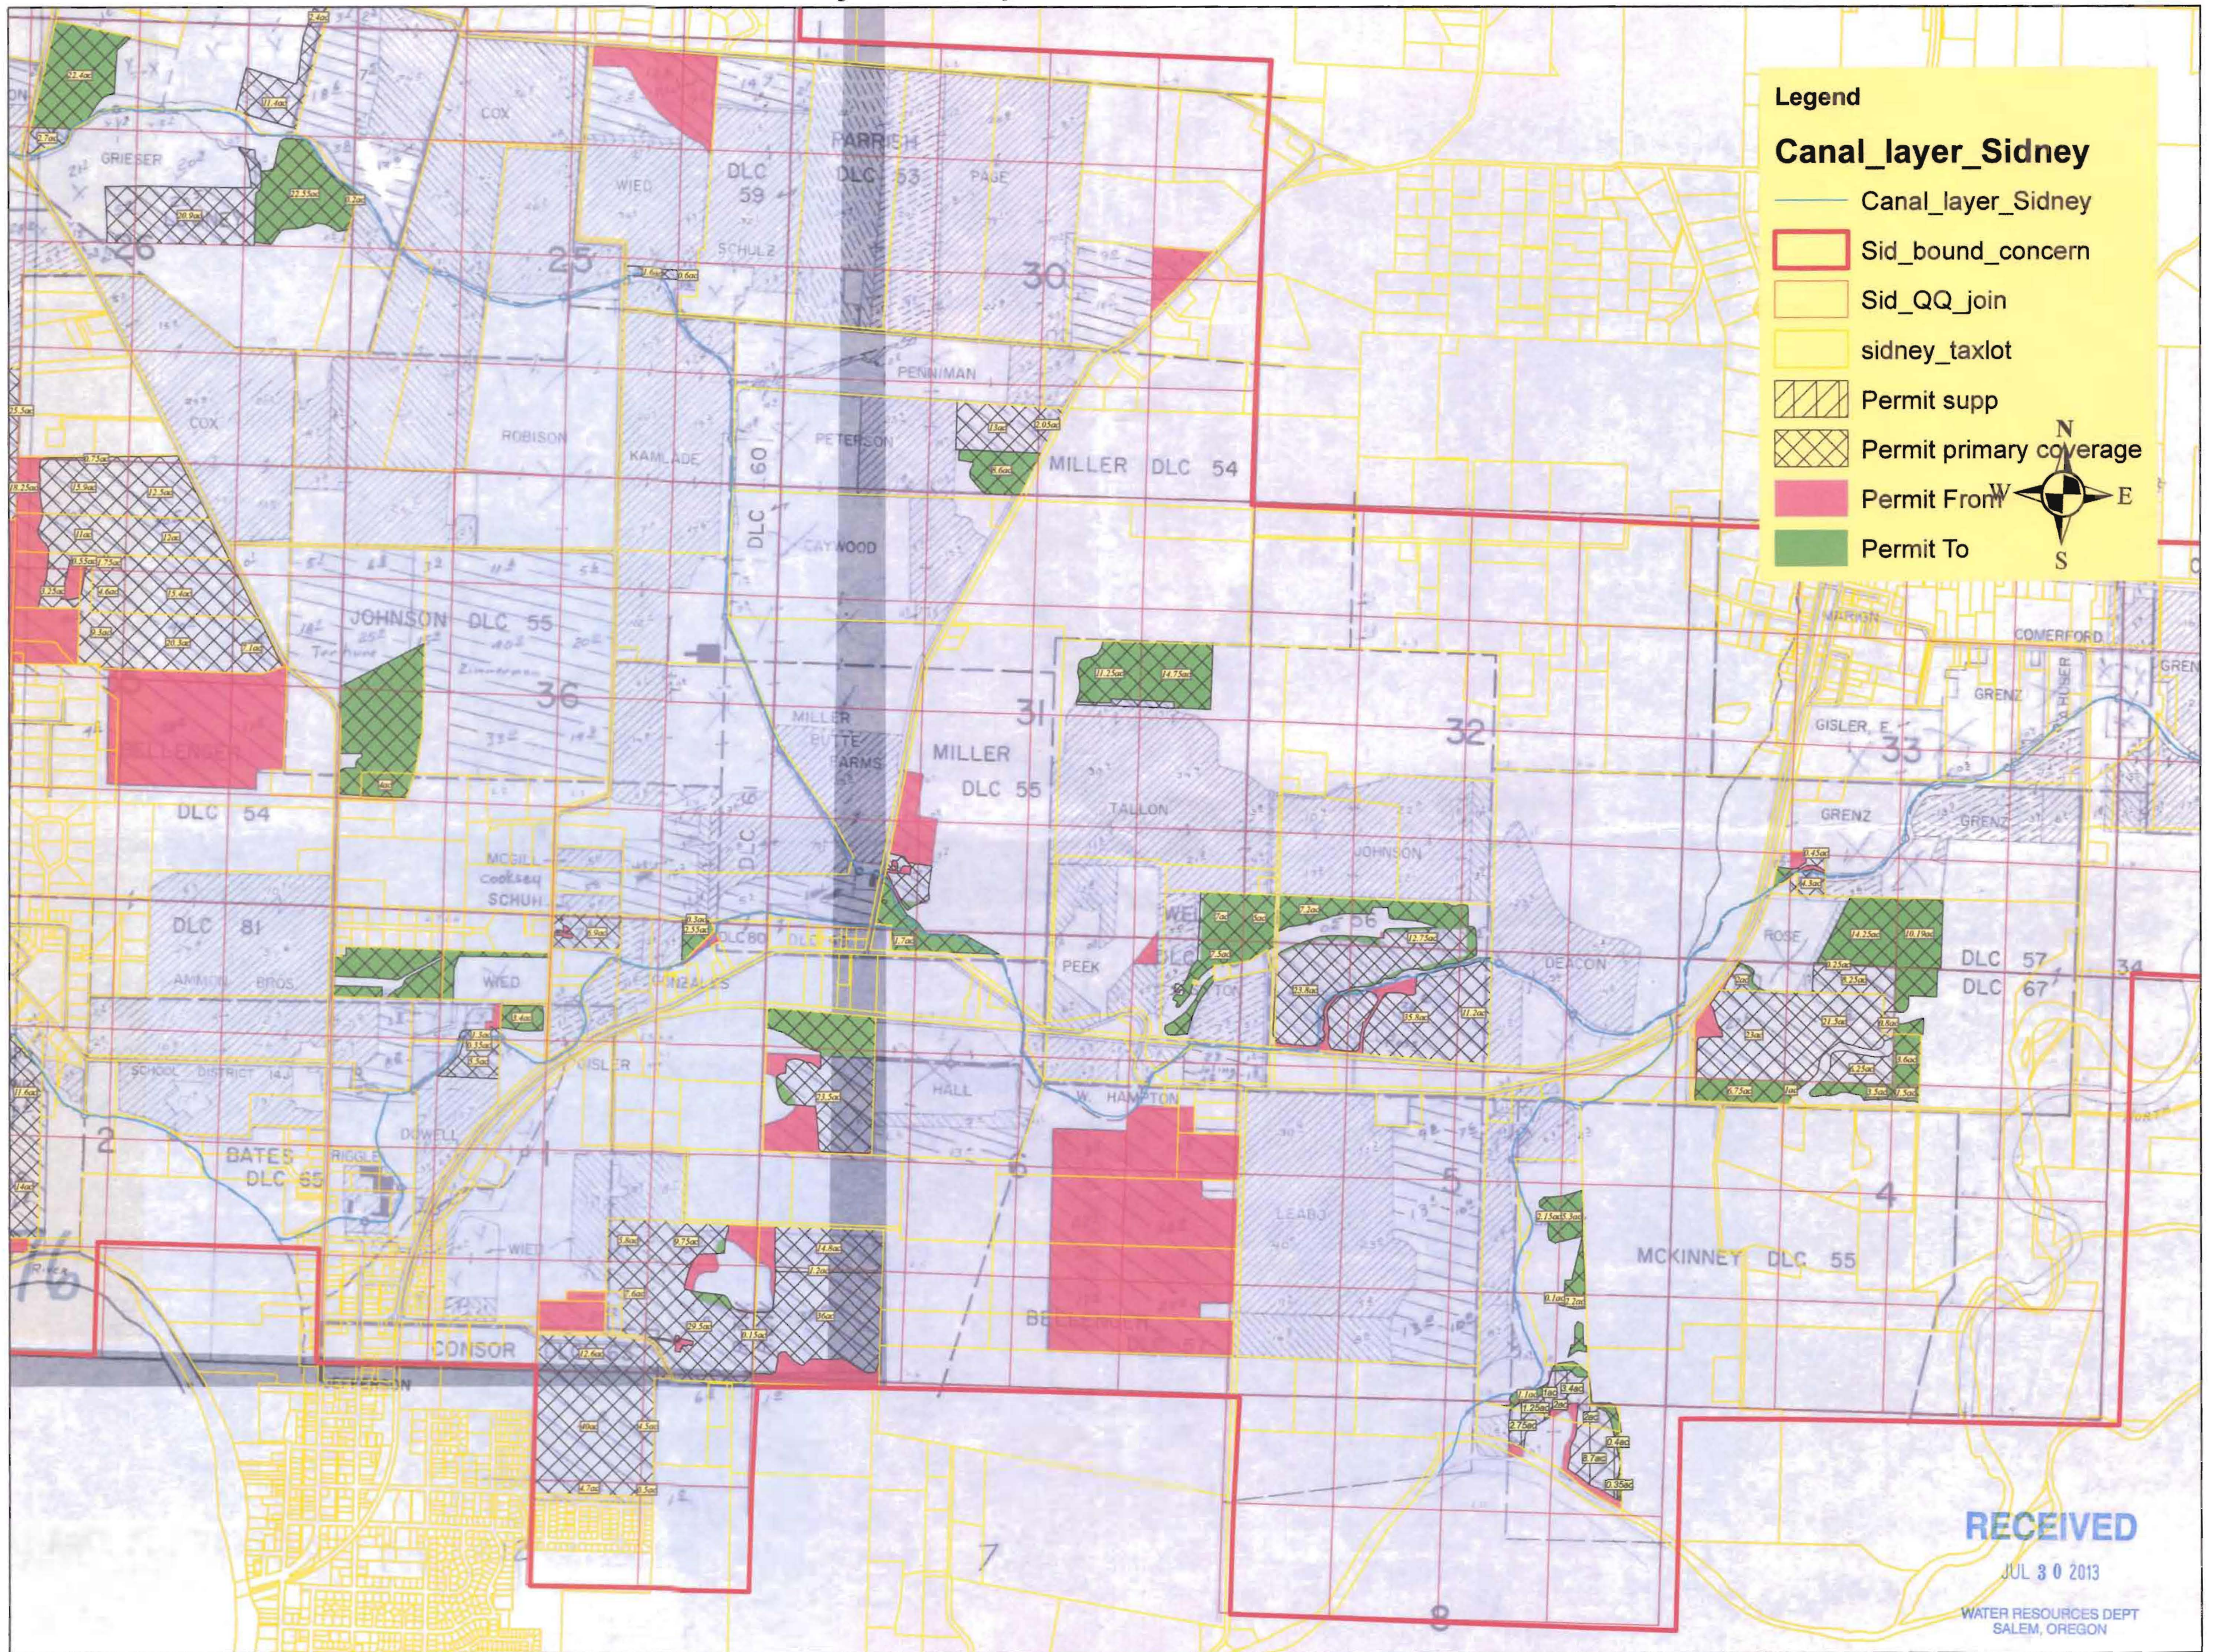

Legend

Canal_layer_Sidney

- Canal_layer_Sidney
- Sid_bound_concern
- Sid_QQ_join
- sidney_taxlot
- Permit supp
- Permit primary coverage
- Permit From
- Permit To

RECEIVED
JUL 30 2013
WATER RESOURCES DEPT
SALEM, OREGON

