


Hermiston Irrigation District
Cold Springs Reservoir
Townships 4 & 5 North, Range 29 East, W.M.


1 inch = 1320 feet

June 2013

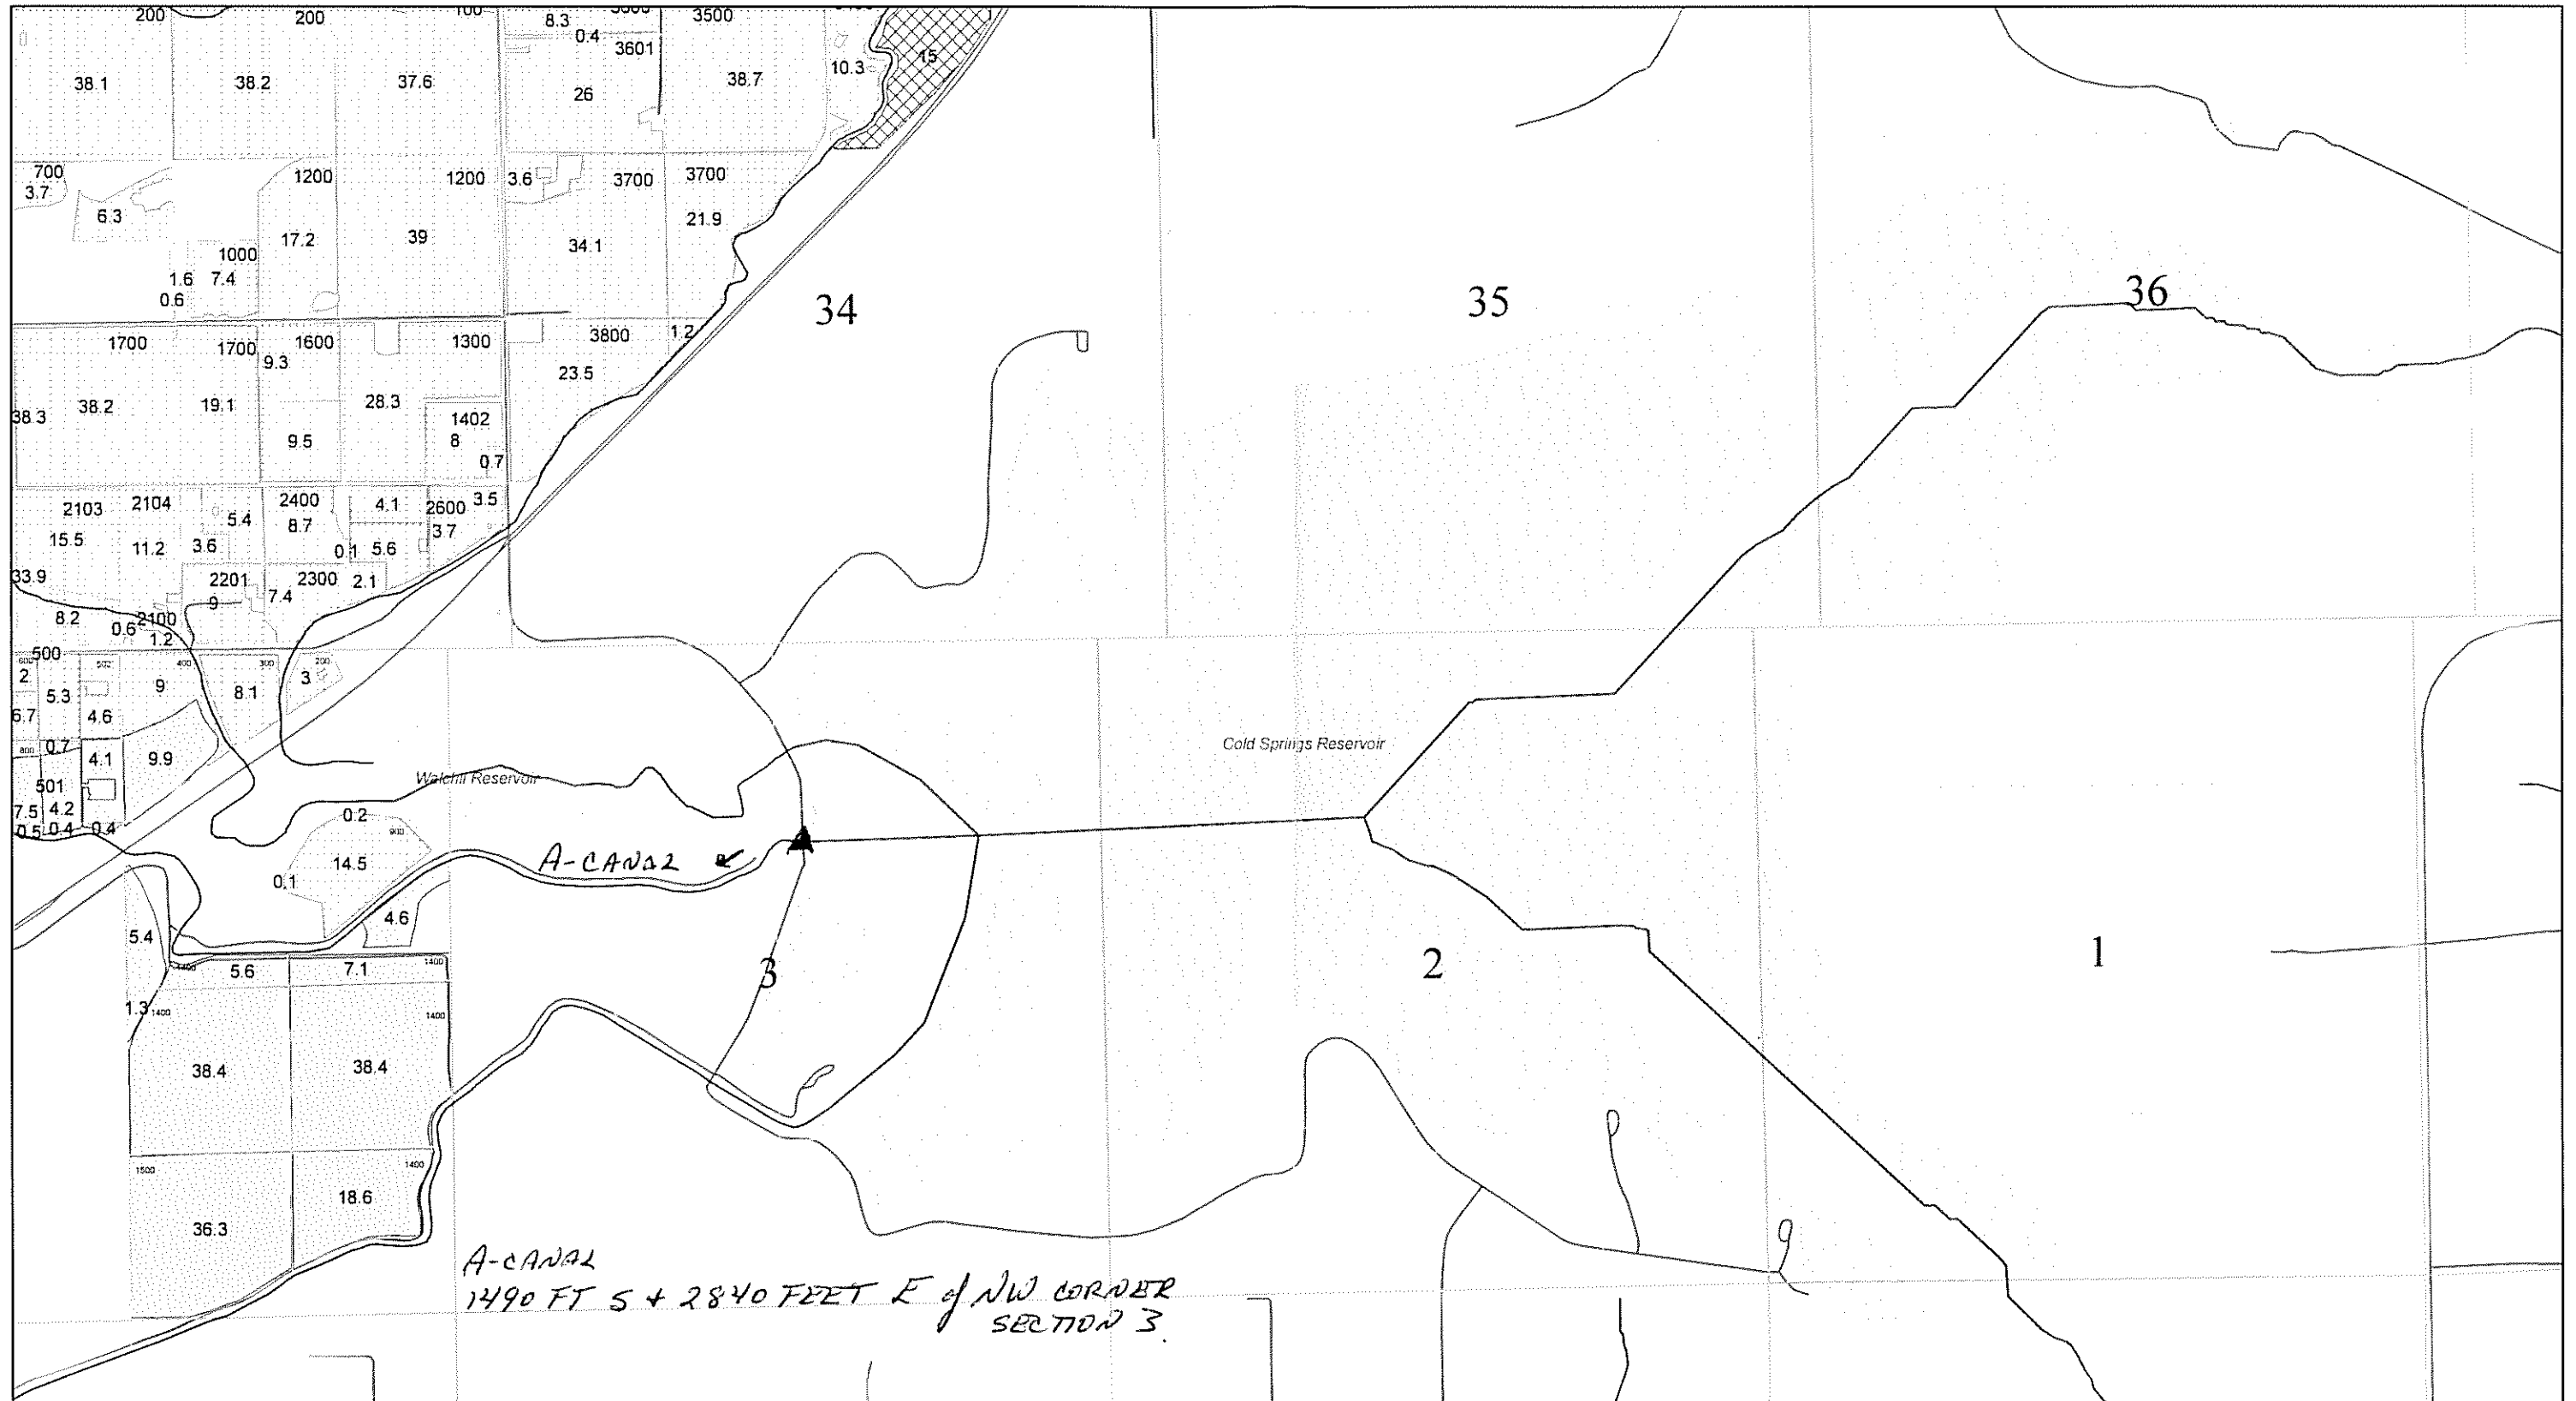

Hermiston Irrigation District

Township 5 North Range 29 East W.M.

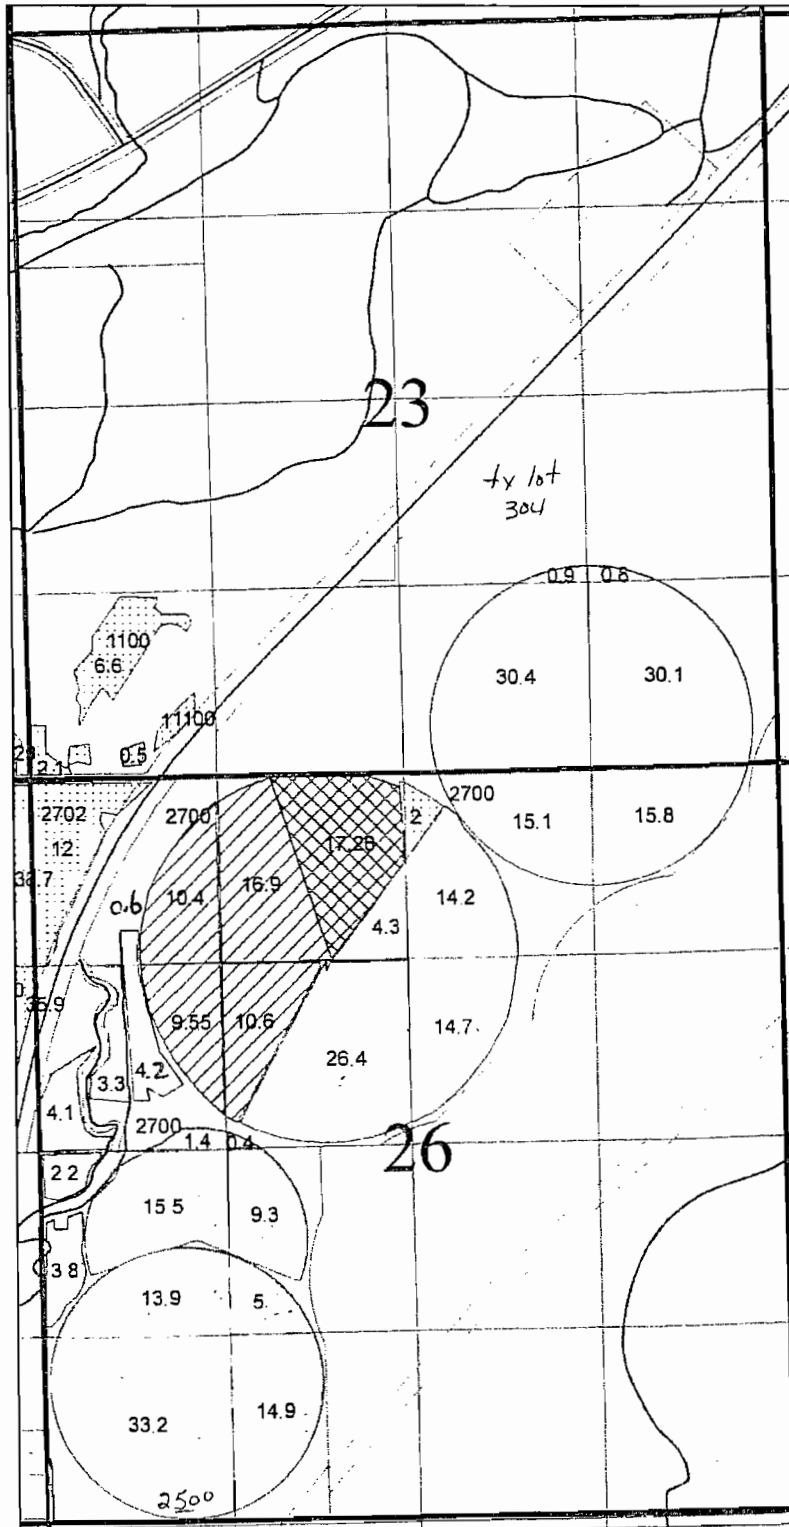

Legend

hd5n29e

USER_, DUTY

HID-A, 3

HID-A, 6

HID-M, 3

HID-M, 6

NEW, 3

1 in = 1,320 ft

RECEIVED BY OWNER


SEP 27 2013

SALEM, OR

Me

Hermiston Irrigation District

Township 5 North Range 29 East W.M.

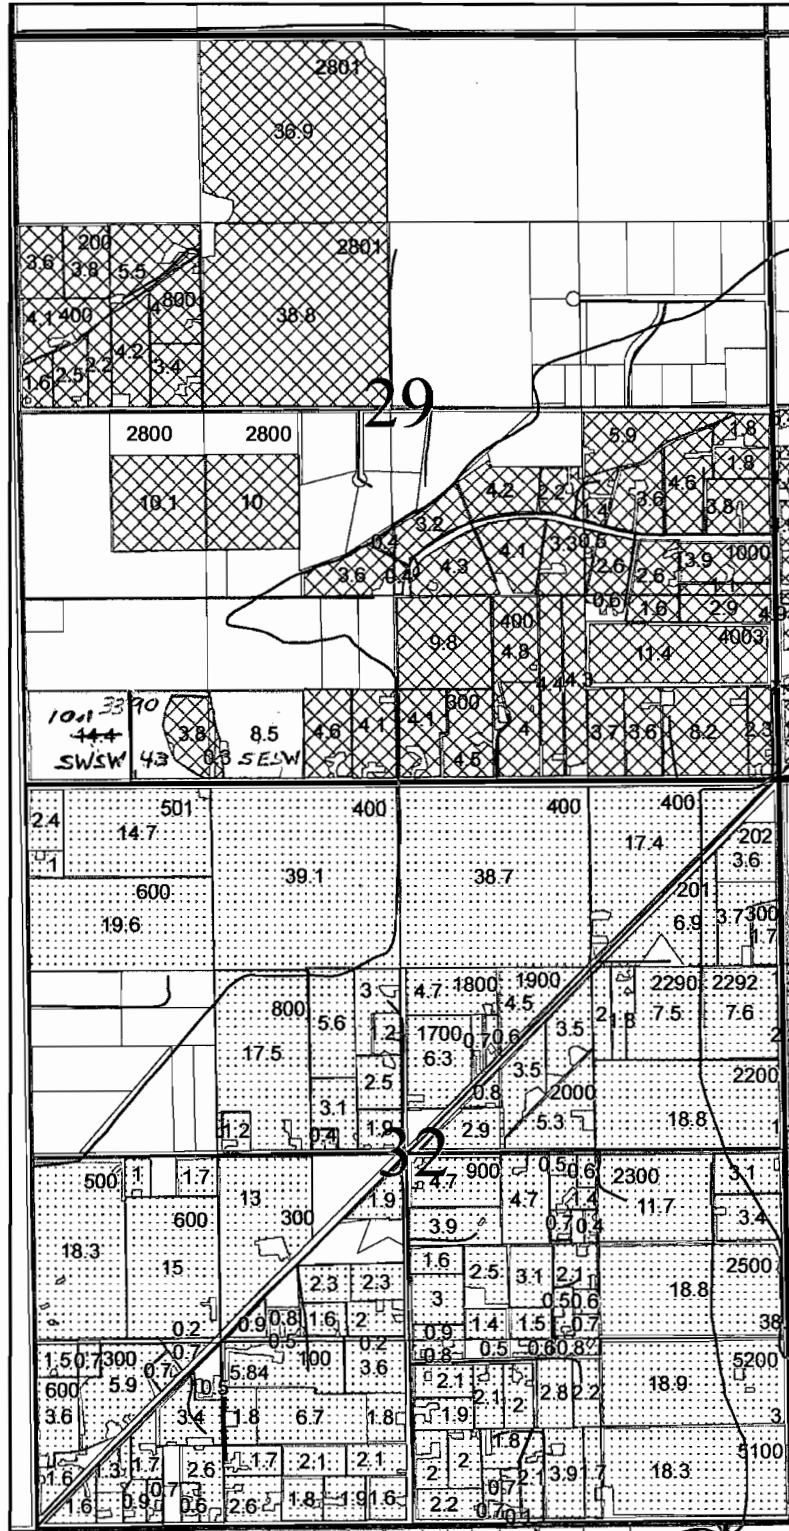

Legend

hd5n29e

USER, DUTY

-  HID-A, 3
-  HID-A, 6
-  HID-M, 3
-  HID-M, 6
-  NEW, 3

1 in = 1,320 ft

RECEIVED BY OWRC

RECEIVED

JUN 14 2013


SALEM, OR

S-87907

RECEIVED BY OWRD

JUN 14 2013

SALEM, OR

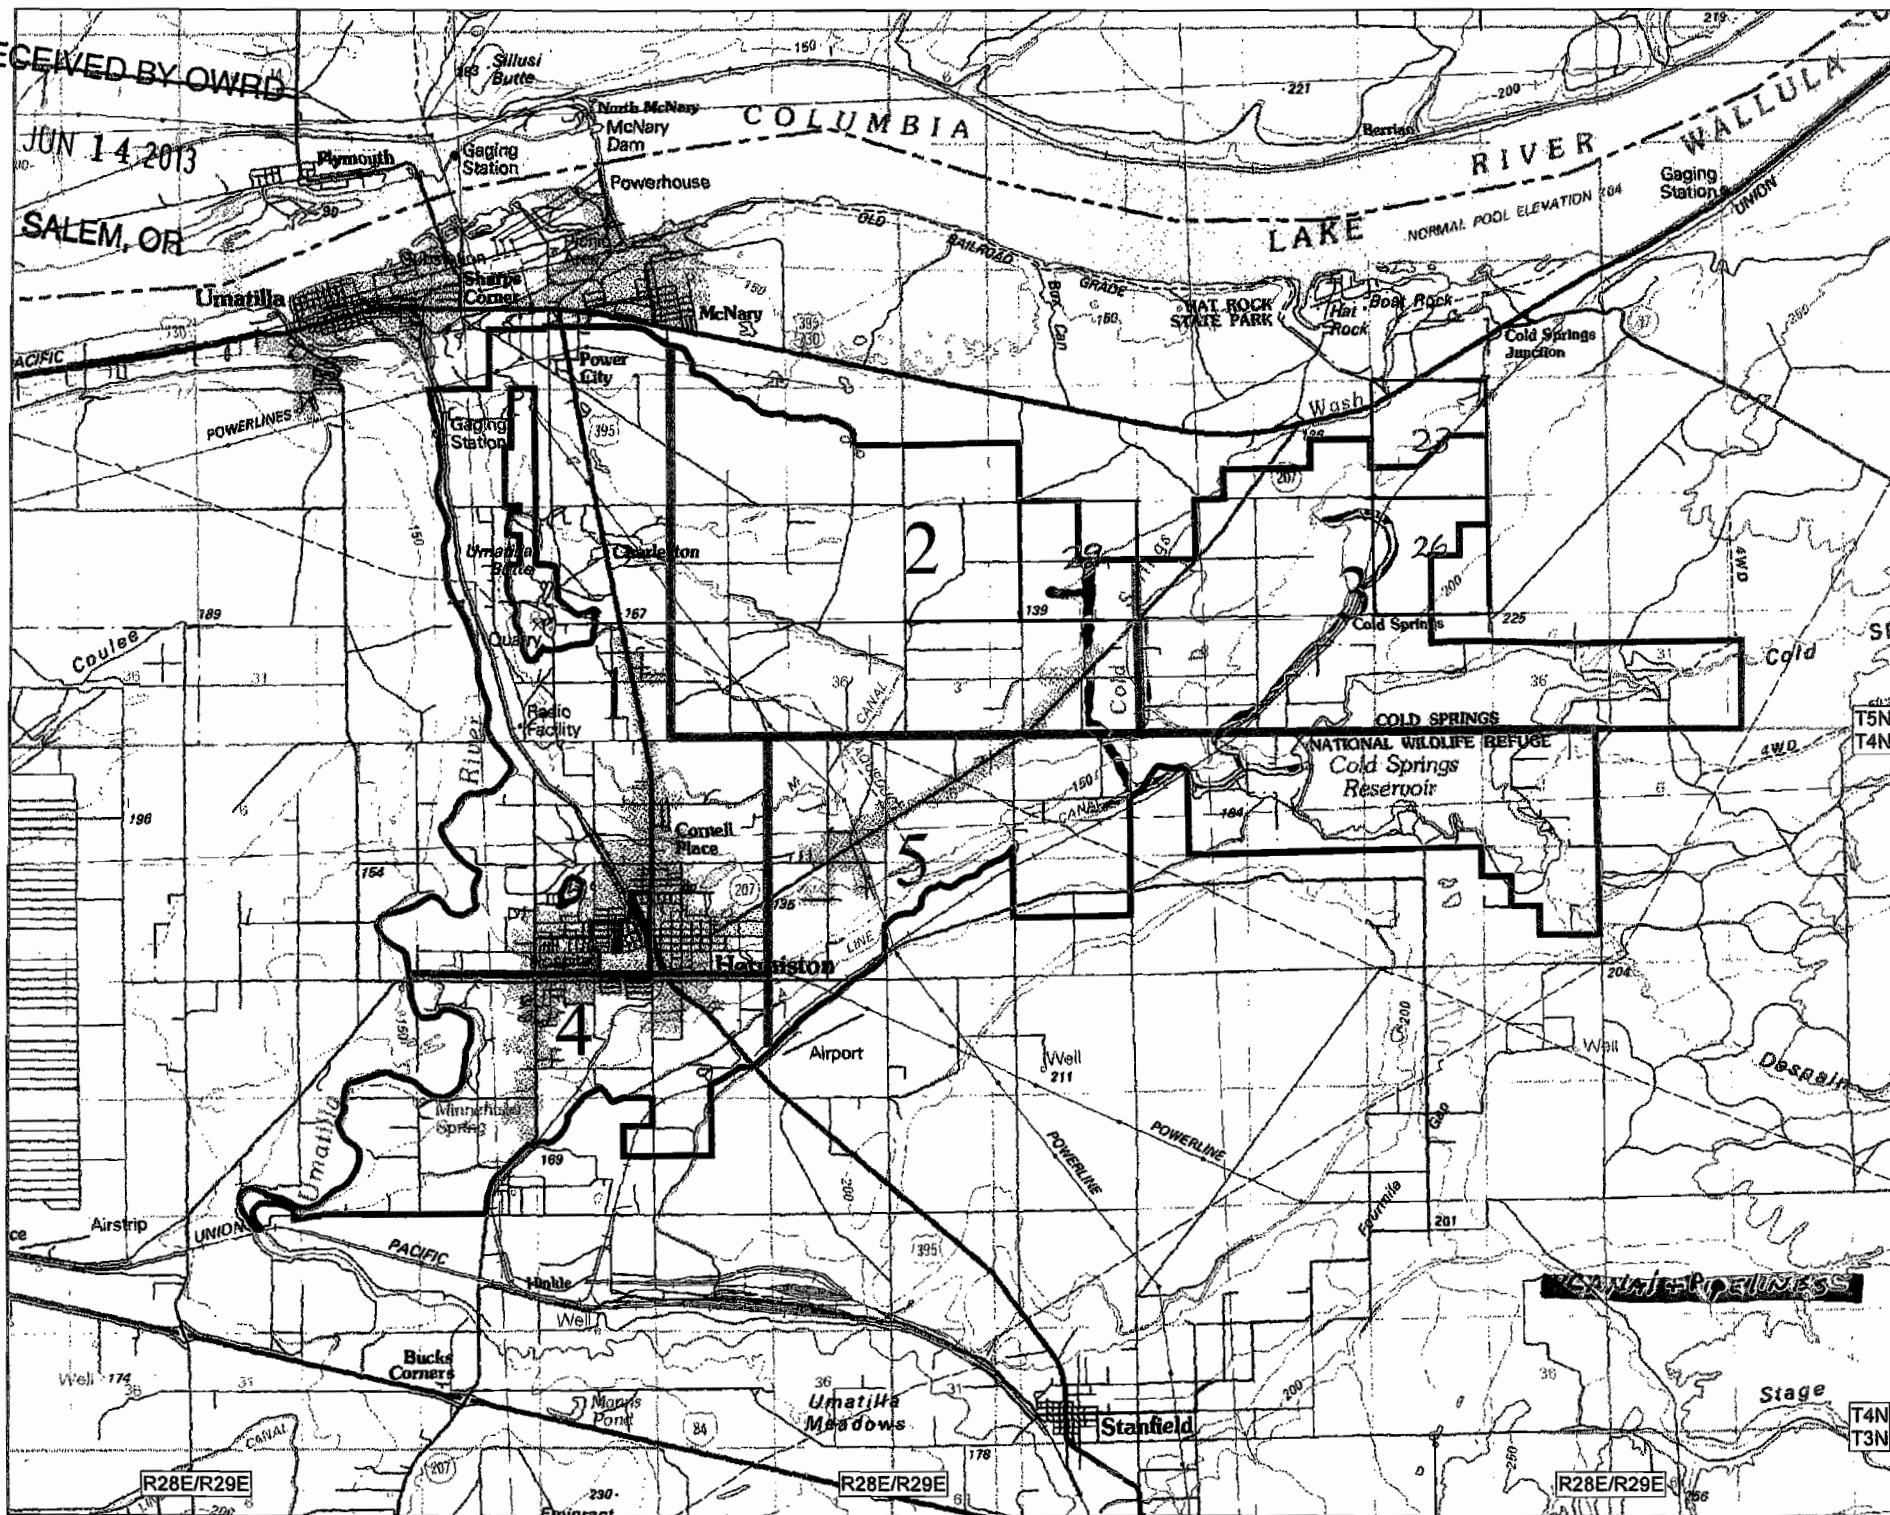

↑
N

706905