


# T37S R6W

## Sec 5

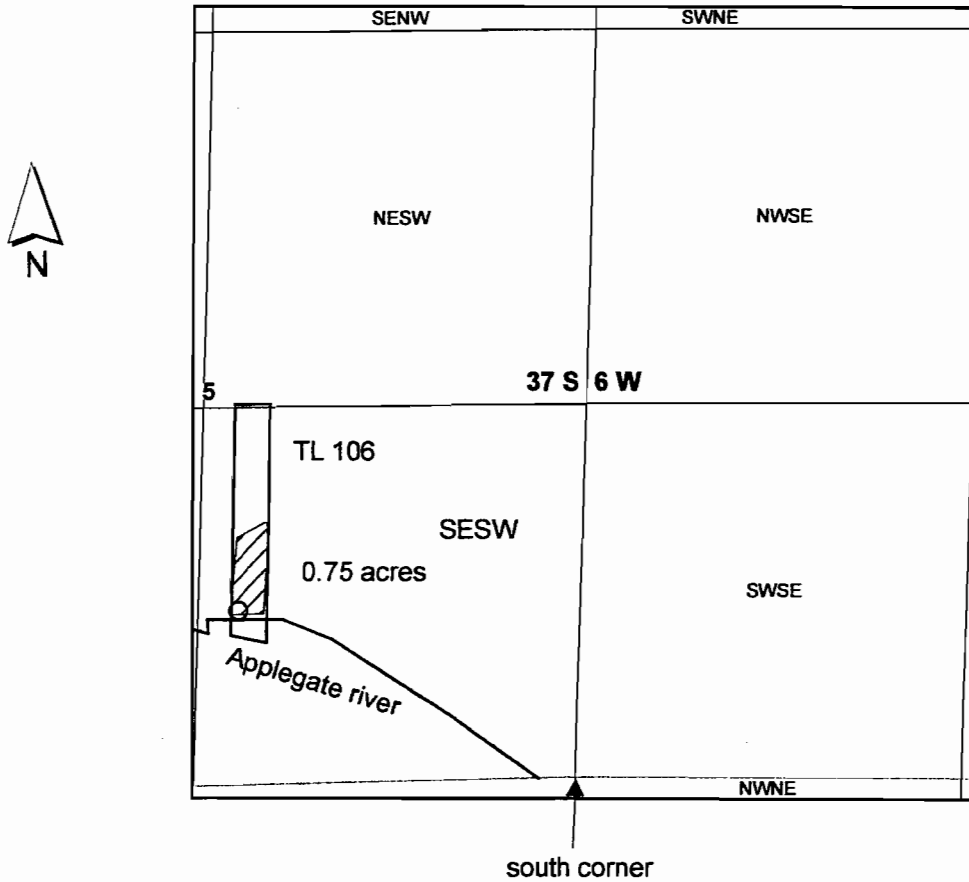

POD is 595 ft north and 1182 ft west from south corner.

RECEIVED BY OWRD

MAR 06 2013

SALEM, OR

(Applegate Reservoir is located in the  
S4/2 SE T40S R4W Sec 25) S-87876