

T. 3 S. R. 2 W. W. M.

N

Tabulated Acres

NE, SW 2.5

SE, SW 20.0

SE, SE 12.5

Section 27

NW, NW 22.0

SW, NW 6.75

NE, NE 13.0

SW, NE 5.5

NE, NW 14.1



SE, NW 6.0

NW, NE 15.0

SE, NE 0.2

Section 34

T. 3 S. R. 2 W TL 100

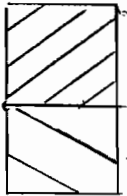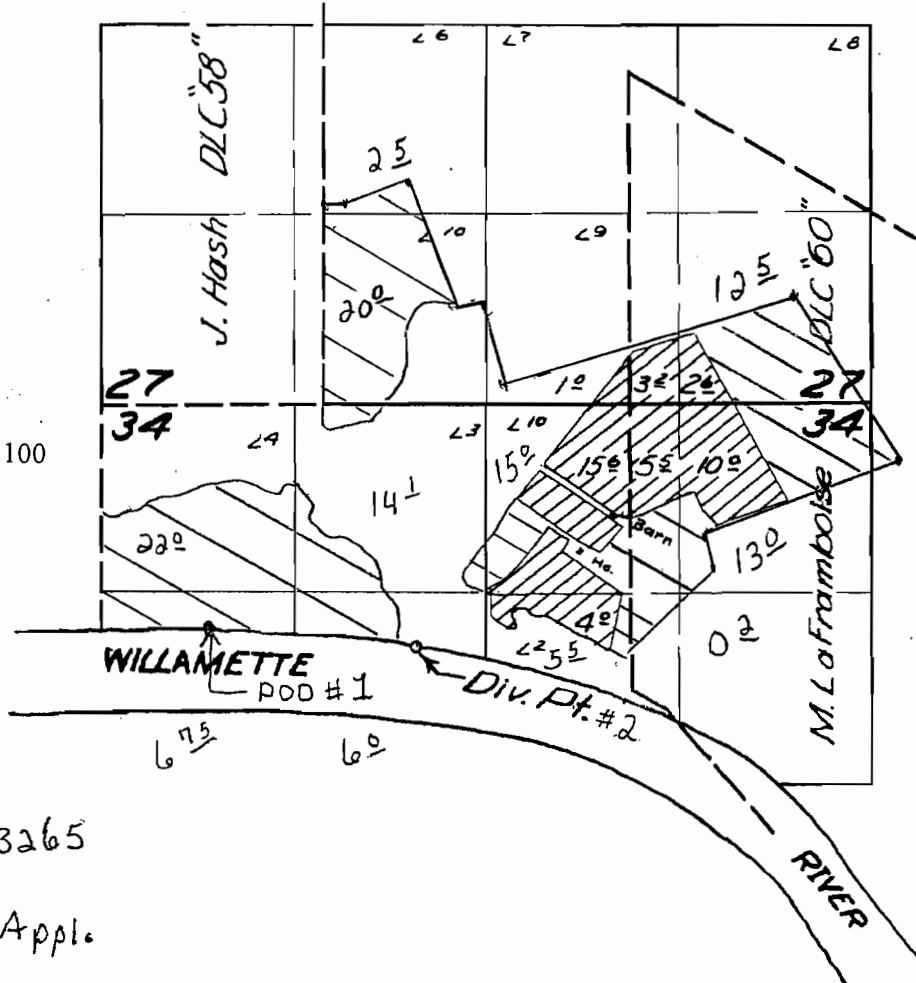

FINAL PROOF SURVEY

UNDER

POD #1 1545' S. and 845' E.
POD #2 1630' S. and 2170' E.
From NW Cor. Sec. 34

Application No. 28509 Permit No. 22318

IN NAME OF

C. M. Bishop

Surveyed Mar. 19 1956, by Tom Bishop

1" = 1320'

DFQ-2D-3

RECEIVED BY OWRD

MAY 06 2013

SALEM, OR

S-87897