
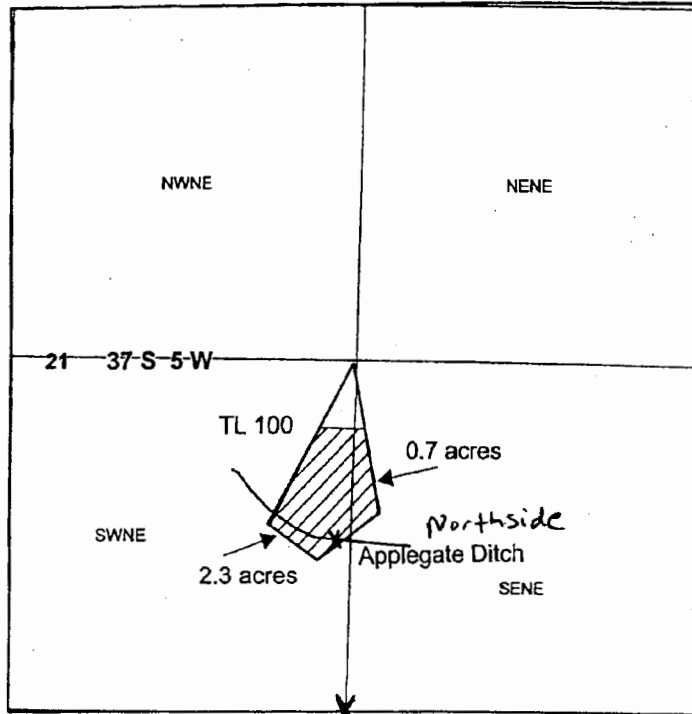


app: S 87689  
 @ LASSER

T37S R5W Sec 21

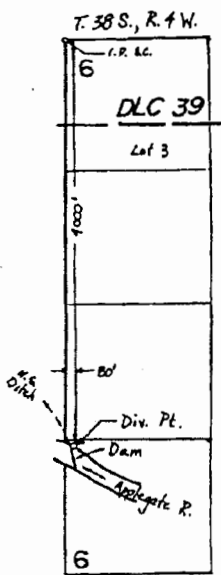


RECEIVED  
 APR 06 2011  
 WATER RESOURCES DIVISION  
 SALEM, OREGON

location of pump X measured from this point



1 inch = 660 feet

660 ft north of X  
 41.25 feet west of point  
 where ditch crosses  
 midline

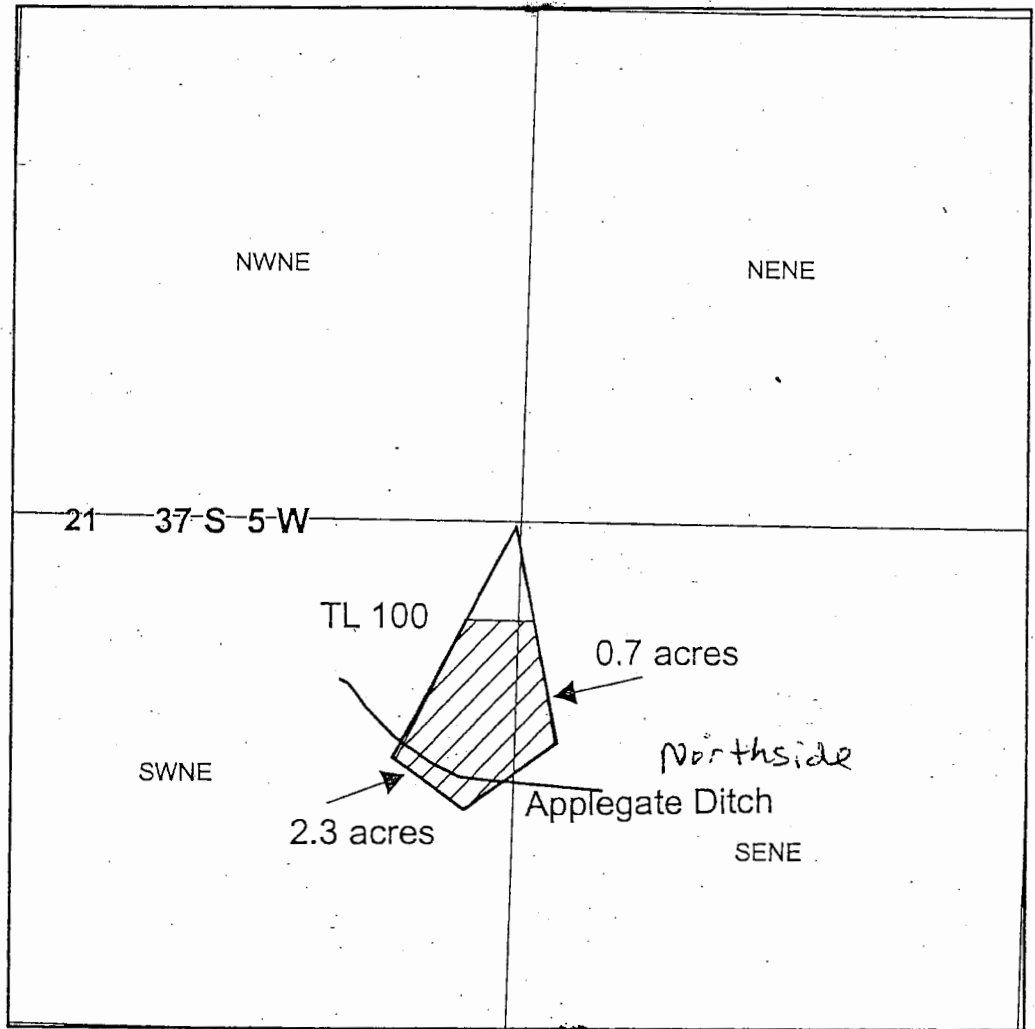

Approx 1" = 500 Feet  
Created by our staff

# T37S R5W Sec 21

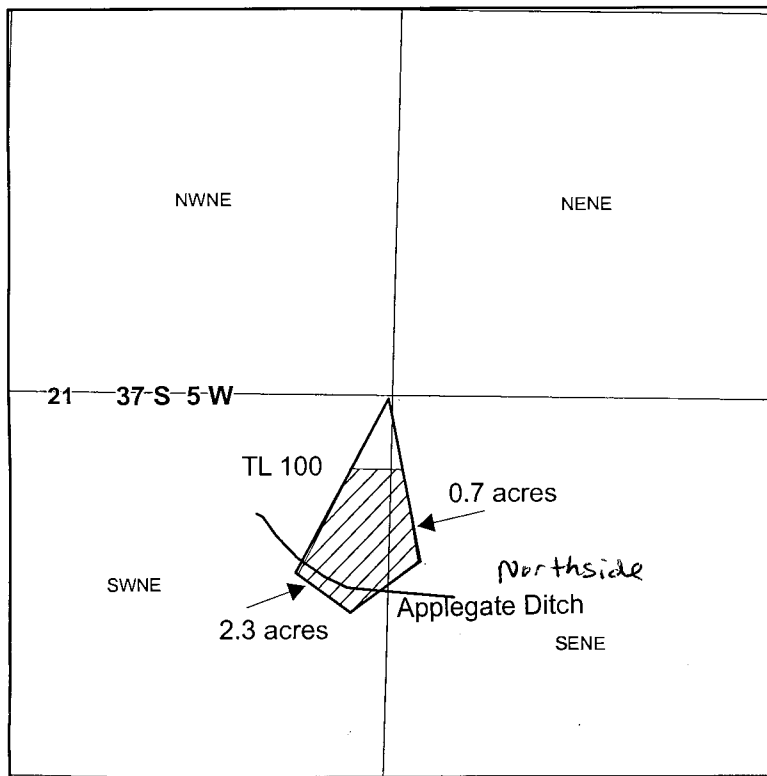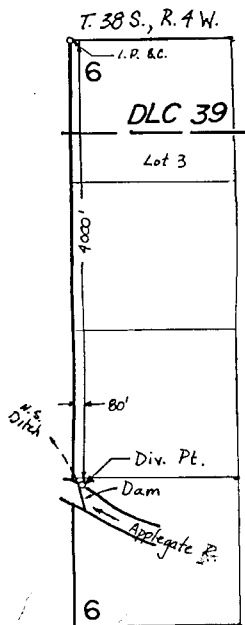

1 inch = 660 feet

**RECEIVED**

FEB 07 2011

WATER RESOURCES DEPT  
SALEM, OREGON

S-87689