


FINAL PROOF MAP T-8950
NE1/4NE1/4, SEC. 4, T.39S., R.3W., W.M.
JACKSON COUNTY, OREGON
FOR
JOHN RINALDI JR. AND BONNIE RINALDI
375 HAMILTON ROAD
JACKSONVILLE, OR 97530

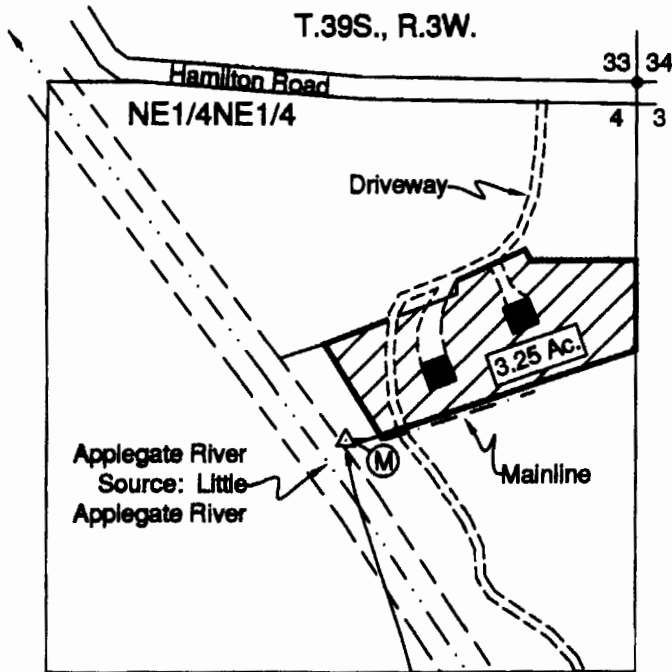


Scale: 1"=400'
Date: August 30, 2006
Revised: August 31, 2010



Point of Diversion No. 1
800' South and 650' West
of the Northeast Corner,
Section 4.
Fish Screen at
Point of Diversion

LEGEND

- Found Survey Monument
- Denotes Building
- ▨ Denotes Area Under Special Order Volume 64, Pages 453-456, Priority Date Sept. 1, 1857
- Ⓜ Denotes Flow Meter

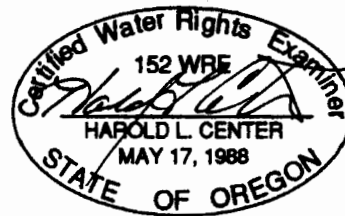

RECEIVED

HAROLD L. CENTER
2604 David Lane
Medford, OR. 97504
Phone 541-535-6108
Oregon Certificate No. 152
Certificate Renewal Date: 12/31/2011

SEP 07 2010

WATER RESOURCES DEPT
SALEM, OREGON

This map was prepared for the purpose of identifying the location of a water right only and is not intended to provide legal dimensions or location of property ownership.

RECEIVED BY OWRD

FEB 10 2014

SALEM, OR