

T 18 S, R 2 W Sec 30

SE 1/4 NE 1/4 T 1701

POD is 630' North and

950' West of NE cor

Templeton DLC

Scale 1" = 300'


RECEIVED

JAN 31 2014

OWRD



Kristine Keever

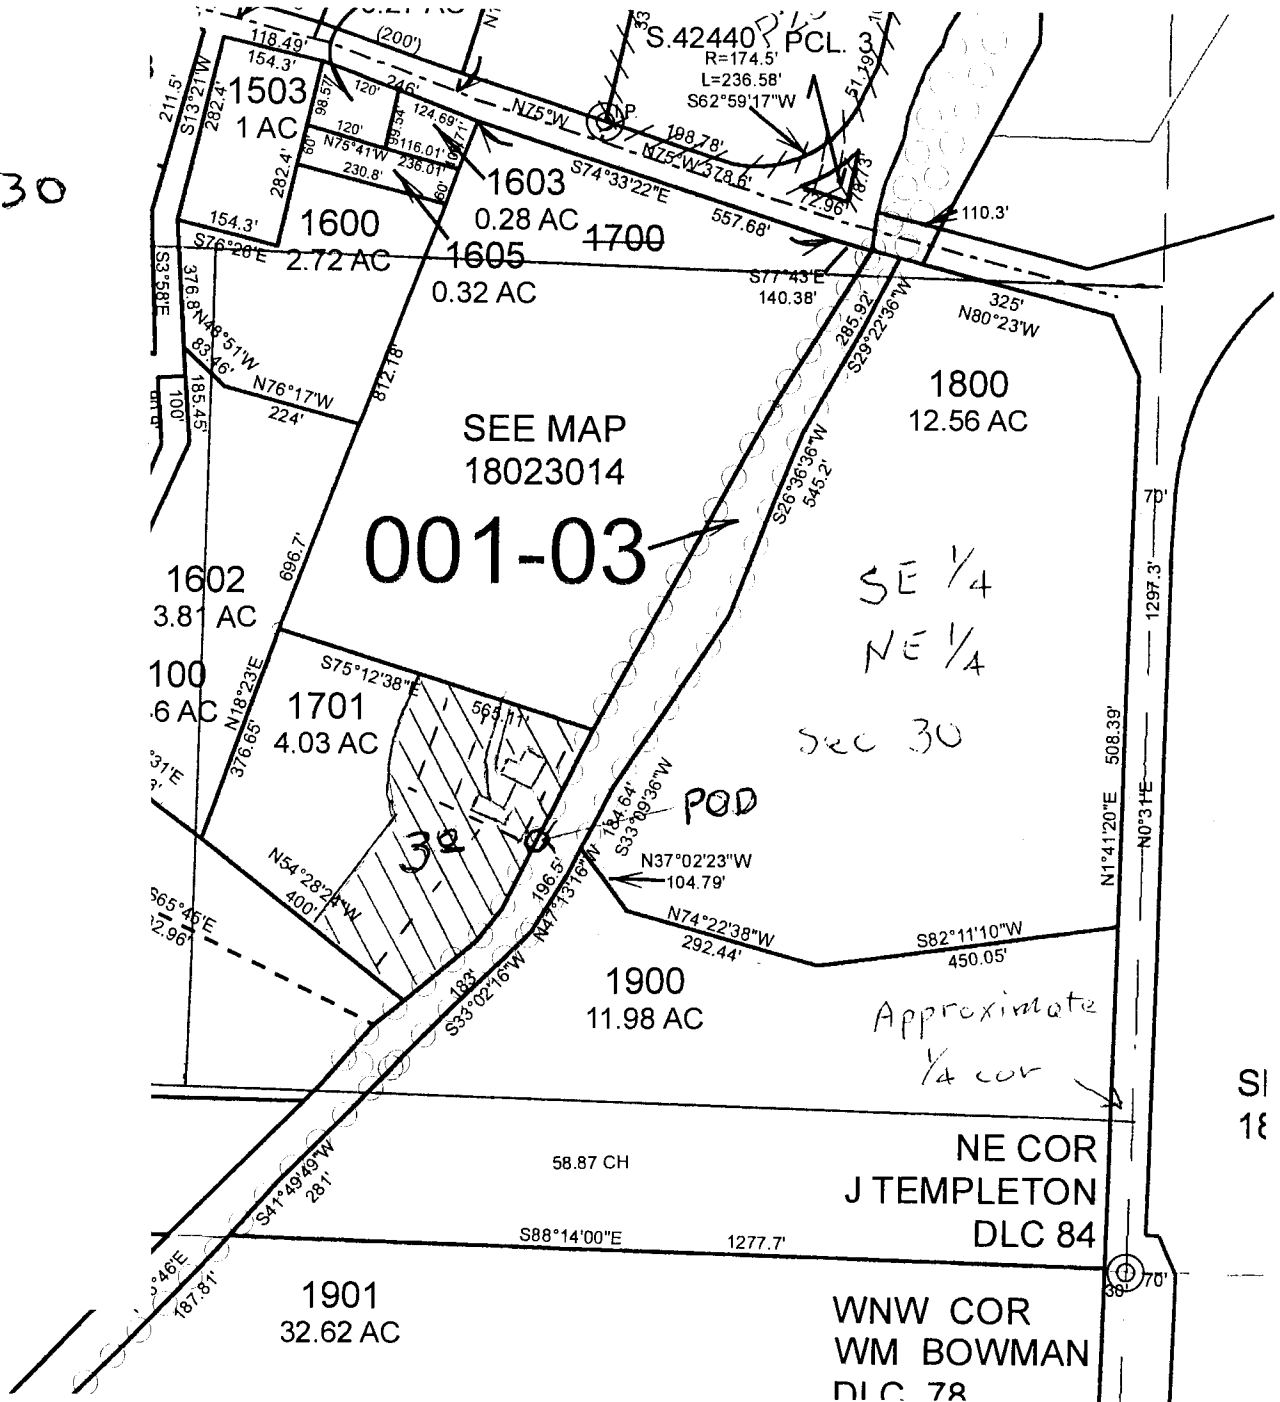

SI 18