


T.2-3S.R.4W.W.M.

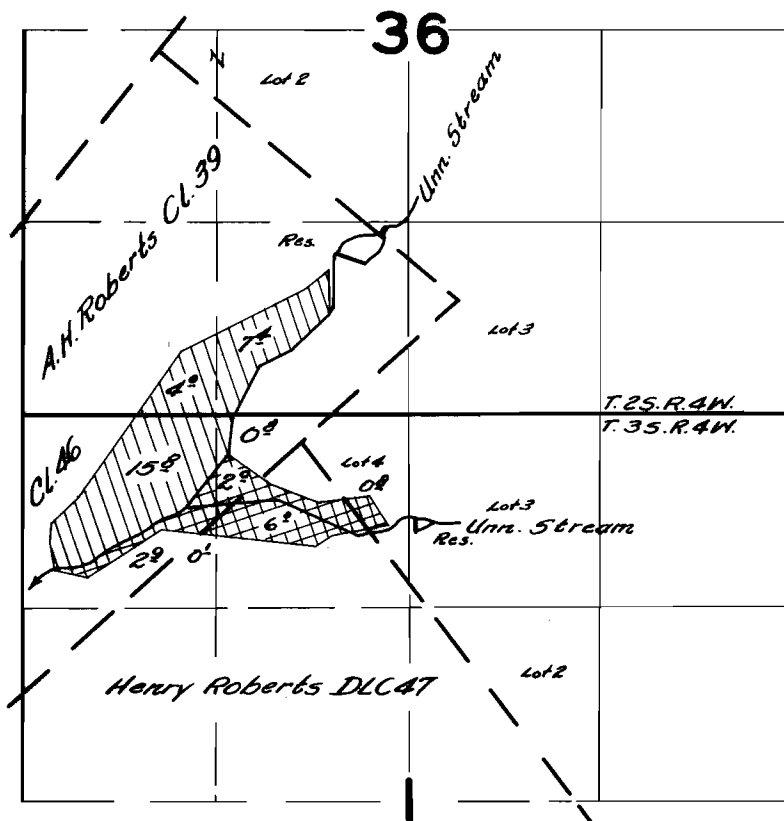

FINAL PROOF SURVEY UNDER

Application No. ~~27784~~ ^{R-27783} Permit No. ~~22425~~ ^{R-1517}
IN NAME OF

JOHN A. JOHNSON & SON

Surveyed March 16 1959, by C. D. Banteb