


T.38S.R.3W.W.M.

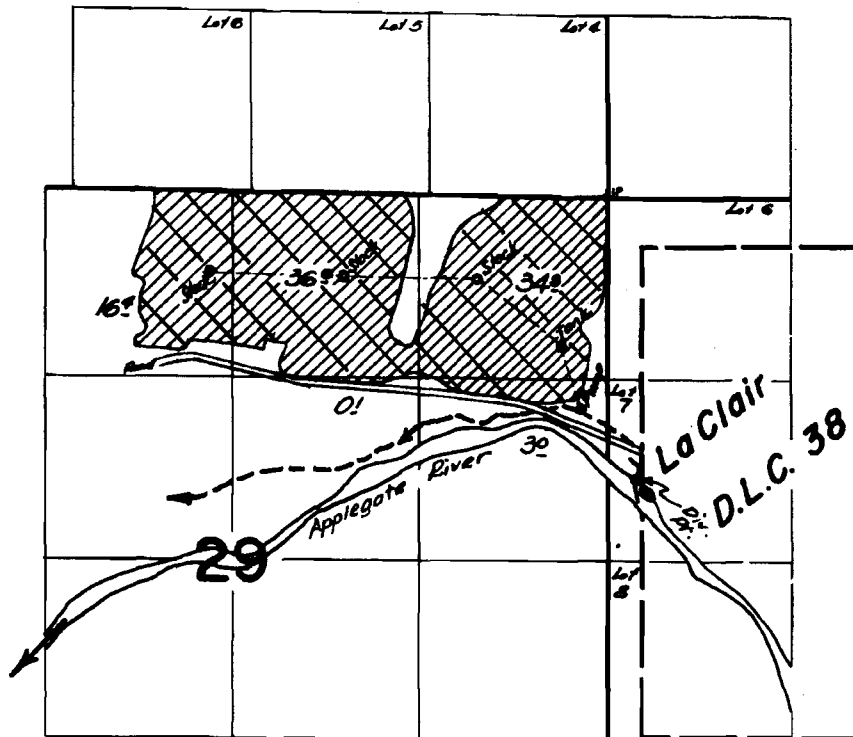


RECEIVED BY OWRD

FEB 06 2014

SALEM, OR

FINAL PROOF SURVEY
UNDER

 Existing
Primary
(Cert # 3242)

 Proposed
Supplemental

RECEIVED BY OWRD

JUN 26 2014

SALEM, OR

Application No. 22882... Permit No. 26693...
IN NAME OF

HARTS HATCHERY INC.

Surveyed June 6, 1963, by C.R. Baker...