


**Water Right Application for
George and Jayne Strader
T.26S. R.4W. W.M. SEC.16
Douglas County
1" = 400'**

RECEIVED BY OWRD

AUG 12 2013

SALEM, OR

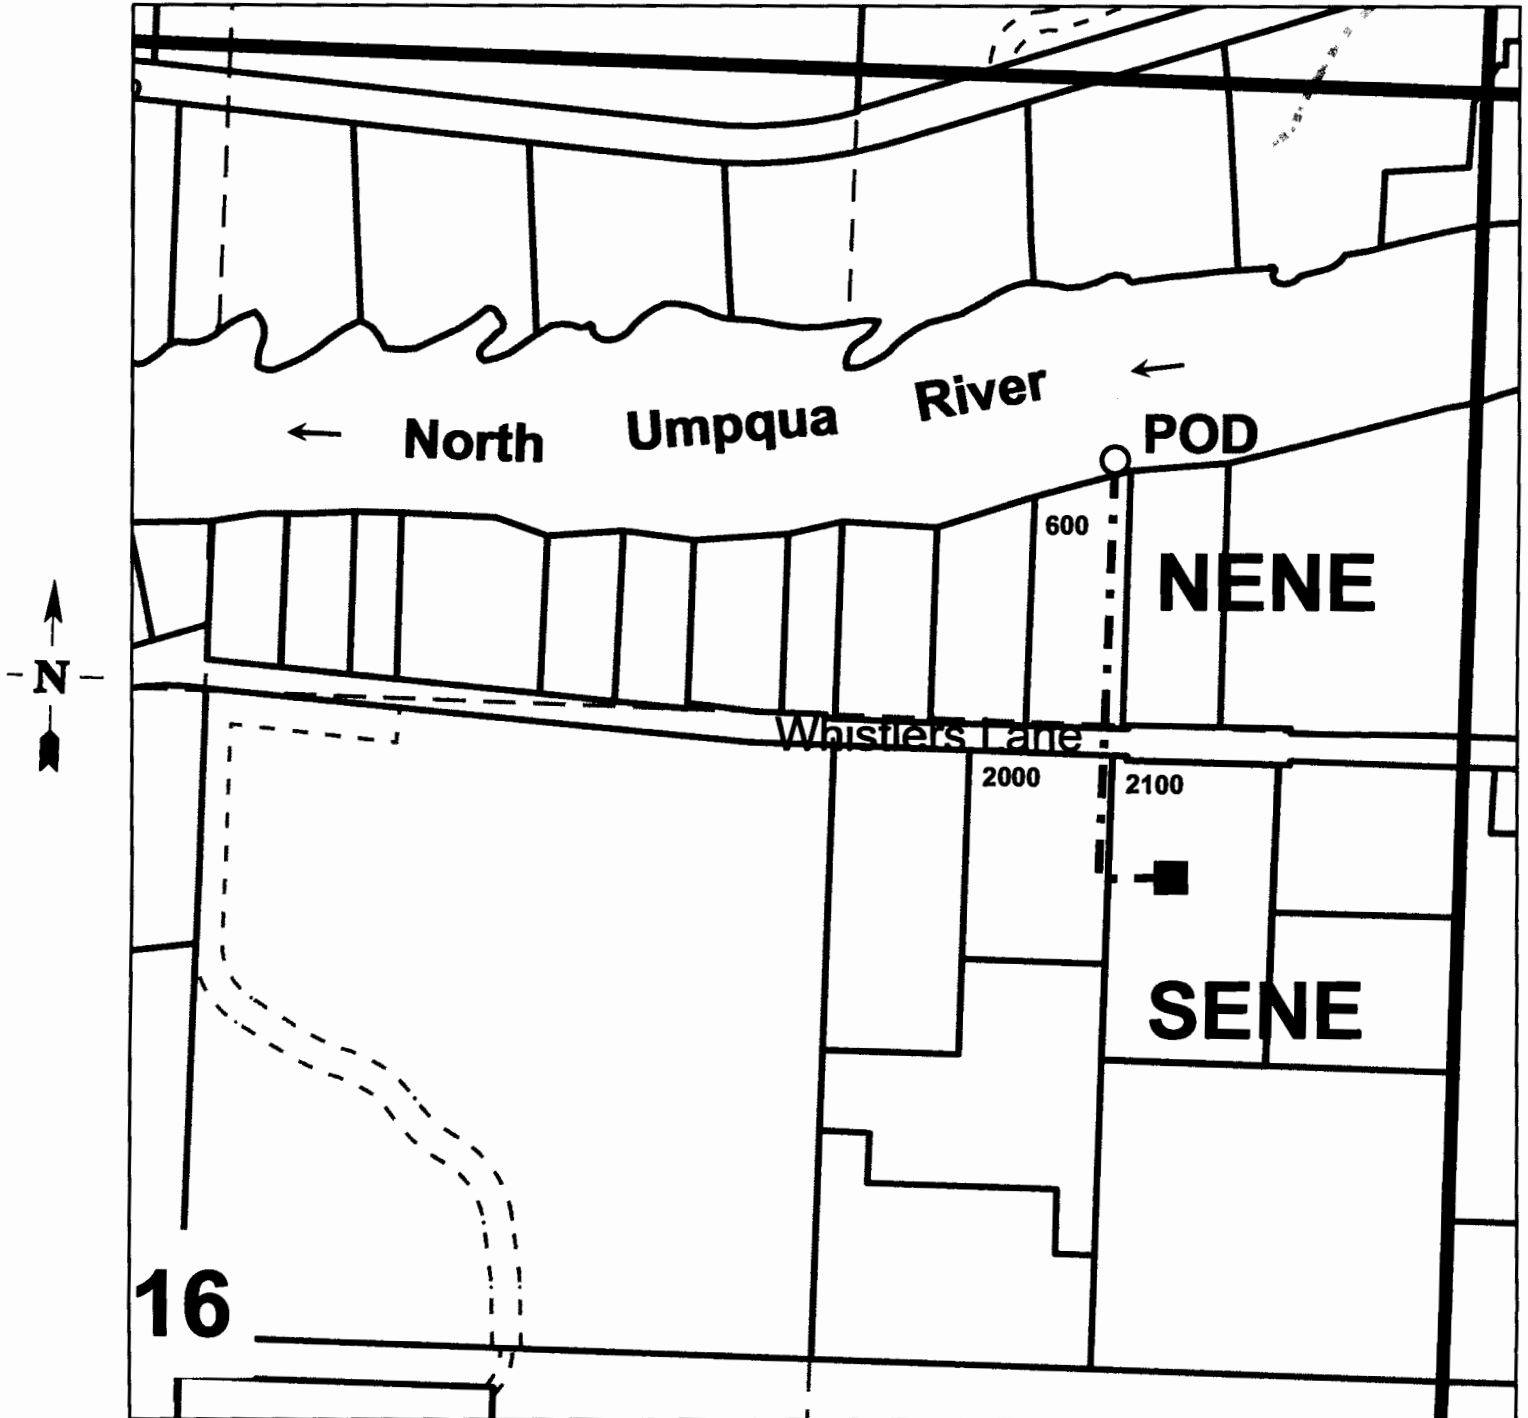

**Point of Diversion is 775 ft. south and 765 ft. west from the
northeast corner of Section 16.**

S-87926