


THIS MAP WAS PREPARED FOR ASSESSMENT PURPOSE ONLY

SECTION 9 T6N. R 5W W/M
COLUMBIA COUNTY
1" = 400'

6050900

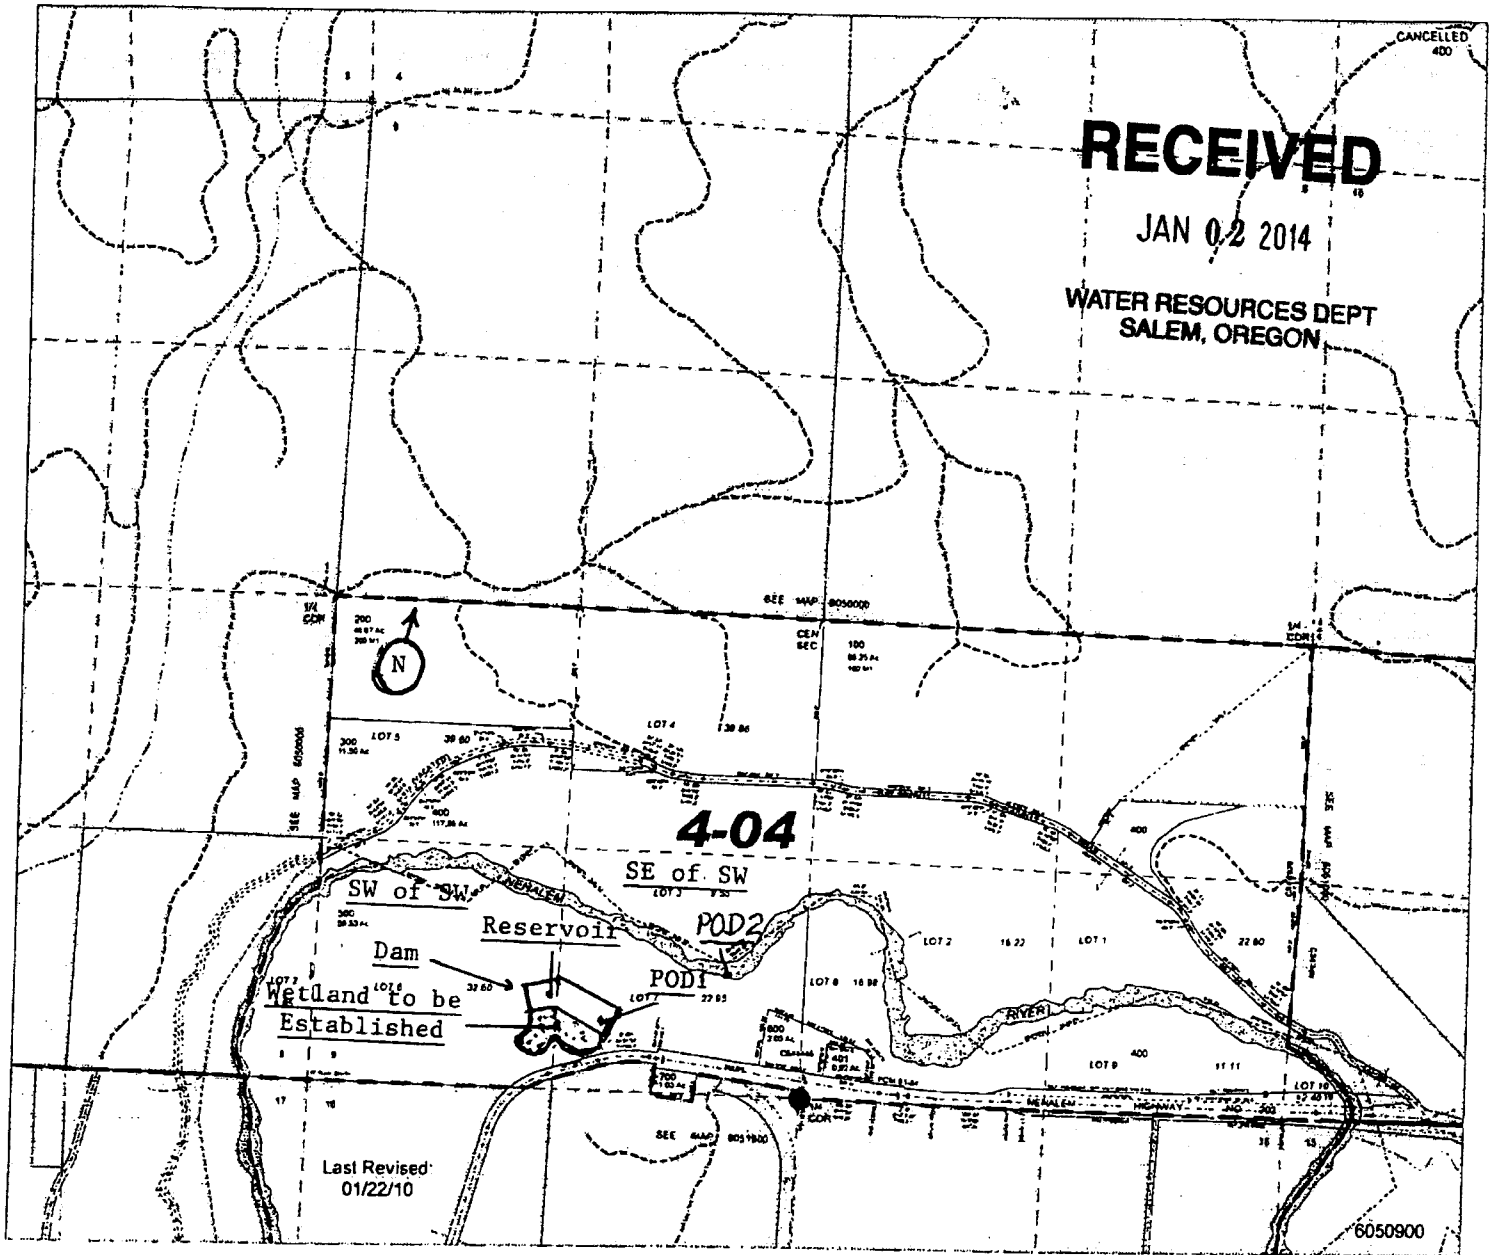

Location:
T6N/R5W/SECTION 9, Tax Lot 500
SW 1/4 of SW 1/4 & SE 1/4 of SW 1/4
Columbia County map # 4-04

~~POD Location:~~
250' North, 300' East *ofc*
of SW Corner of
SE 1/4 of SW 1/4 Sect. 9

Map Scale: 1" to 500'

POD 1: 220 ft. north, 1060 ft. west of S 1/4 corner *ofc*
 POD 2: 603 ft. north, 234 ft. west of S 1/4 corner *ofc*