

Platt Farms, LLC

RECEIVED

MAR 6 2015




1" = 1320'

Tax Lot:

200, 300, 100, 800, 900

WATER RESOURCES DEPT

Township 9 South, Range 4 West, Section 16, 17, 20, 21 SALEM, OREGON

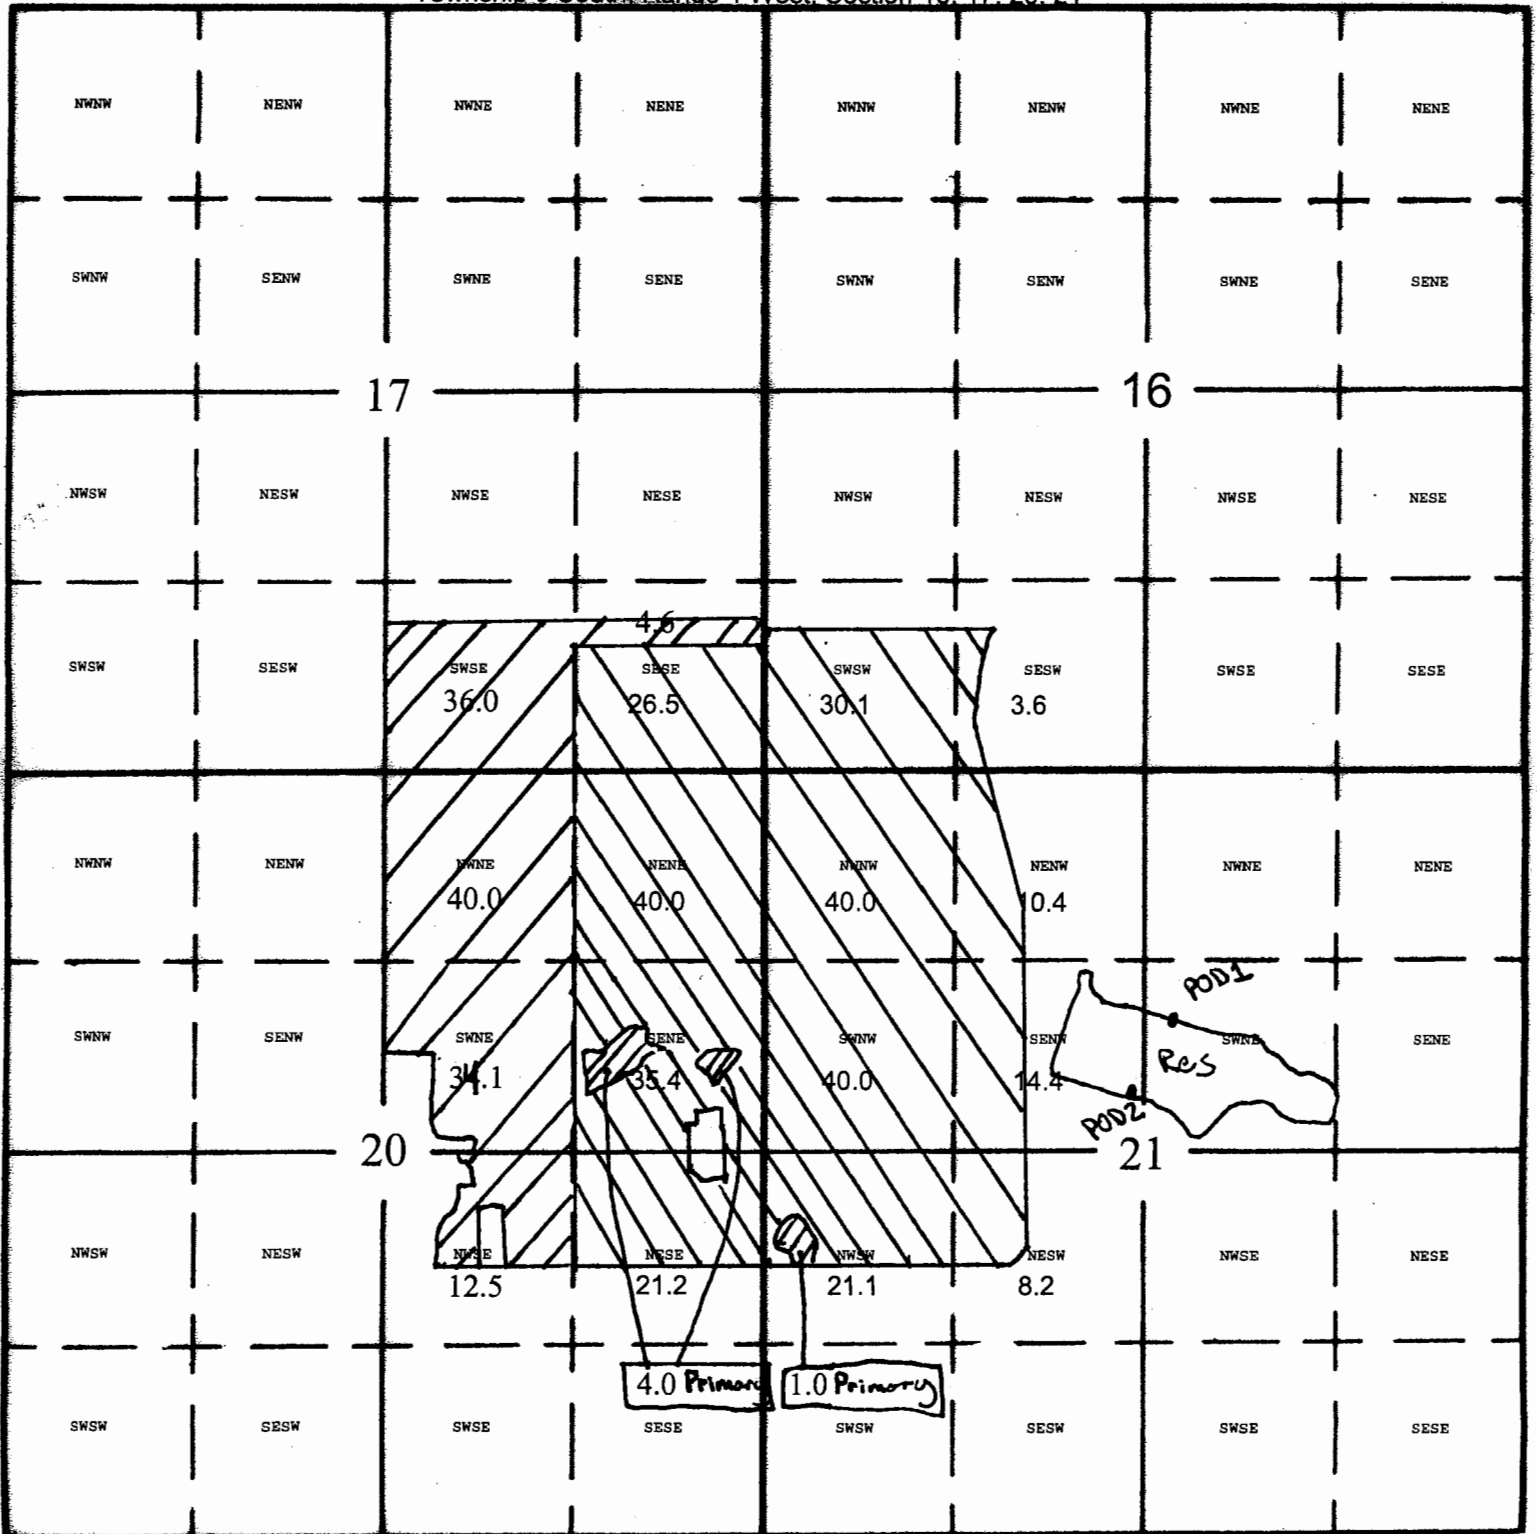

South

Jack Platt 2-28-15

Point of Diversion 1: 1660 feet south and 2850 feet east from NW Corner Section 21

Point of Diversion 2: 2190 feet south and 2585 feet east from NW Corner Section 21

S-88055